


EXHIBIT

VACATION OF COMPLETE ACCESS CONTROL ALONG NORTH LINE OF LOT 3, BLOCK A, WALKER ESTATES TO ALLOW FOR ONE ACCESS OPENING

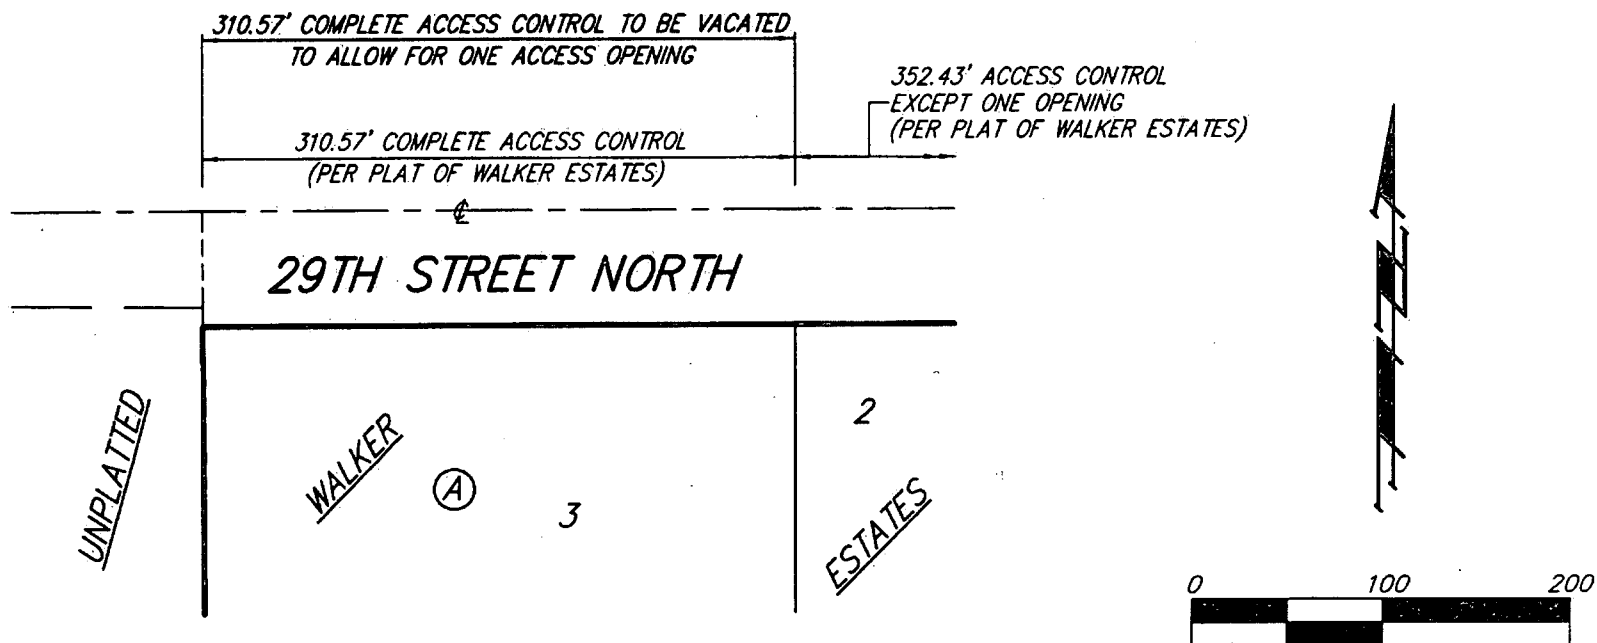

25 MAR 2016



BEFORE THE COUNTY COMMISSIONERS
OF SEDGWICK COUNTY, KANSAS

IN THE MATTER OF THE VACATION OF A)
PORTION OF PLATTED COMPLETE ACCESS)
CONTROL)

GENERALLY LOCATED WEST OF NORTH 183rd)
STREET WEST ON THE SOUTH SIDE OF WEST)
29TH STREET NORTH)

CASE NO. VAC2016-00014

VACATION ORDER

NOW on this 10th day of August, 2016, at 9:00 o'clock A.M., comes the petition filed by Donna Walker and Richard P. & Michelle M. Harris (owners), praying for the vacation of the following-described portion of platted complete access control, to-wit:

Vacate a portion of the platted complete access control over the north line of Lot 3, Block A, Walker Estates, an Addition to Sedgwick County, Kansas, to allow for one point of access opening onto West 29th Street North as permitted by the Sedgwick County Public Works Engineer.

WHEREUPON, it is shown that proper notice has been given by publication once at least 20 days prior to the date of hearing in the official county newspaper, the Wichita Eagle, such publication having occurred on March 28, 2016; and it is further shown that proper proof of such publication has been filed herein. The Board finds that such notice is in lawful form and that it conforms to K.S.A. 58-2613, and amendments thereto.

THEREAFTER, the Board, being duly advised in the premises, finds and determines that no private rights will be injured or endangered by such vacation; that the public will suffer no loss or inconvenience thereby; that no written objections hereto have been filed with the Sedgwick County Clerk; and that, in justice to the petitioner, the petition's prayer should be granted.

The Board further finds that the Metropolitan Area Planning Commission held a public hearing

on the 21st day of April 2016, and recommended that the vacation petition herein be approved.

THEREFORE, IT IS ORDERED BY THE BOARD OF COUNTY COMMISSIONERS OF SEDGWICK COUNTY, KANSAS, that the portion of the platted complete access control, hereinabove described be the same and is hereby vacated. It is further ordered that County Clerk shall send this Vacation Order to the Register of Deeds of Sedgwick County.

Commissioners present and voting were:

DAVID M. UNRUH
TIM R. NORTON
KARL PETERJOHN
RICHARD RANZAU
JAMES M. HOWELL

Dated this _____ day of _____, 2016.


BOARD OF COUNTY COMMISSIONERS
OF SEDGWICK COUNTY, KANSAS

ATTEST:

KELLY B. ARNOLD, County Clerk

JAMES M. HOWELL, Chairman
Commissioner, Fifth District

APPROVED AS TO FORM:

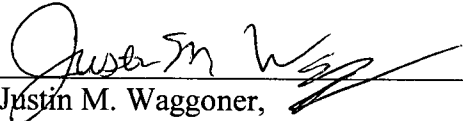

Justin M. Waggoner,
Assistant County Counselor