
PC202-3B

CROSS POINTE 2ND

AN ADDITION TO WICHITA, SEDGWICK COUNTY, KANSAS

NPC2016-77

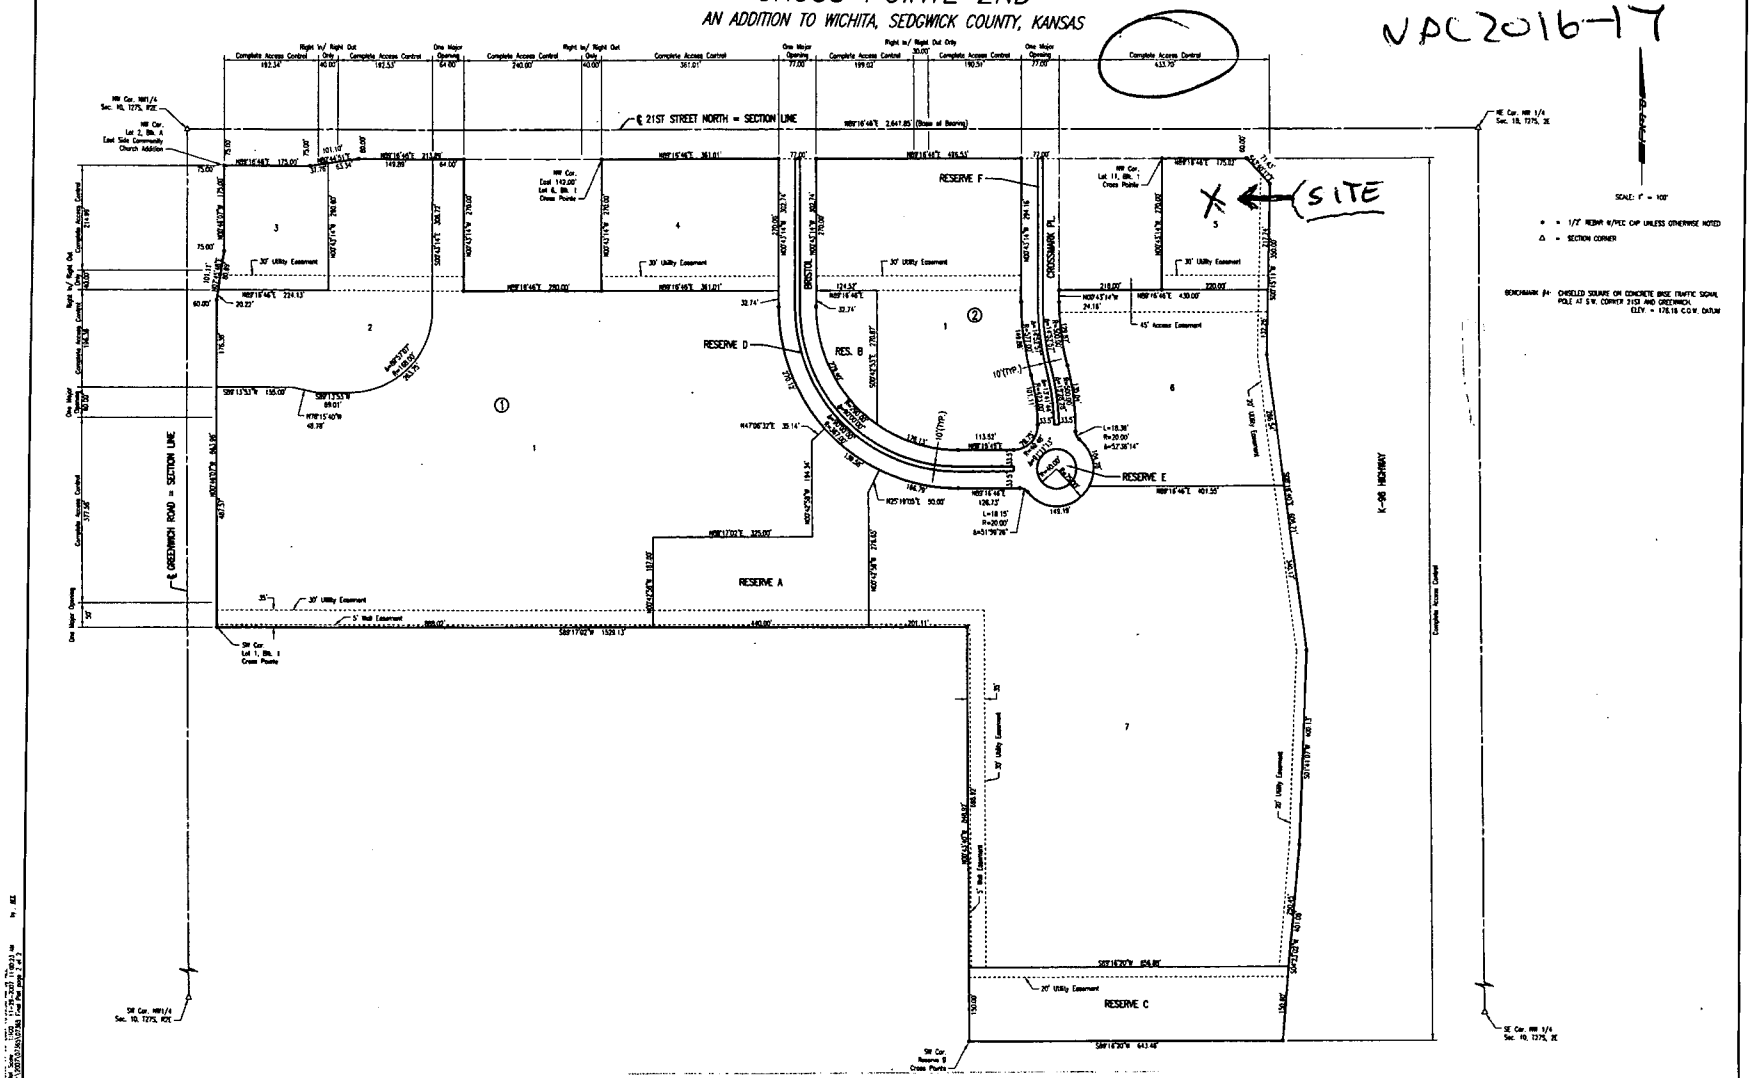

2 OF 2

PC202-3B

This digital plat record accurately reproduces in all details the original plat filed with the Sedgwick County Register of Deeds. Digitized under the supervision of Register of Deeds Bill Meek by Sedgwick County Geographic Information Systems.

Bill Meek, Register of Deeds
(Signature/ facsimile of original signature)