



Wichita-Sedgwick County Metropolitan Area Planning Department

November 14, 2016

MKEC Engineering, Inc.
Attn: Brian Lindebak
411 N. Webb Rd
Wichita, KS 67208


Ref: VAC2016-00025 – Request to vacate portions of platted setbacks, utility easements and the platlor's text on property generally located at the southeast corner of East 21st Street North and North Rock Road (District II)

Dear Mr. Lindebak:

At its regular meeting on Tuesday, November 1, 2016, the Wichita City Council considered the above-referenced request. The action of the City Council was to **APPROVE** subject to the recommendation by the MAPC.

If you have any questions about this matter, please call 268-4421.

Sincerely,

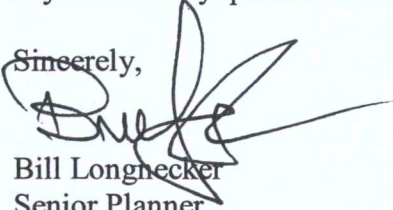


Bill Longnecker
Senior Planner

BL:klw

cc: BF Wichita LLC, Amy Liebau, 150 N Market St, Wichita KS 67202

VAC 2016-25

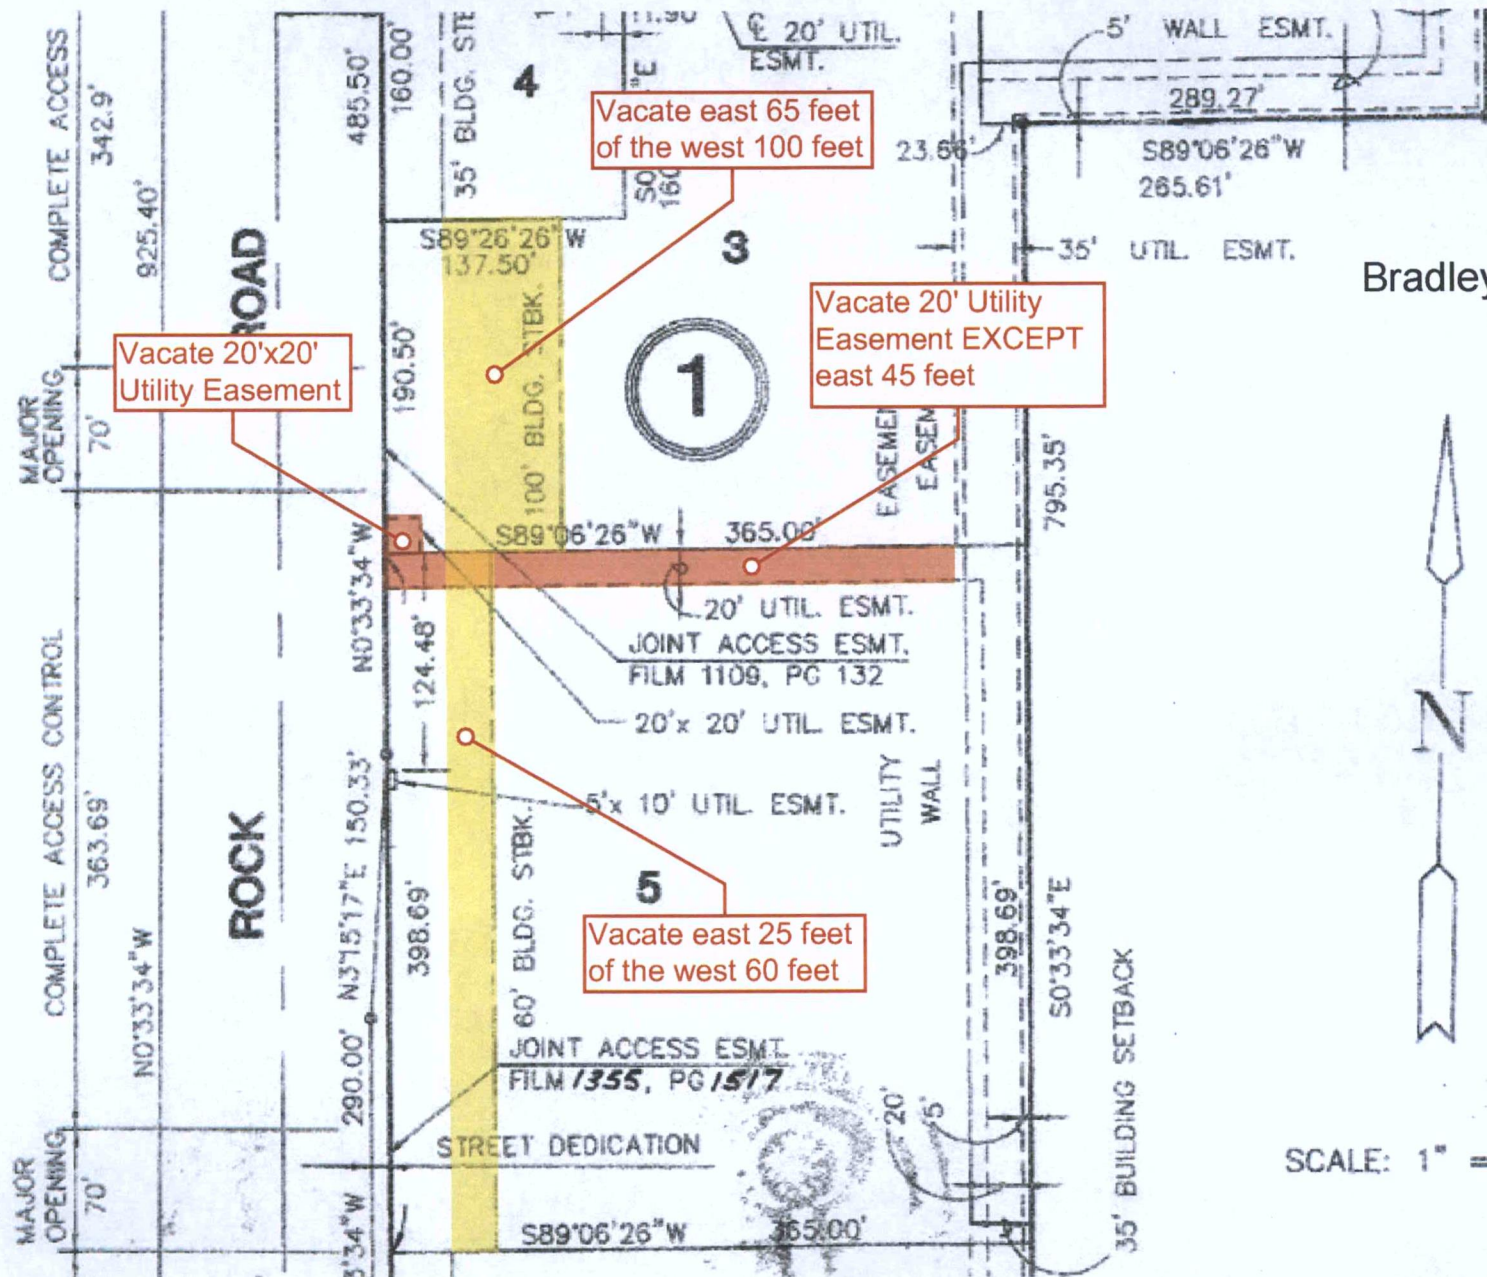

Bradley Fair Addition



SCALE: 1" = 100'