



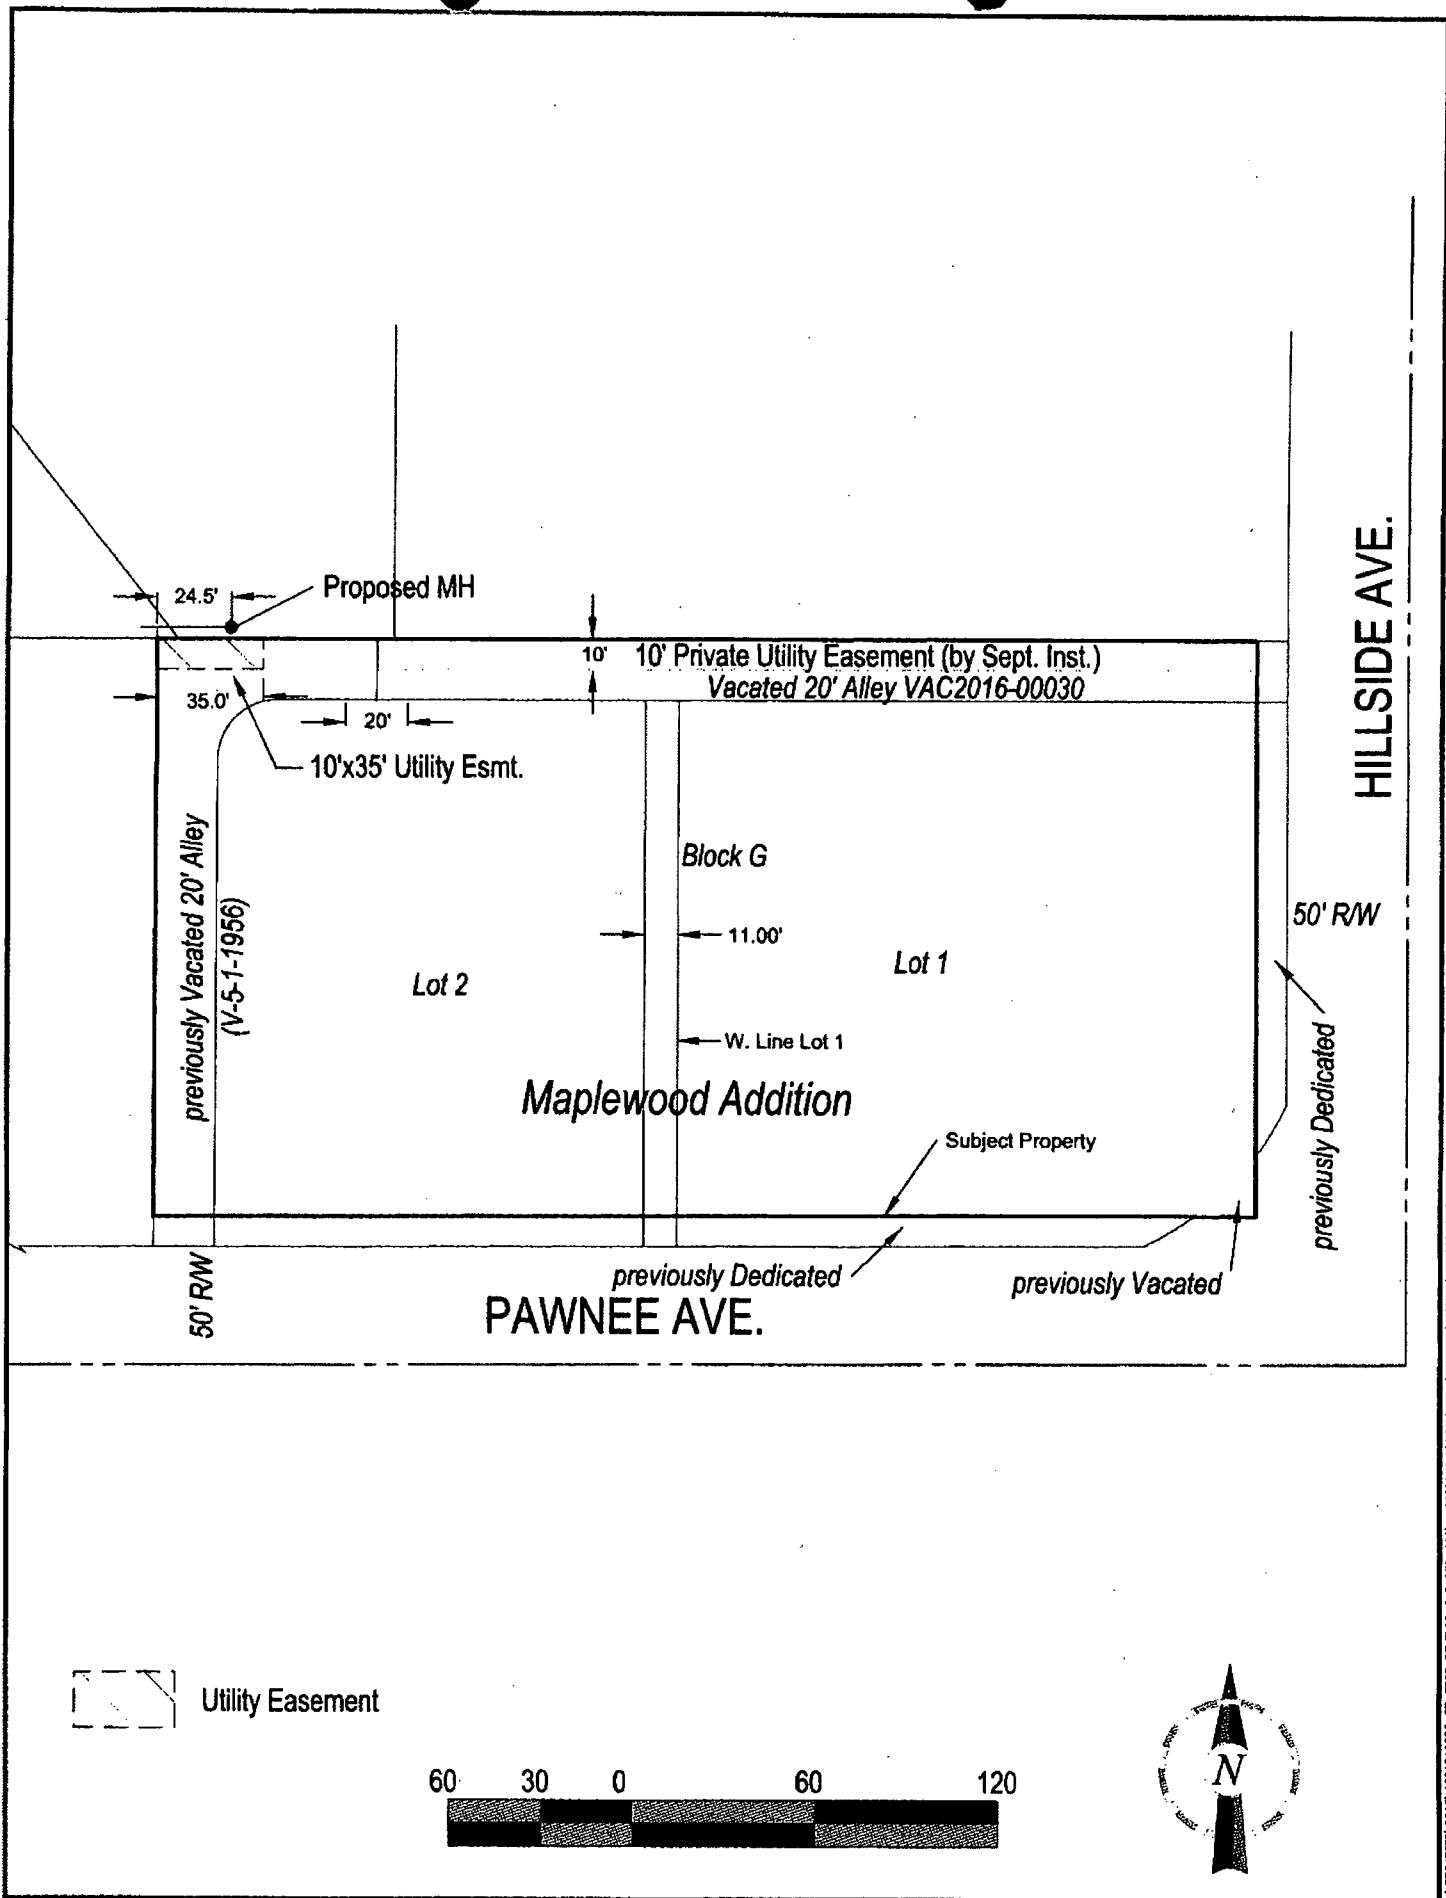

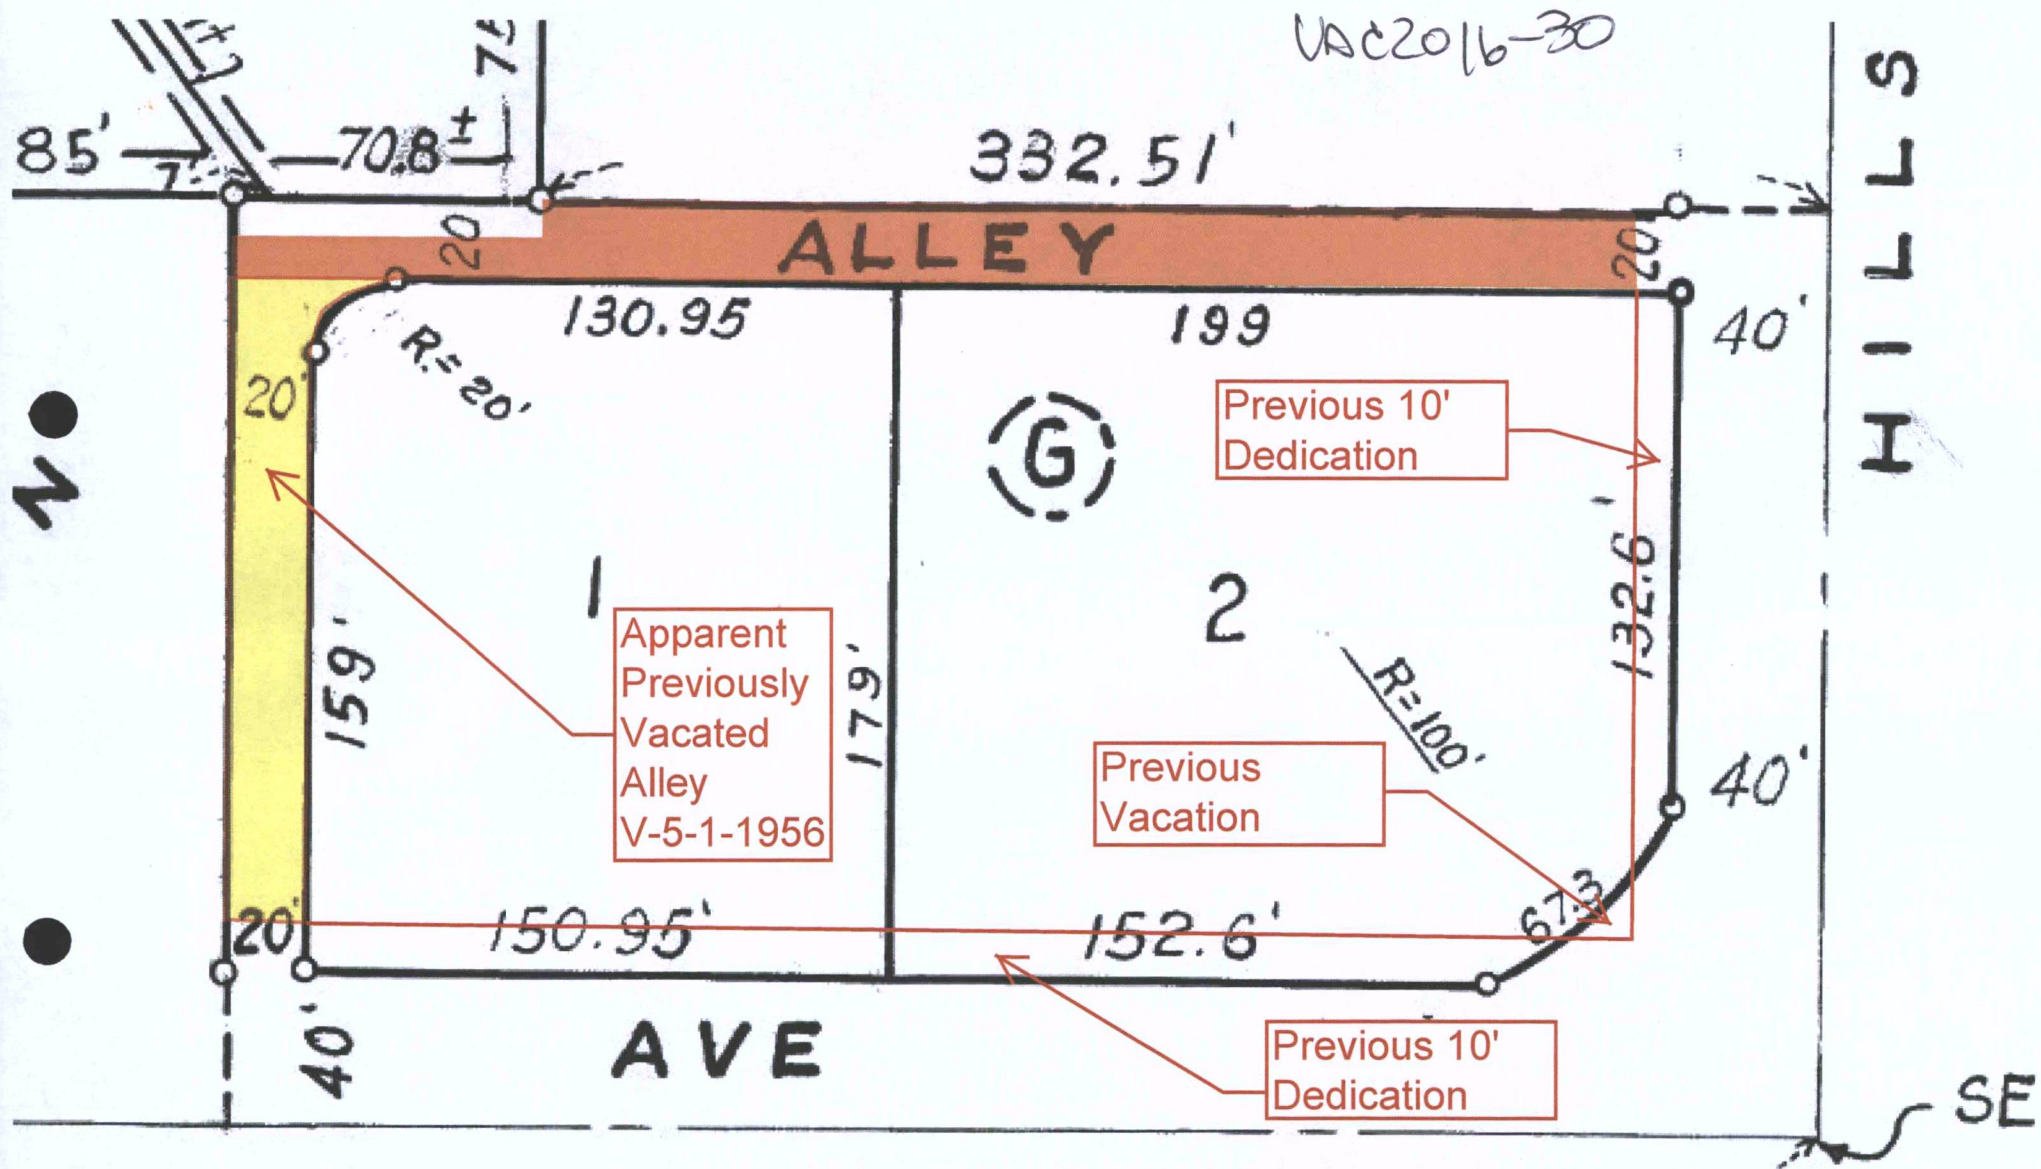

Maplewood Addition, an addition to Sedgwick County, Kansas