



Wichita-Sedgwick County Metropolitan Area Planning Department

CORRECTED

February 22, 2017

~~February 13, 2017~~

MKEC Engineering Inc.
Attn: Brian Lindebak
411 N. Webb Rd.
Wichita, KS 67206


Ref: VAC2016-00041 - City request to vacate portions of a platted setback, platted drainage easement and platted utility easement on property generally located east of Rock Road, north of 21st Street North on the east side of Tallgrass Street.

Dear Mr. Lindebak:

At its regular meeting on Tuesday, January 3, 2017, the Wichita City Council considered the above-referenced request. The action of the City Council was to **APPROVE** subject to the recommendation by the MAPC.


If you have any questions about this matter, please call 268-4421.

Sincerely,

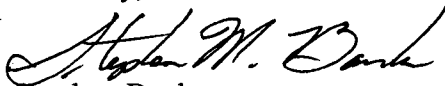
Stephen Banks
Senior Planner

SB:klw

cc: Perfection Builders LLC, c/o Scott Lehner, 11828 W Central Av, Ste 112, Wichita KS 67212

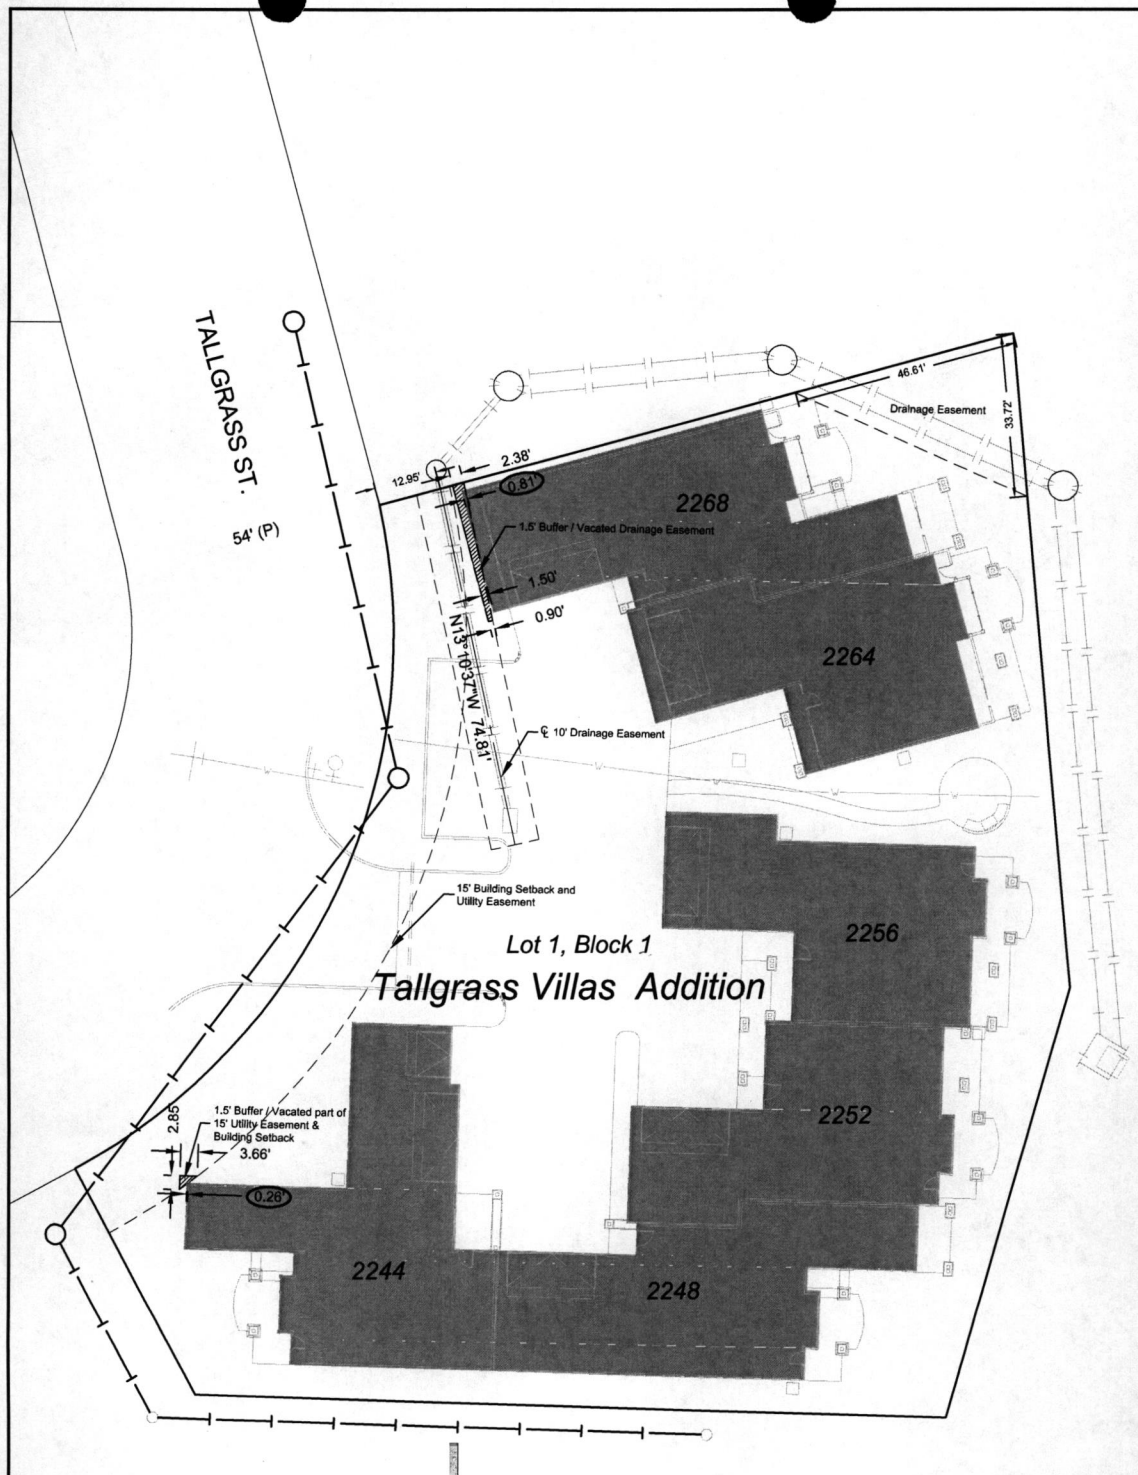

VAC2016-41

©2016
MKEC Engineering
All Rights Reserved
www.mkec.com
These drawings and their contents,
including, but not limited to, all
concepts, designs, & ideas are the
exclusive property of MKEC
Engineering (MKEC), and may not be
used or reproduced in any way without
the express consent of MKEC.



VACATION EXHIBIT
VAC2016-000
TALLGRASS VILLAS ADDITION

PROJECT NO. 1301010787

DATE: AUGUST 2016

SHEET NO.

DRAWN BY: JGD

DESIGNED BY: BDL

APPROVED BY: BDL

1 OF 1

J:\PROJECTS\2016\1301010787_PREFERENCE - TALLGRASS VILLAS - CIVIL\DWG\MASE_13010787.DWG