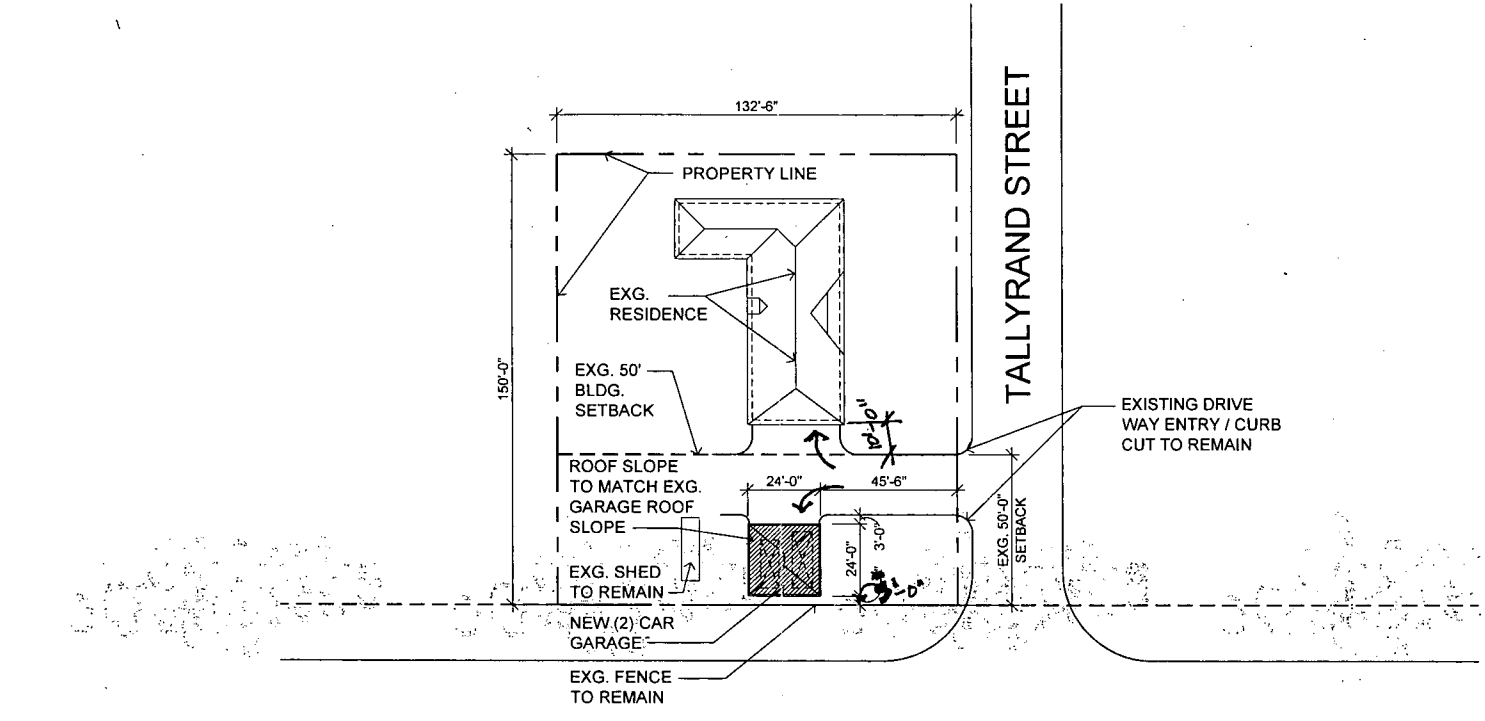


site concept plan

0 20'

martinez addition

501 N TALLYRAND

10.10.16