


BENCHMARK:
 "C" ON HUEGUARD OF R.C.B.C.
 75' W. OF SE COR., SE 1/4, SEC. 28.
 TWP. 26-S, R-1-W
 ELEV. = 144.22 CITY DATUM (1331.62 M.S.L.)

604 STEP BENCH IN H.P. 15' N. &
 40' E. OF THE INTERSECTION OF 34TH ST. N
 AND EISENHOWER
 ELEV. = 144.00 CITY DATUM (1331.40 M.S.L.)

VAC2016-51

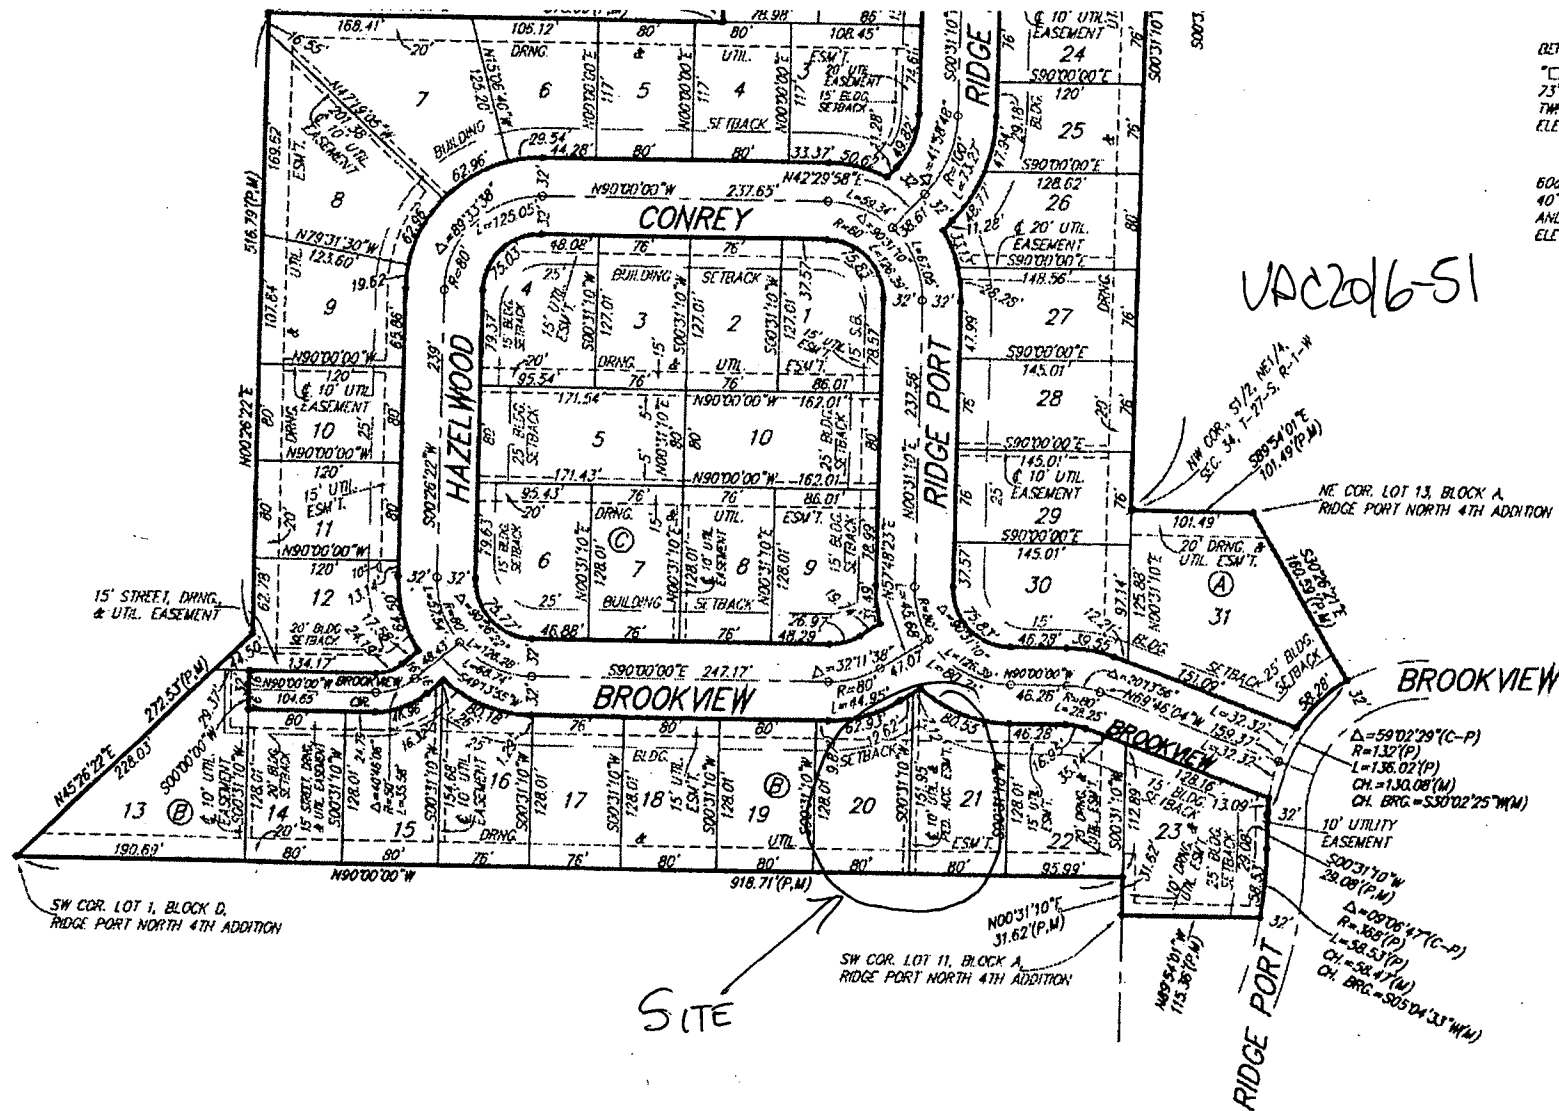

NOTE:
 A master grading plan for drainage has been developed for this subdivision and is on file with the City of Wichita, Kansas. All drainage easements, rights-of-way, or reserves shall remain at established grades or as modified with the approval of the City Engineer of the City of Wichita, Kansas. No obstructions which impede the flow of this drainage system shall be allowed.

Ridge Port North 5th Add