VAC2017-00037 Plat Excerpt

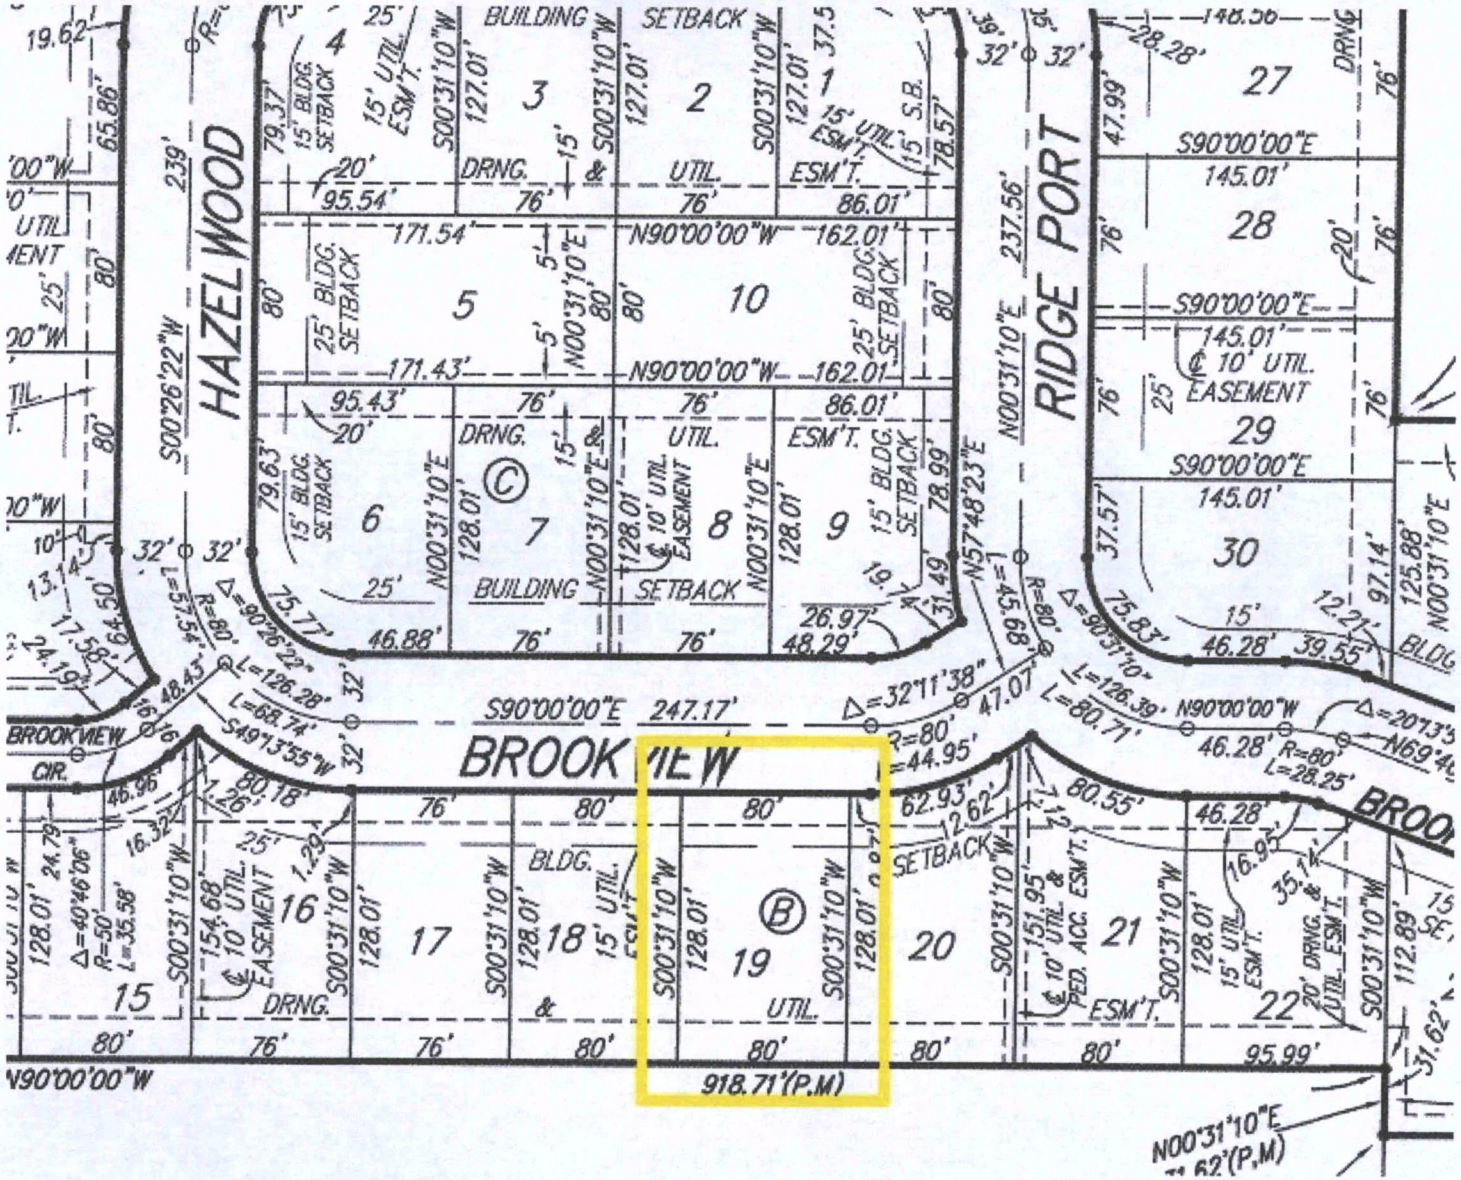
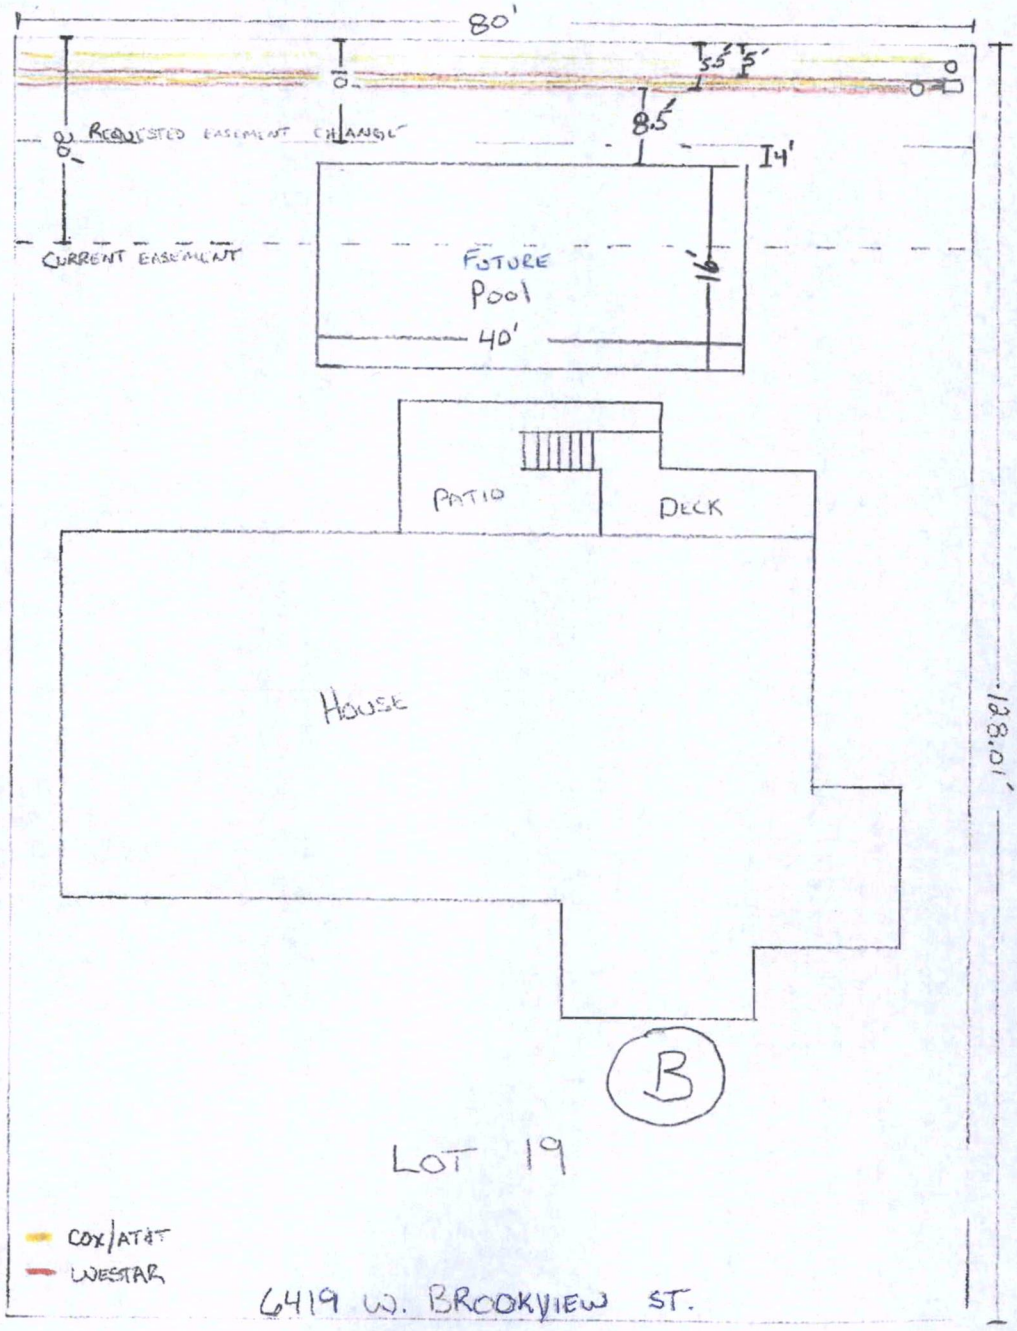
VAC2017-00037 Site Plan