



EXHIBIT

PARTIAL SETBACK VACATION IN LOT 1, BLOCK 1, KUHLMAN ADDITION, WICHITA, SEDGWICK COUNTY, KANSAS

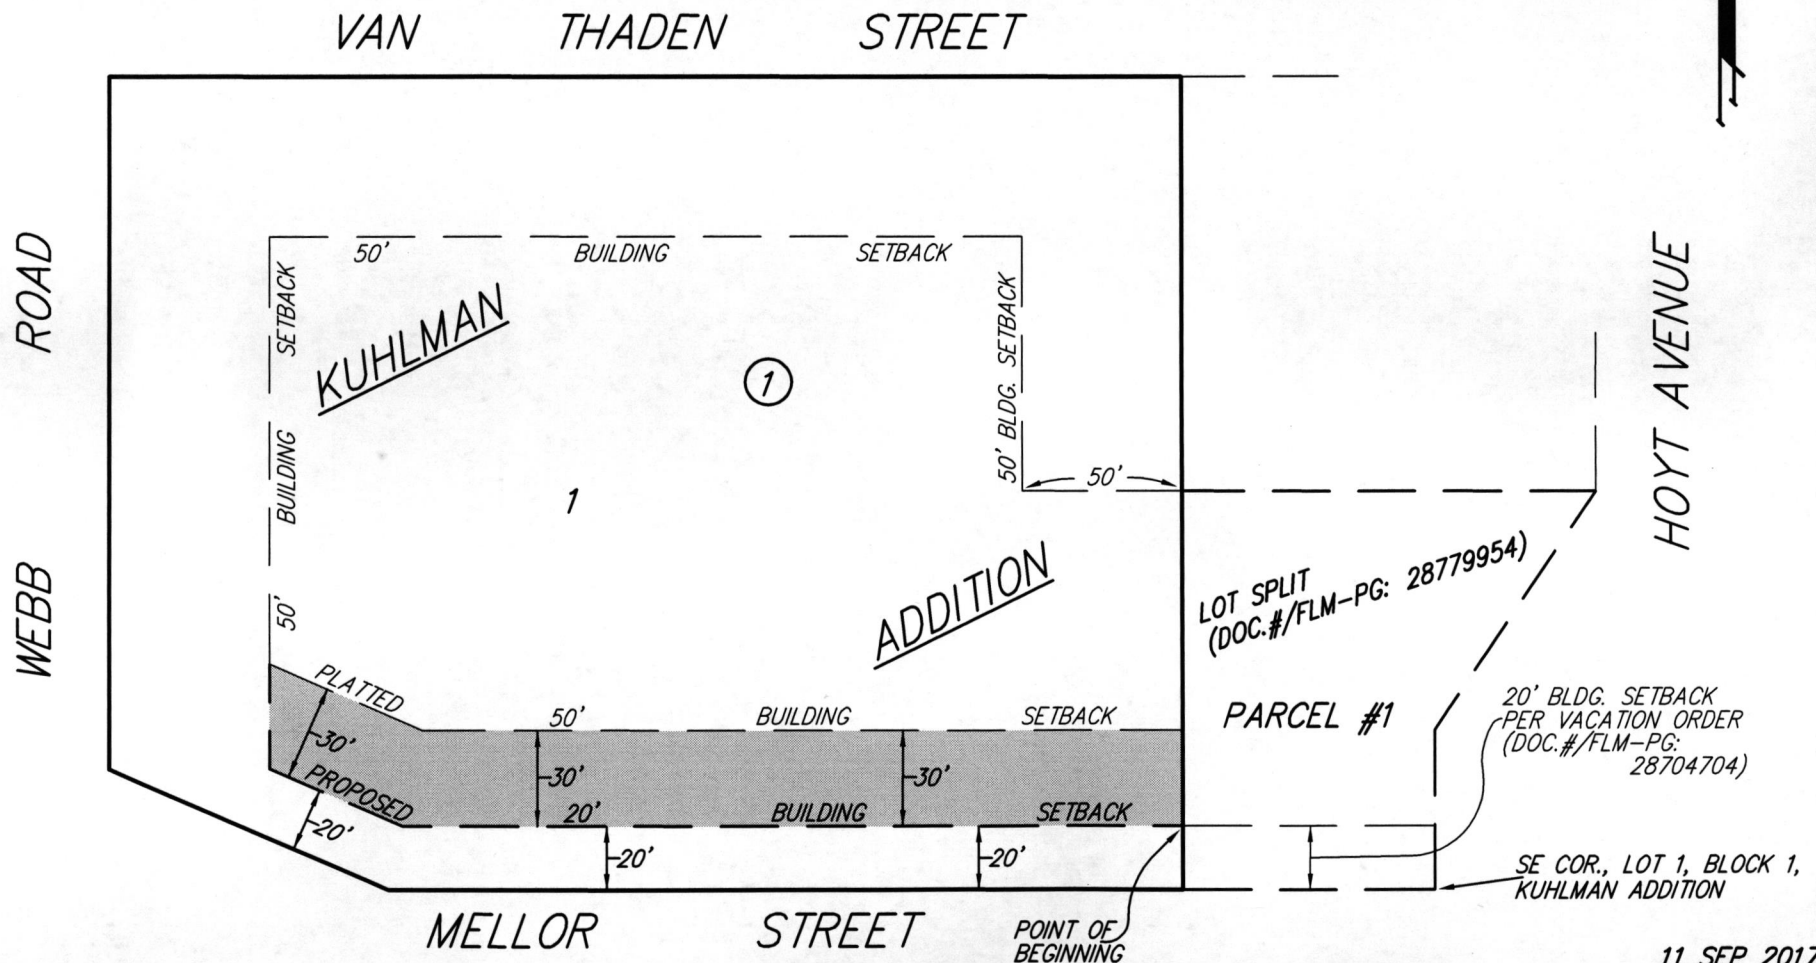

INDICATES AREA OF LEGAL DESCRIPTION
FOR PARTIAL VACATION OF PLATTED
BUILDING SETBACK

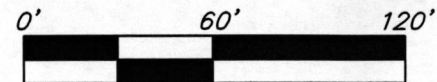

11 SEP 2017

