


SITE PLAN

LOT 63, BLOCK 2, KRUG SOUTH ADD. TO WICHITA, KS.

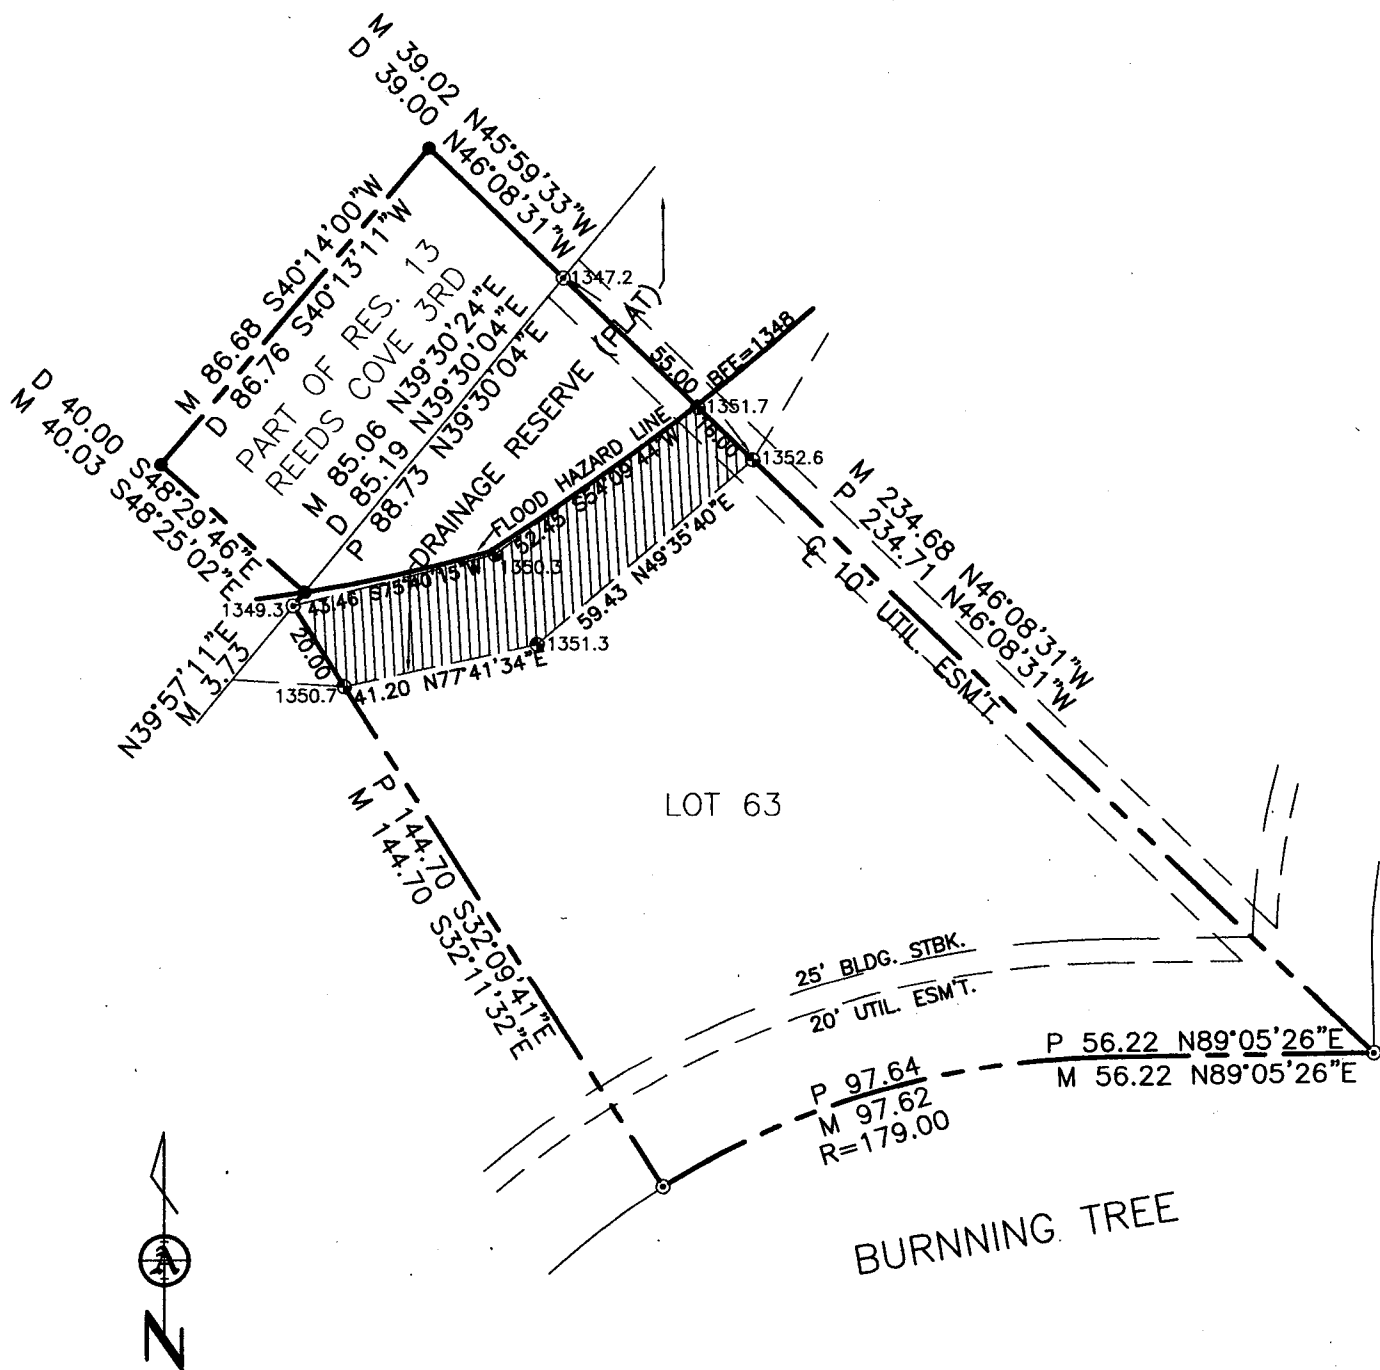

SCALE 1"=40'

- ⊕ – "LS-780" capped rebar set
- – "BAUGHMAN" capped rebar found
- ⊙ – "MKEC" capped rebar found
- M – measured distance
- P – plat distance
- D – deed distance

W.O. #38250
Page 2 of 2



**ARMSTRONG
LAND SURVEY, P.A.**

1601 E. HARRY
WICHITA, KS 67211
PH. (316) 263-0082
mstronq.kscoxmail.com