



FILE COPY

Wichita-Sedgwick County Metropolitan Area Planning Department

March 11, 2003

Joe Hoover
USD 259
3850 N. Hydraulic
Wichita, KS 67219

Re: ³⁻~~BZA2002-00048~~⁰⁴: Zoning Adjustment to allow parking in the front setback on property zoned "SF-5" Single-Family Residential.

Legal Description: A part of Lot 1, Block 1, South High School Addition further described as: beginning at the NE corner of said Lot 1, thence S00°09'E 101.12 feet; thence S00°09'W 409.35 feet to a point on a curve having a radius of 2729.40 feet and a central angle of 10°07'08" with a chord bearing of N69°34'30"W and an arc length of 482.04 feet; thence N00°95'39"E 674.11 feet; thence S89°58'48"E 435.29 feet to the point of beginning. Located south of 35th St. S. and west of Gold (3605 S. Gold).

Dear Mr. Hoover:

We have reviewed your request for a Zoning Adjustment to allow parking in the front setback on the aforementioned property. You state in your application that you plan to use these areas for required off-street parking in conjunction with the construction and relocation of Enterprise Elementary School and that you desire to park in the front setback no closer than 8 feet from the property line in order to preserve as much land as possible for use as a playground and athletic fields.

Sec. V-I.2.1. of the Unified Zoning Code allows an adjustment to permit parking in residential districts to be located within required front and street side setbacks, but in no case closer to the property line than 8 feet, when the conditions required by Sec. V-I.6. of the Code are met. We find that allowance of parking within the front setback no closer than 8 feet from the property line meets the four conditions required by Section V-1.6 of the Unified Zoning Code as set out below:

- 1) Impact on safety and convenience of vehicular and pedestrian circulation: Sufficient open space between the parking area and the property line will remain to prevent vehicles from encroaching upon the sidewalk; therefore, the safety and convenience of vehicular and pedestrian circulation should not be negatively impacted.
- 2) Impact on existing uses in surrounding areas: There should not be a negative impact on the existing uses in the surrounding areas as a result of parking within the setback as no residential front yards are located adjacent to the parking areas, and the parking areas will be appropriately screened and buffered from adjacent residential uses.

City Hall • 10th Floor • 455 North Main • Wichita, Kansas 67202-1688

T 316.268.4421 F 316.268.4390

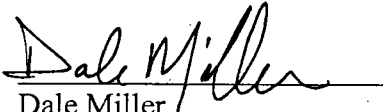
www.wichitagov.org

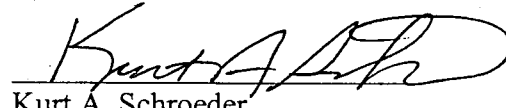
- 3) Compatibility with existing or permitted uses on abutting sites: Schools and associated accessory uses such as parking are permitted in residential zoning districts, and the allowance of parking within the setback should not compromise existing or permitted uses on abutting sites due to the minor nature of the encroachment of the parking area into the setbacks and the provision of landscaping for the parking lot.
- 4) Effect on public health, safety or welfare: There will be no encroachment into public utility easements or right-of-way; therefore, there should not be a negative impact on the public health, safety or welfare nor will properties or improvements in the vicinity be materially injured.

Our signatures below indicate that a Zoning Adjustment to allow parking in the front setback, but no closer than 8 feet from the property line, is hereby granted subject to the following conditions:

- 1) The parking lots shall be developed in accordance with the approved site plans.
- 2) All parking areas shall be paved and marked.
- 3) If the Zoning Administrator finds that there is a violation of any of the conditions of the Zoning Adjustment, the Zoning Administrator, in addition to enforcing the other remedies set forth in Article VIII of the Unified Zoning Code, may, with the concurrence of the Planning Director, declare that the Zoning Adjustment is null and void.

The zoning adjustment sign may now be removed from the property.


Dale Miller
Acting Planning Director


Kurt A. Schroeder
Superintendent of Central Inspection

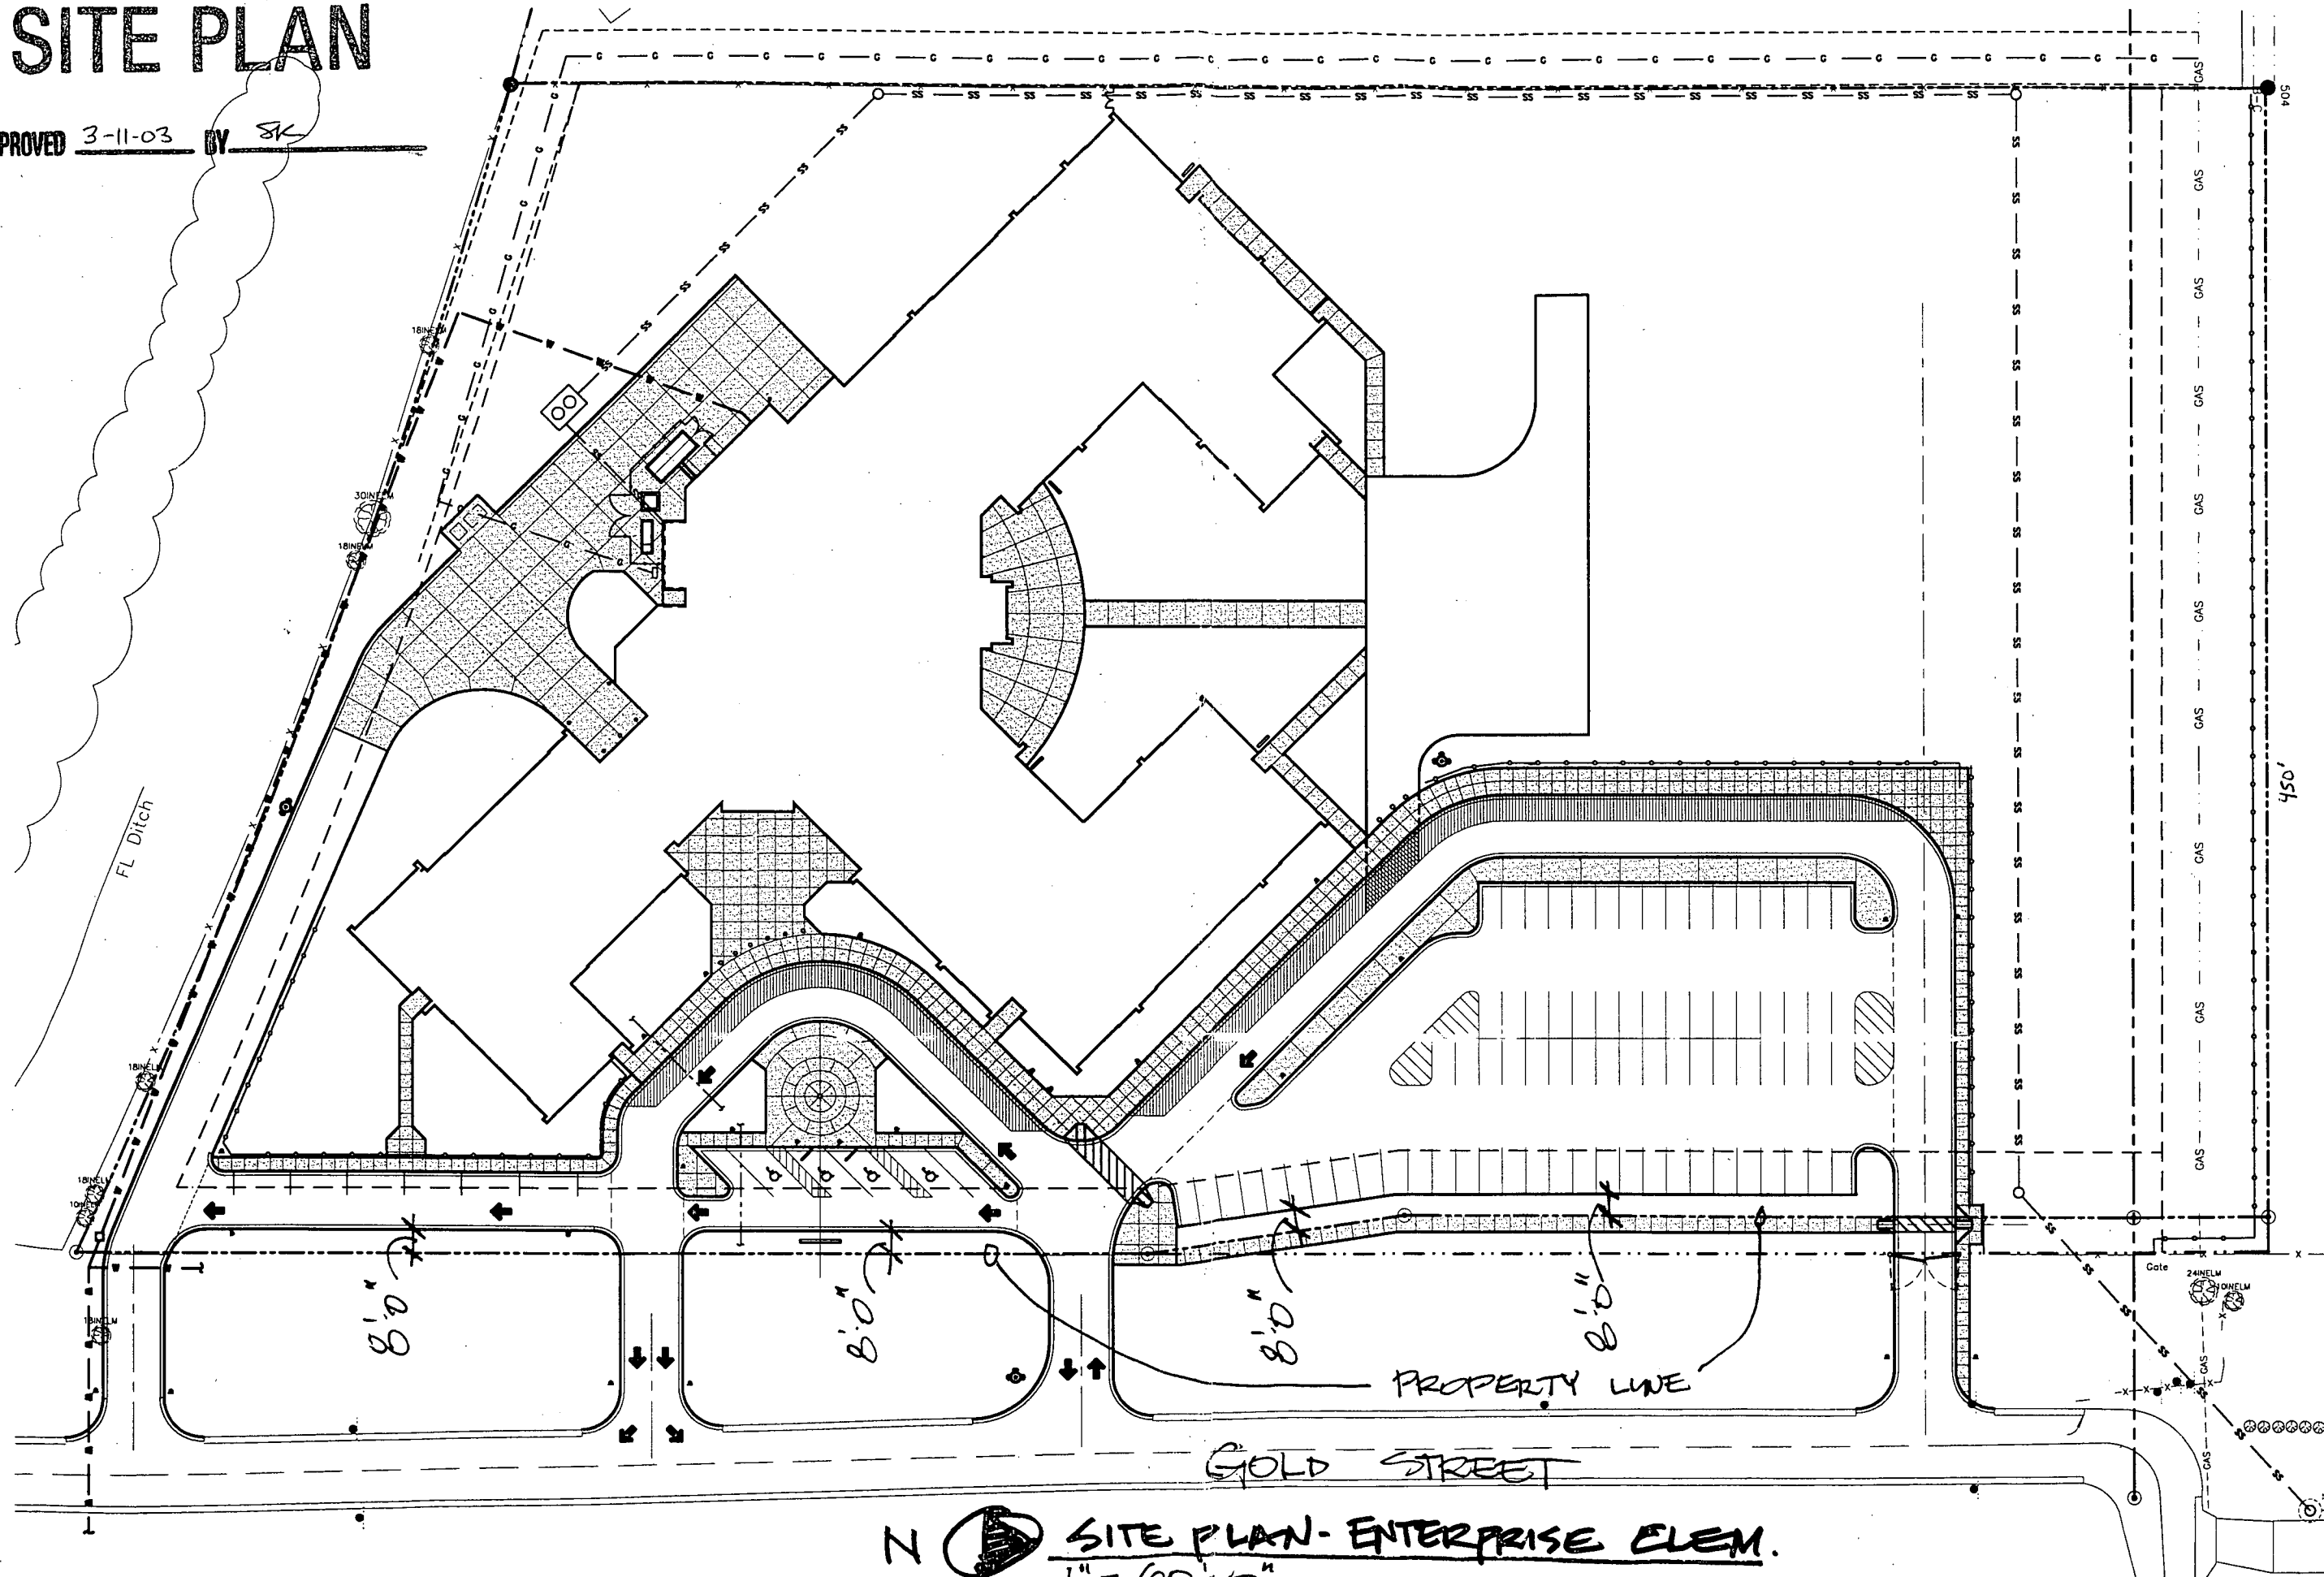
Enclosure

cc: Kurt Schroeder, Office of Central Inspection
Paul Hays, Office of Central Inspection
Randy Sparkman, Office of Central Inspection
J.R. Cox, Office of Central Inspection

BZA2003-00004

SITE PLAN

APPROVED 3-11-03 BY SK



N  SITE PLAN- ENTERPRISE ELEM.
1" = 60' 0"