


HYDRAULIC

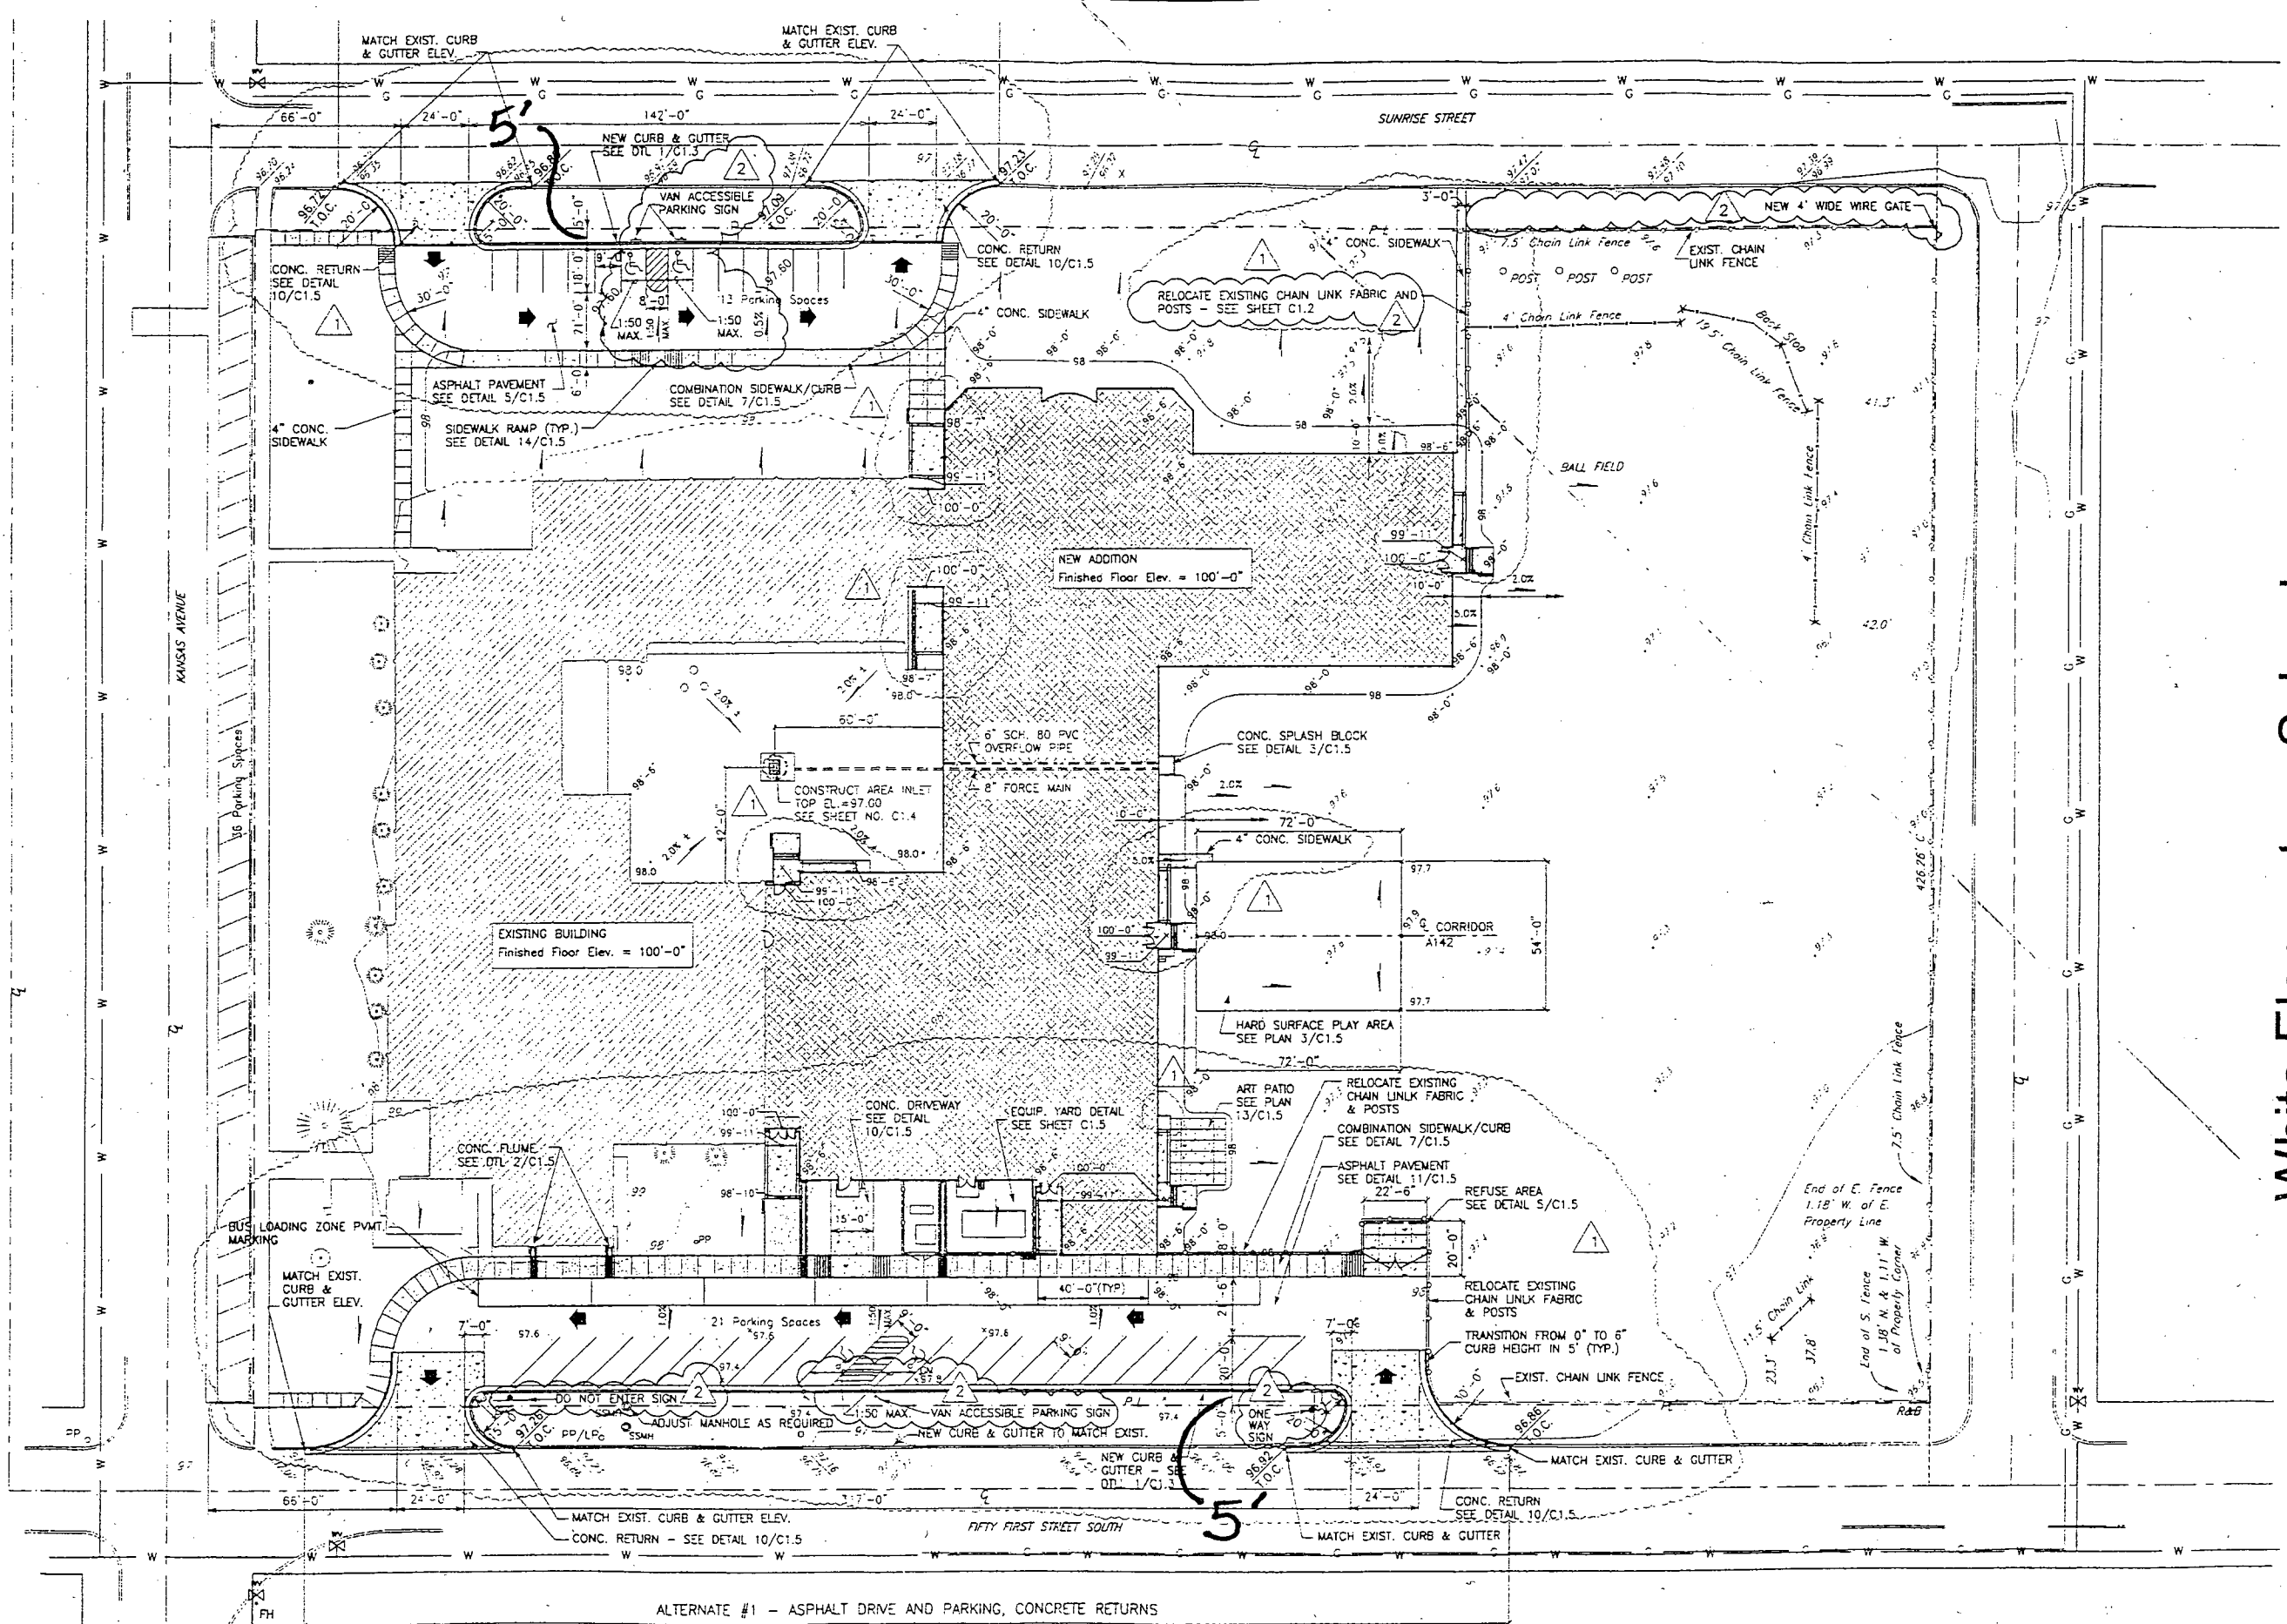

SITE PLAN - BUILDING

SCALE: 1"=30'

White Elementary School

B2A2004-00001