




Price Harris
Elementary School

706 North Armour
Wichita, Kansas



PROJECT NUMBER
01118
SHEET TITLE
SITE
ARCHITECTURAL

SHEET NUMBER
SA1
OF 1 SHEET

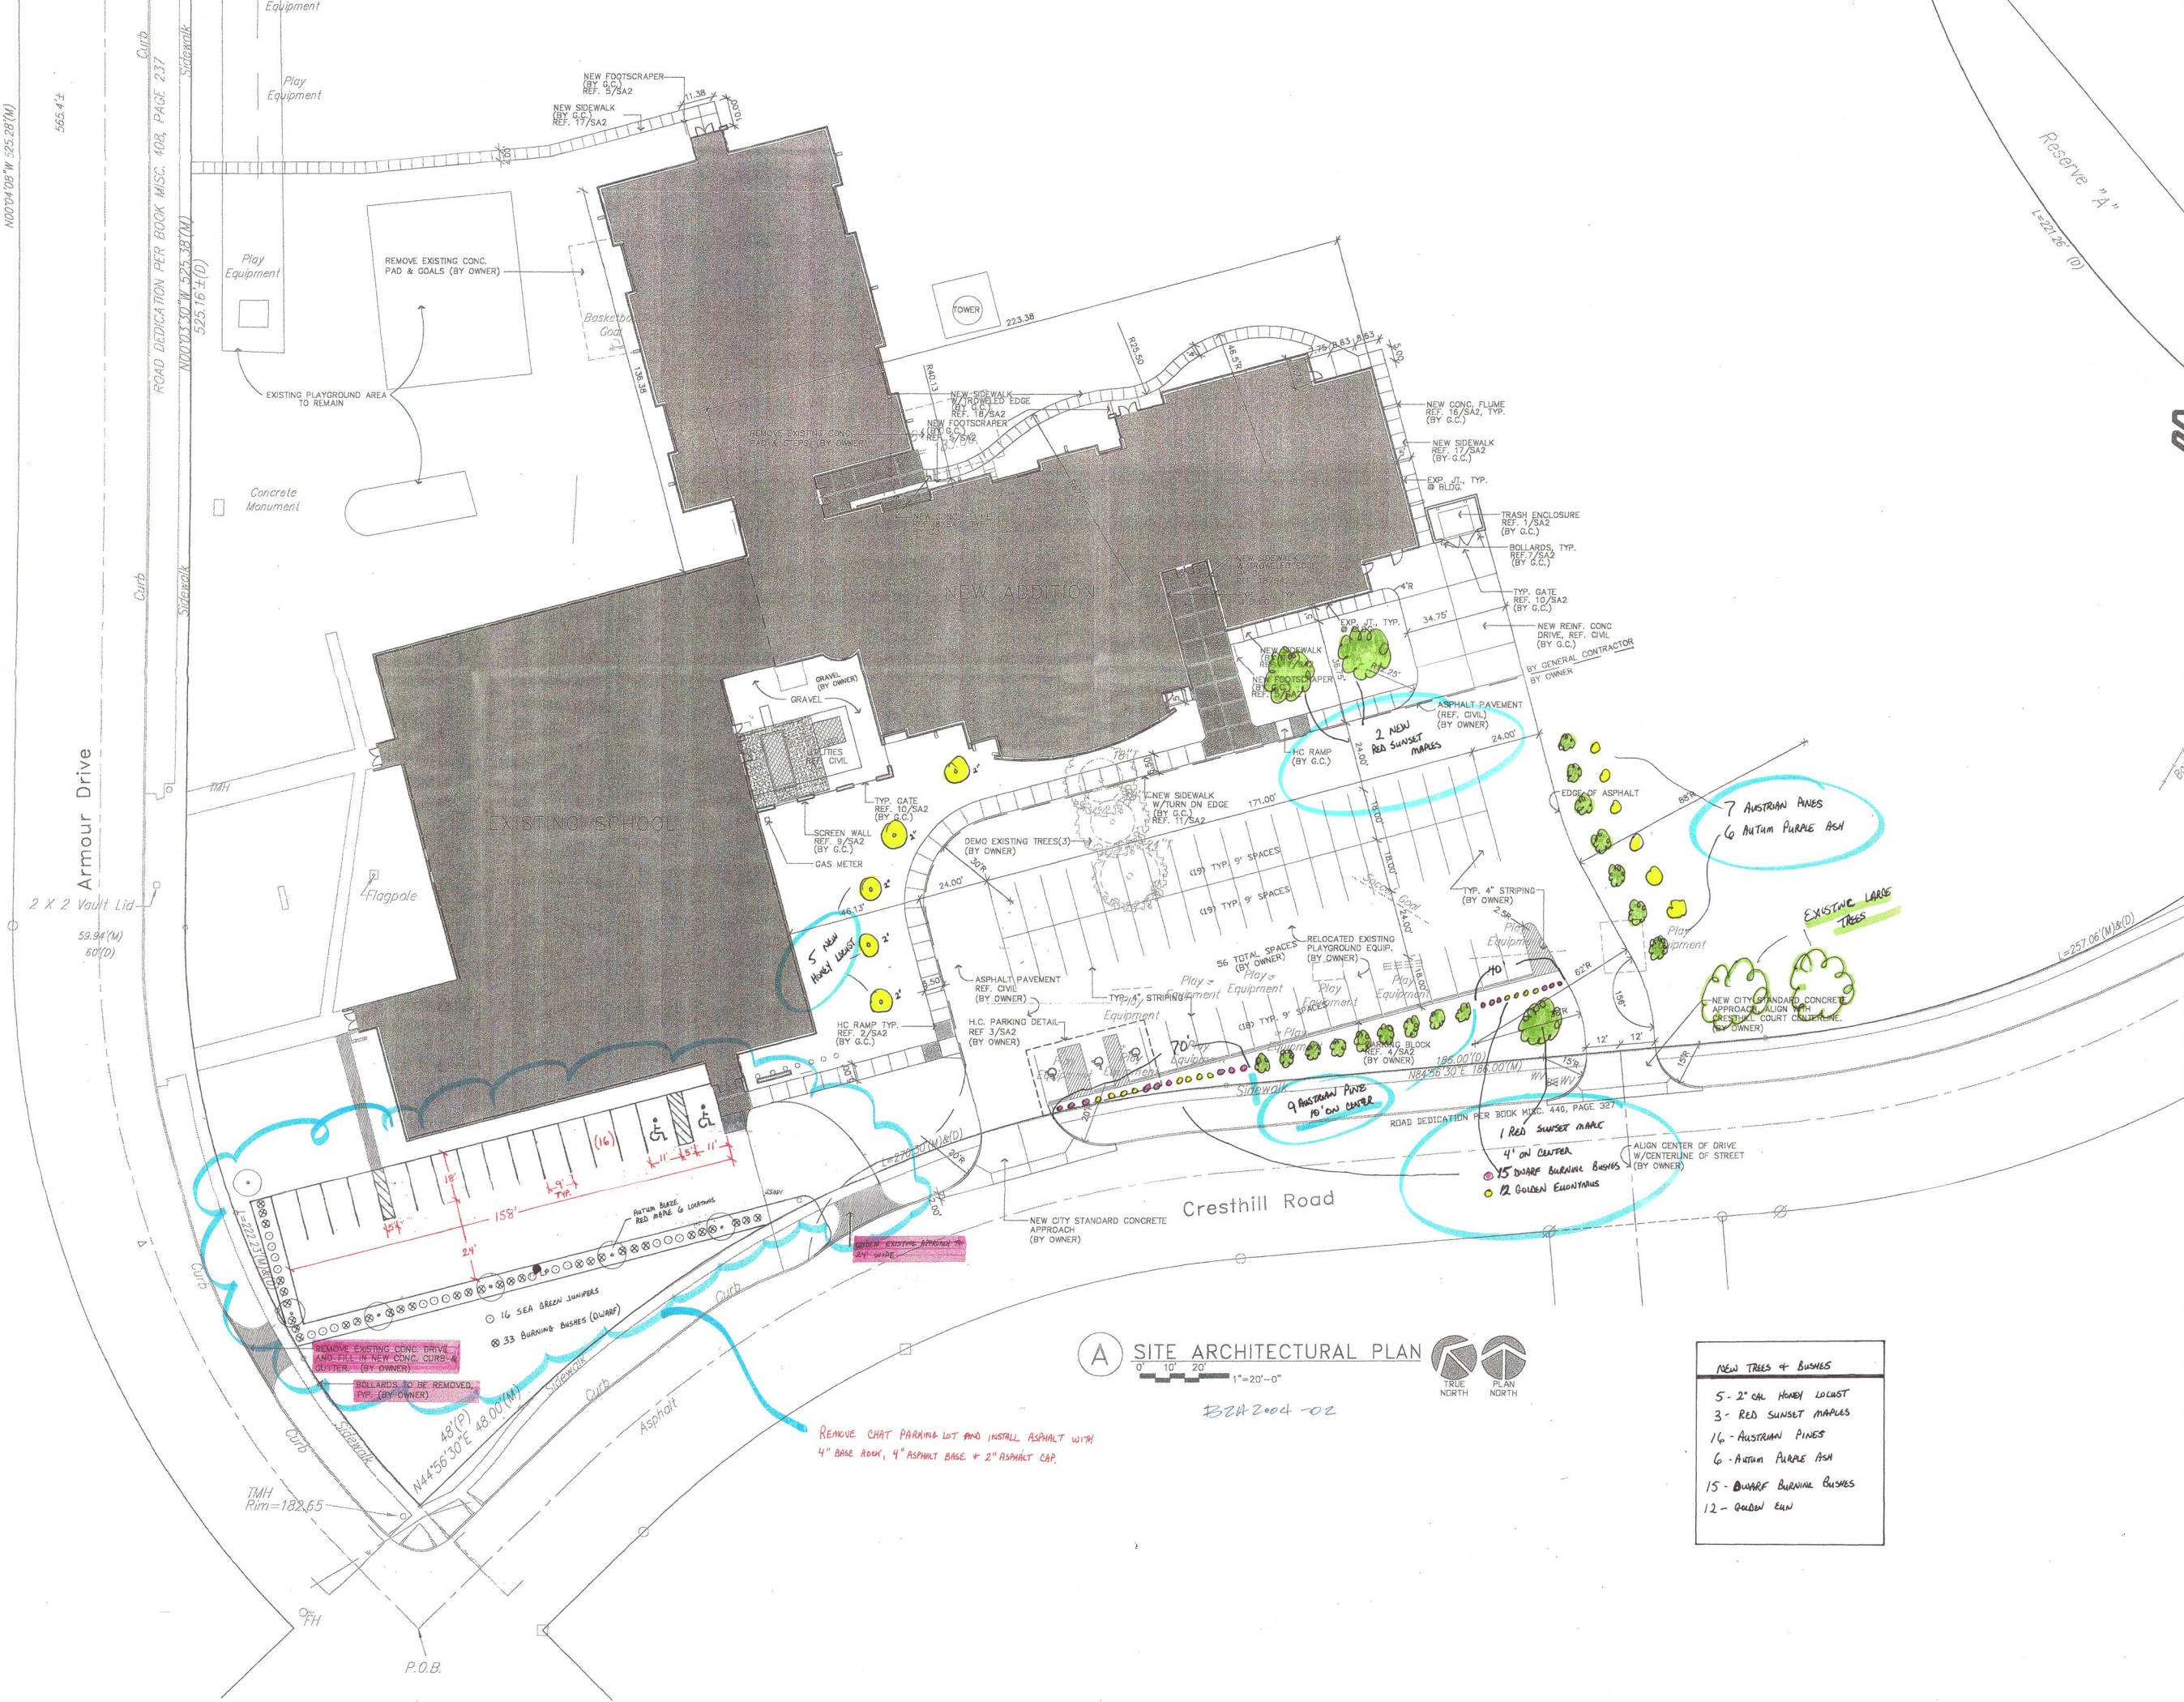

A SITE ARCHITECTURAL PLAN

0' 10' 20' 1"=20'-0"

BZA 2004-02

TRUE NORTH
PLAN NORTH

NEW TREES & BUSHES	
5 - 2" CAL. HONEY LOCUST	
3 - RED SUNSET MAPLES	
6 - AUTUM PURPLE ASH	
15 - DWARF BURNING BUSHES	
12 - GOLDEN EXONANTHUS	