

**REFERENCE MARKINGS**

- 100 ROOM NUMBERS
- Ⓜ DOOR MARK (REF: DOOR SCHEDULE)
- 10 DETAIL NUMBER (REF: SHT. IT OCCURS)
- Ⓜ DETAIL NUMBER SHEET DTL. OCCURS
- Ⓜ SECTION LETTER SHEET SECTION OCCURS
- Ⓜ WINDOW MARK
- Ⓜ METAL FRAME MARK
- Ⓜ SECTION NUMBER SHEET SECTION OCCURS

**MATERIAL KEY**

- CONCRETE
- CONCRETE BLOCK
- FACE BRICK
- EARTH
- METAL
- SAND
- GLASS-PLASTIC
- GYPSON BOARD
- ACOUSTIC TILE
- WOOD
- PLYWOOD
- WOOD
- INSULATION (FLEX)
- RIGID INSULATION
- SOLAR TILE
- CUT STONE

**GENERAL ARCHITECTURAL NOTES**

- 1. ALL CONTRACTORS TO VERIFY ALL DIMENSIONS AND CONDITIONS, INCLUDING ALL UTILITIES, PRIOR TO STARTING EACH PHASE OF WORK. ARCHITECT TO BE NOTIFIED OF ANY AND ALL DISCREPANCIES BEFORE PROCEEDING WITH THE WORK OPERATIONS.
- 3. SURFACES TO BE A UNIFORM GRADE FROM BUILDING AND/OR ELEVATIONS AS SHOWN TO EXIST. CORDS.
- 4. PROVIDE 1" FALL IN FIRST 6 FT. FROM BLDG. WHERE POSSIBLE.
- 5. CONCRETE IS MODULAR - 3 BRICK COURSES + 8"
- 6. A LINE AT DOOR OPENINGS INDICATES A CHANGE IN FLOOR COVERING MATERIAL. A TRIPLE LINE INDICATES A THRESHOLD.
- 7. DRAWINGS ARE NOT TO BE SOLID EXCEPT FOR CHECKING. IF DIMENSIONS OTHER THAN THOSE PROVIDED ARE REQUESTED THEY SHALL BE PROVIDED BY THE ARCHITECT. ALL DIMENSIONS SHALL BE VERIFIED WITH ARCHITECTURAL DRAWINGS.
- 8. ALL DIMENSIONS ARE ROUGH OPENINGS UNLESS OTHERWISE NOTED - ALLOW FOR FITTINGS.
- 9. ALL STUD WALLS TO BE 2x6 @ 16" O.C. EXCEPT WHERE NOTED OTHERWISE.
- 10. GENERAL CONTRACTOR TO PROVIDE ALL TEMPORARY BRACING NECESSARY UNTIL ALL WALLS, PRECAST JOISTS, AND ROOFS ARE IN PLACE.
- 11. N.T.C. - NOT IN CONTRACT.

**SOIL BORING LOG**


**PLOT PLAN LEGEND**

- EXISTING GRADES
- FINISH GRADES
- PROPERTY LINE
- GAS SERVICE
- WATER SERVICE
- ELECTRIC & TELEPHONE SERVICE
- SEWER SERVICE

**KEY TO DRAWINGS**

SHEET No.	DESCRIPTION AND CONTENTS
1	PLOT PLAN - MISC. NOTES
2	FOOTING & FOUNDATION PLANS - 1ST FL. FRAMING PLAN
3	2ND FL. FRAMING PLANS - ROOF FRAMING PLANS
4	BSMT. PLAN & FINISH SCHEDULE - INT. DOOR DTL.
5	1ST FLOOR PLAN
7	1ST & 2ND FL. FINISH SCHEDULES - COLOR & MAIL SCHED.
8	EXTERIOR ELEVATIONS - MISC. DTL.
9	EXTERIOR ELEVATIONS - INT. DOOR & WDN. DETAILS
10	EXT. ELEV. - ORGAN SCREEN DETAILS - MISC. DTL.
11	LONGITUDINAL & CROSS SECTIONS - MISC. DTL.
12	WALL SECTIONS - GUTTER DETAILS
13	STAIR No. 1 & No. 3 DETAILS
14	STAIR No. 2 & ENTRY No. 2 STAIR DTL. - RAMP DTL.
15	WINDOW DETAILS - METAL FRAME DETAILS
16	ROOM ELEVATIONS - MILLWORK DETAILS
17	TOWER DETAILS - MISC. DTL.
M-1	BASEMENT PLUMBING PLAN
M-2	1ST FL. PLUMBING PLAN
M-3	2ND FL. PLUMBING PLAN
M-4	BASEMENT HEATING & AIR COND. PLAN
M-5	1ST FL. HEATING & AIR COND. PLAN
M-6	2ND FL. HEATING & AIR COND. PLAN
E-1	1ST FL. ELECTRICAL PLAN
E-2	BSMT. & 2ND FL. ELECTRICAL PLANS

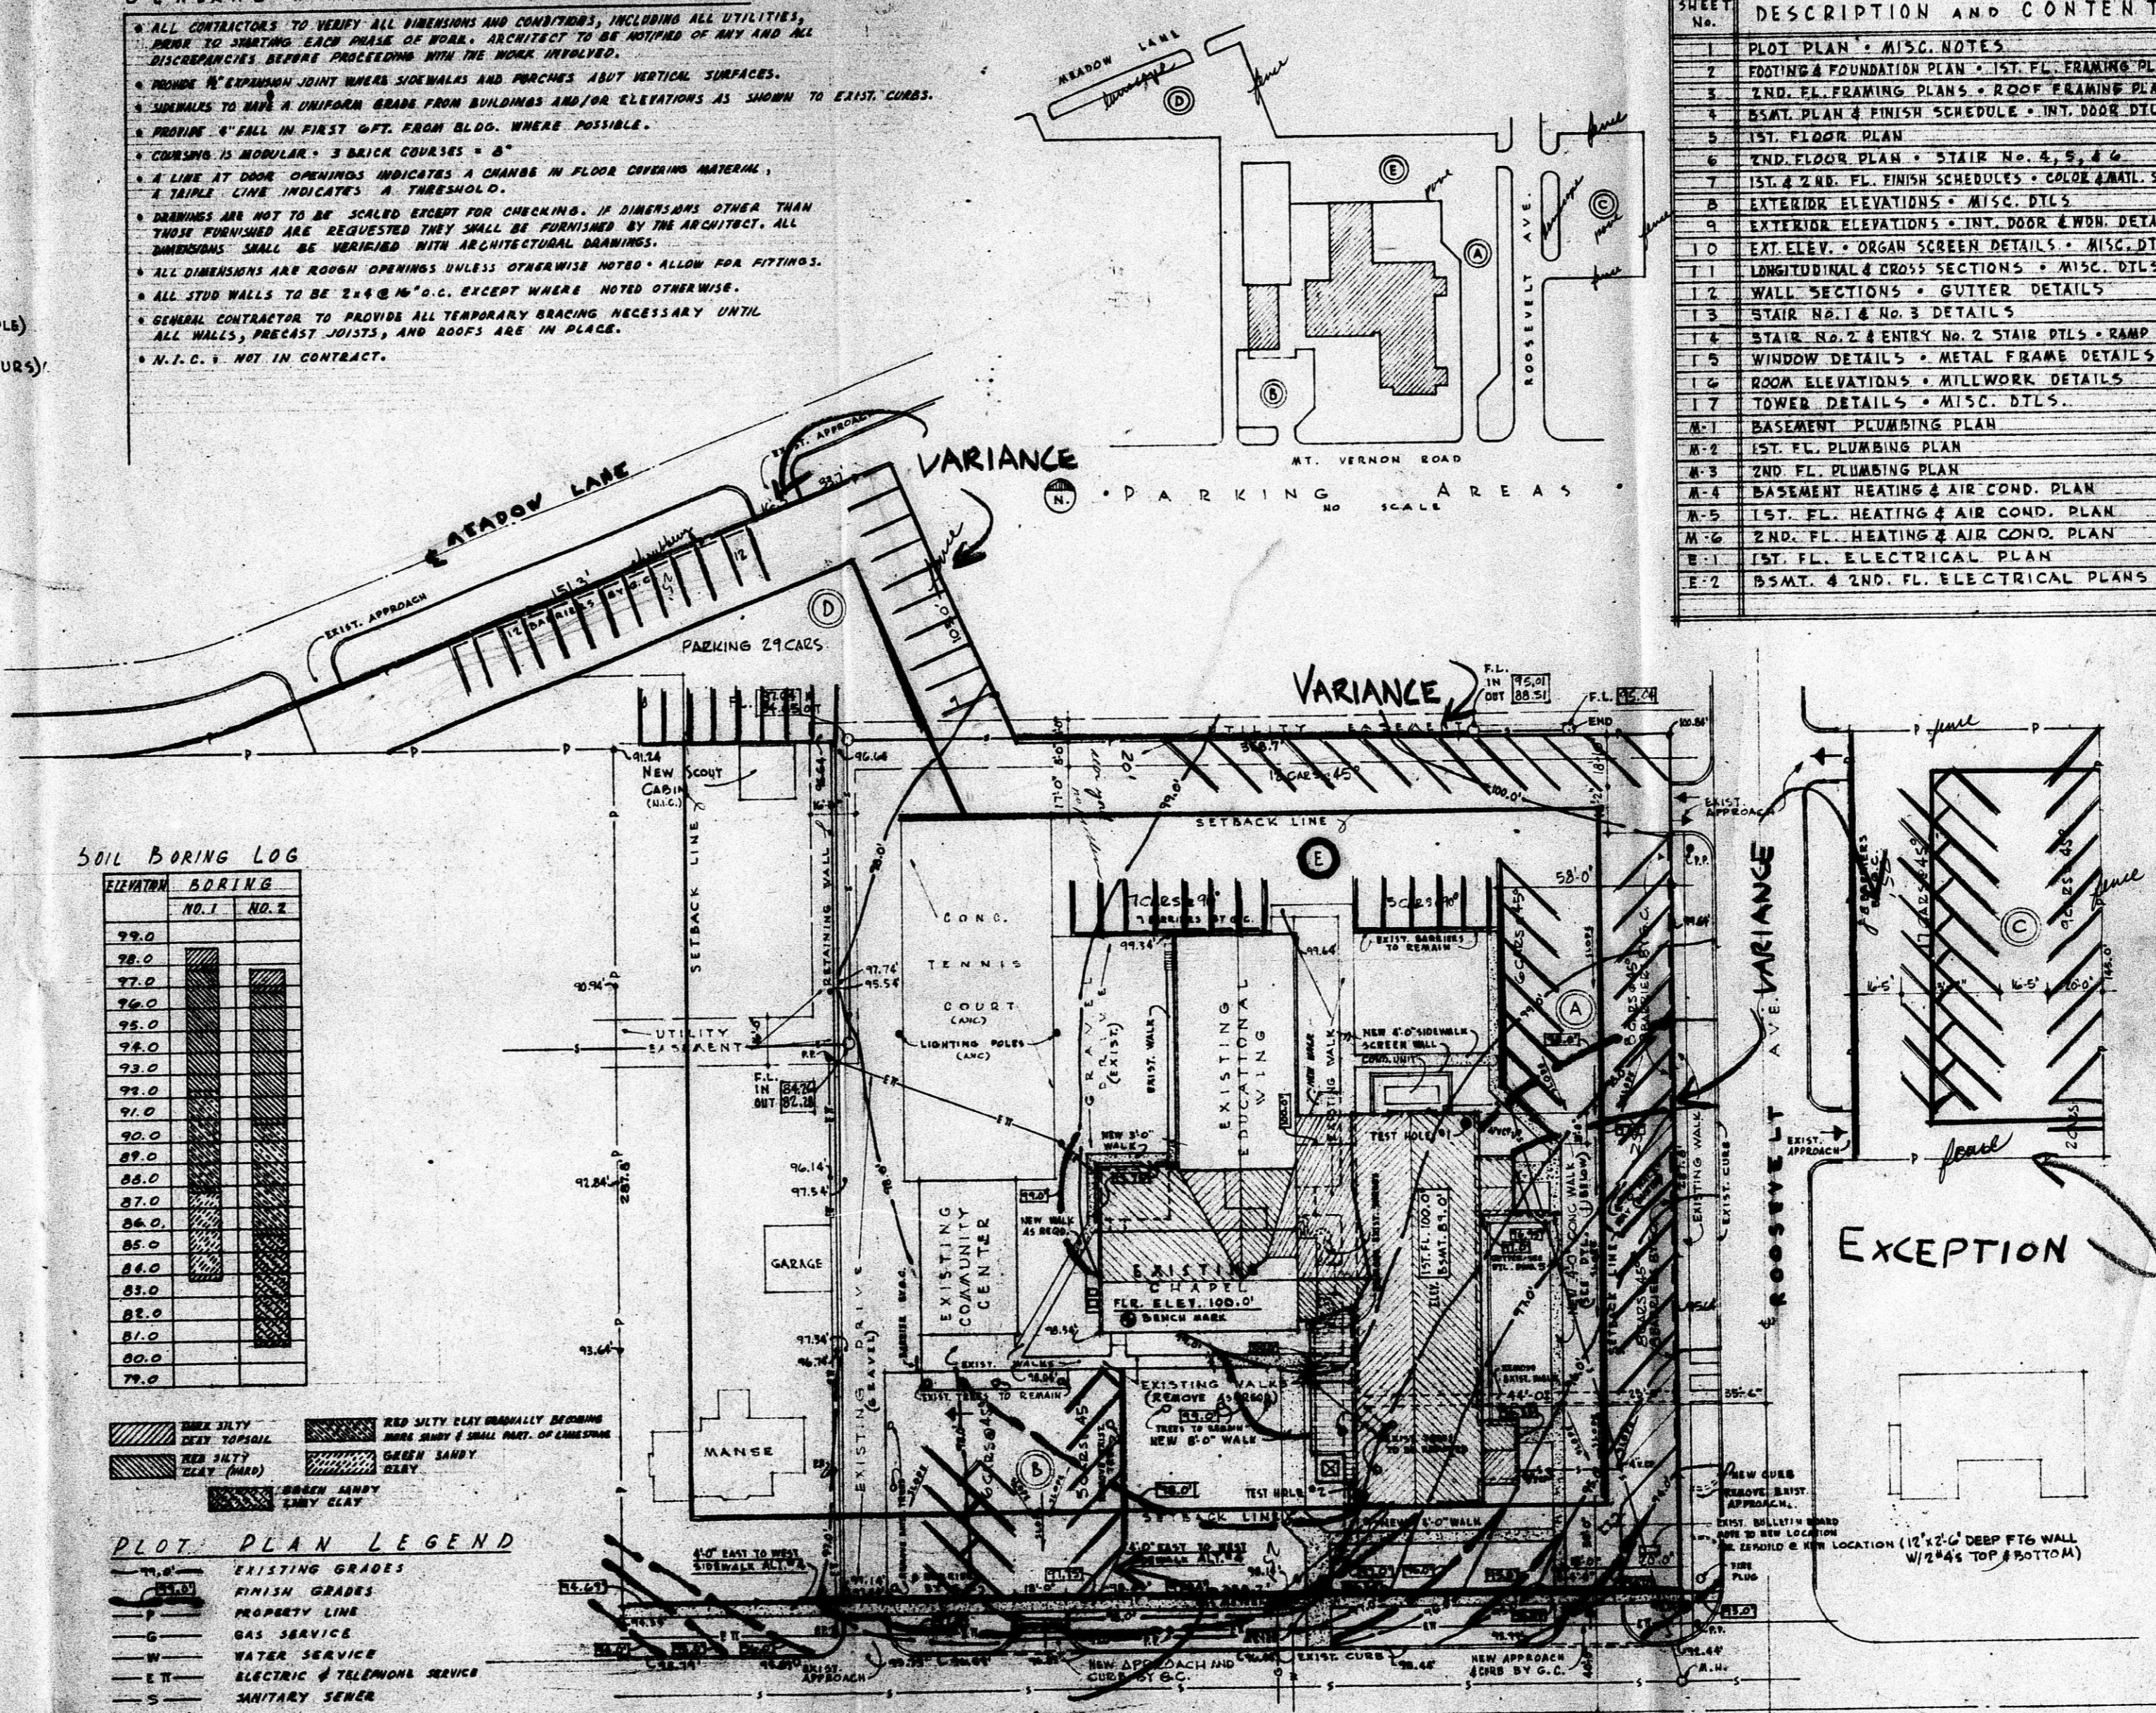

**PLOT PLAN**

SCALE 1" = 50'-0"

TOPO DATA: CLYDE W. BAUGHMAN CO. WICHITA, KANSAS 2-58-64

114 CARS @ 5 = 570 PERSONS  
 NAVE - 504  
 CHAIR - 50  
 CHANCELS - 4  
 558 SEATING

- NOTE: TURN CURB RADII ON NEW APPROACHES TO MEET REQUIREMENTS OF CITY OF WICHITA.
- NOTE: P.C. TO BE 10' OF 10' EXIST. CONC. BARBERS.
- NOTE: PROVIDE A FALL IN FIRST 6' OF GRADE FROM BUILDING WHERE POSSIBLE.

**CARMICHAEL WHEATCROFT & ASSOCIATES**  
**ARCHITECTS - ENGINEERS**  
 WICHITA, KANSAS

MOUNT VERNON PRESBYTERIAN  
 CHURCH & EDUCATION UNIT  
 SOUTH ROOSEVELT AT MT. VERNON RD.  
 WICHITA, KANSAS

1-65  
 PROJECT No. 303  
 DATE 1-1-65  
 OF 17