BZA 7-88

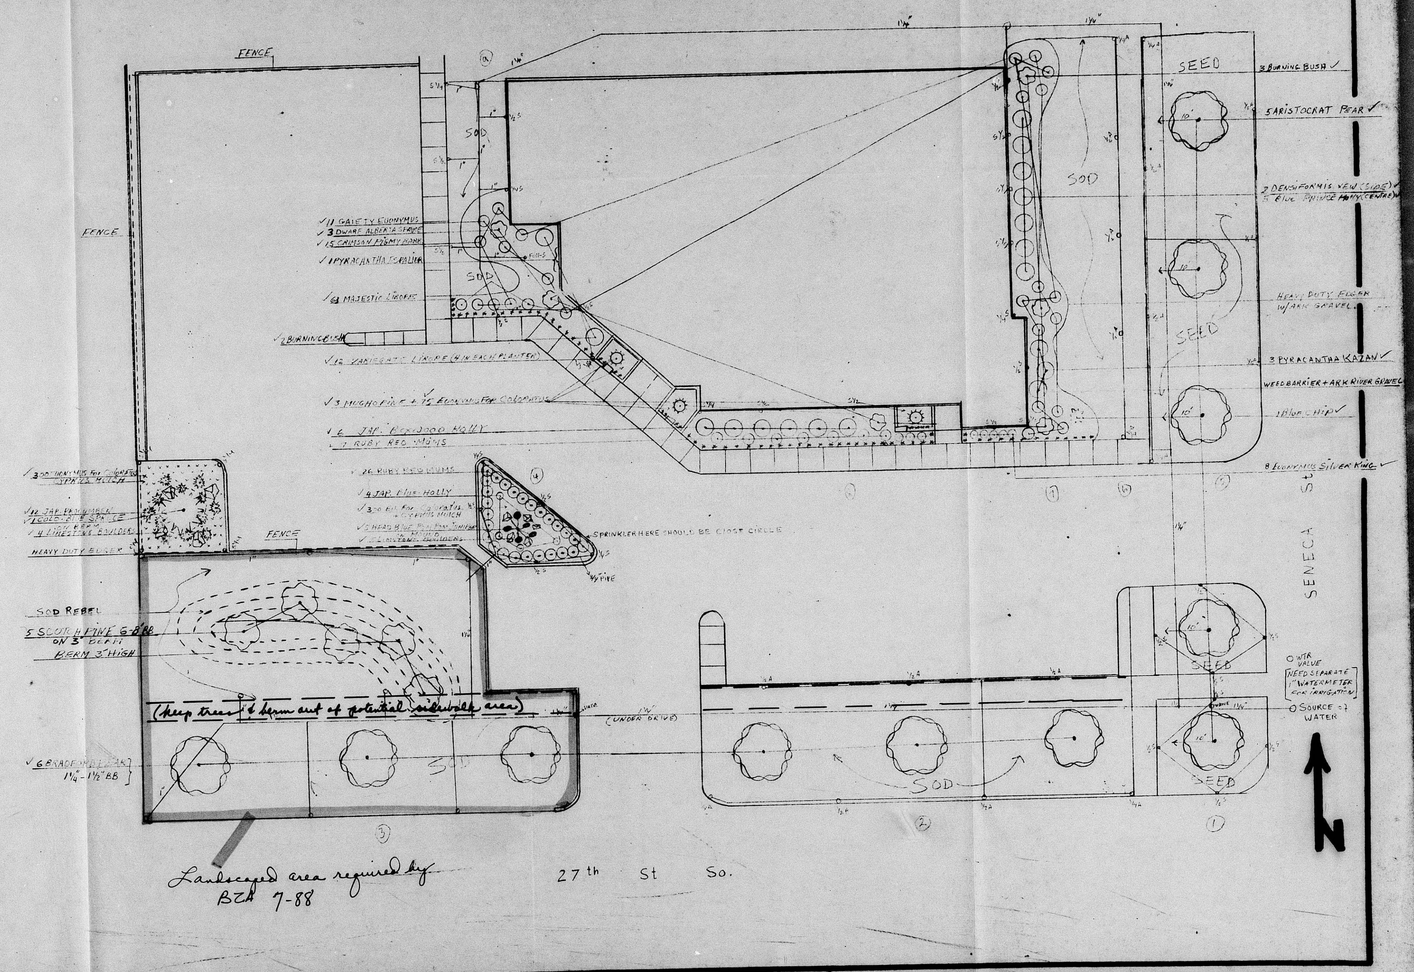

FAMILY MED CENTER
2757 SO SENECA
THE MODEL NURSERY
11716 E. KELLOGG
BY
DR. A. J. TINSAH

BZA 7-88
Approved landscape plan
L.O.
10-25-88

Landscaped area required by
BZA 7-88

NAPD copy 1 of 1

FILMED FROM THE BEST AVAILABLE COPY