


BZA 7-88

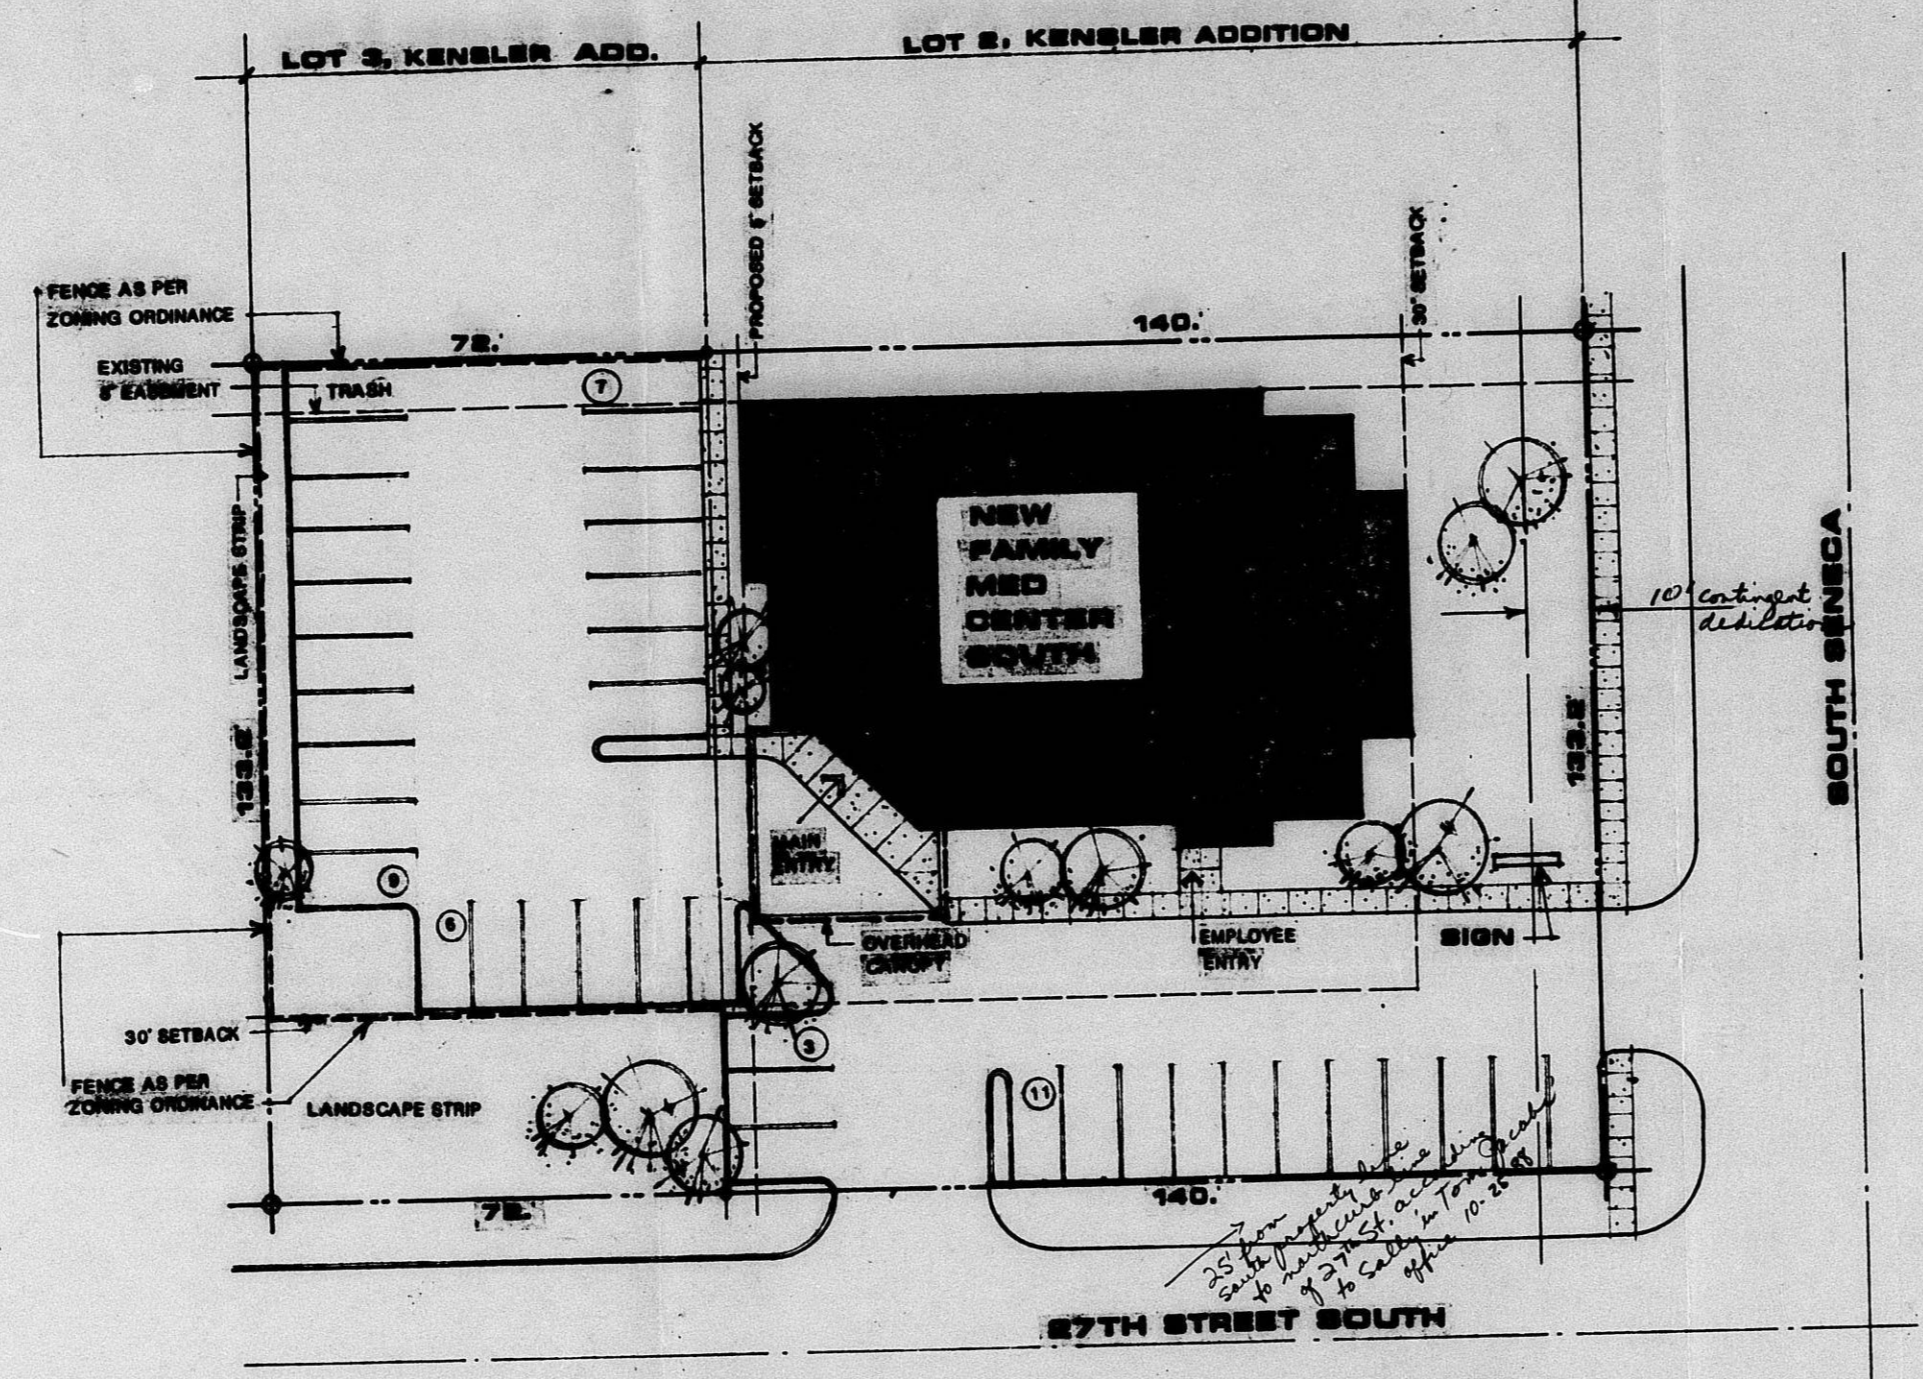

SITE PLAN

SCALE 1" = 20'-0"

BZA 7-88 & BZA 8-88

SITE DATA	
SITE AREA	25,228 SQ FT
BUILDING AREA	2040 SQ FT
TOTAL PARKING	36 STALLS

JOB NO. 87280
 FAMILY MED CENTER SOUTH
 27TH STREET SOUTH & SENECA
 AIA - ARCHITECT (2400 N. WOODLAWN) WICHITA, KANSAS
 DATE: 16 FEBRUARY 1988
 SHEET 1 OF 1
 THOMAS D. JACOB