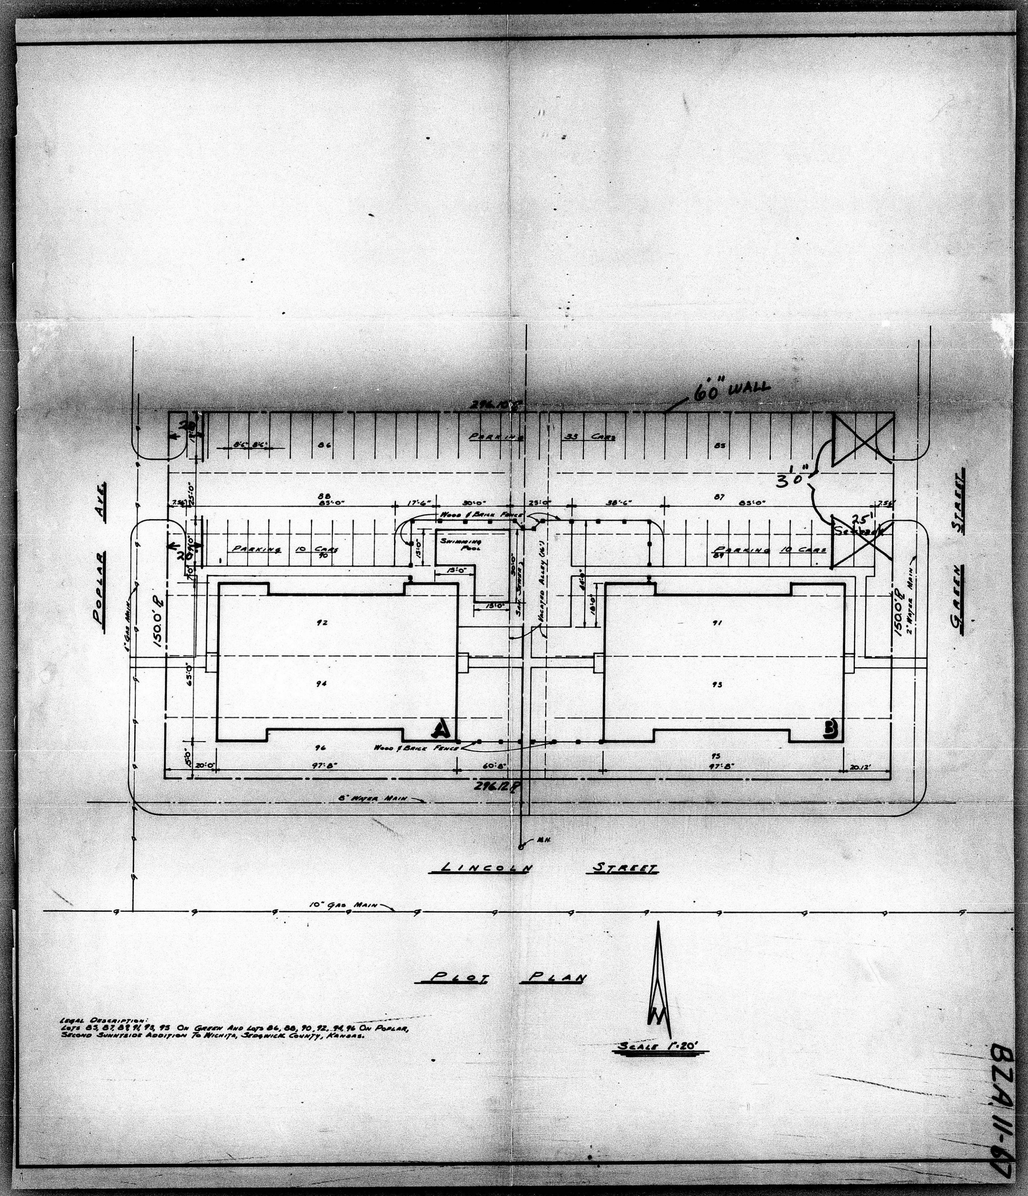

BZA 11-67

FILMED FROM THE BEST AVAILABLE COPY