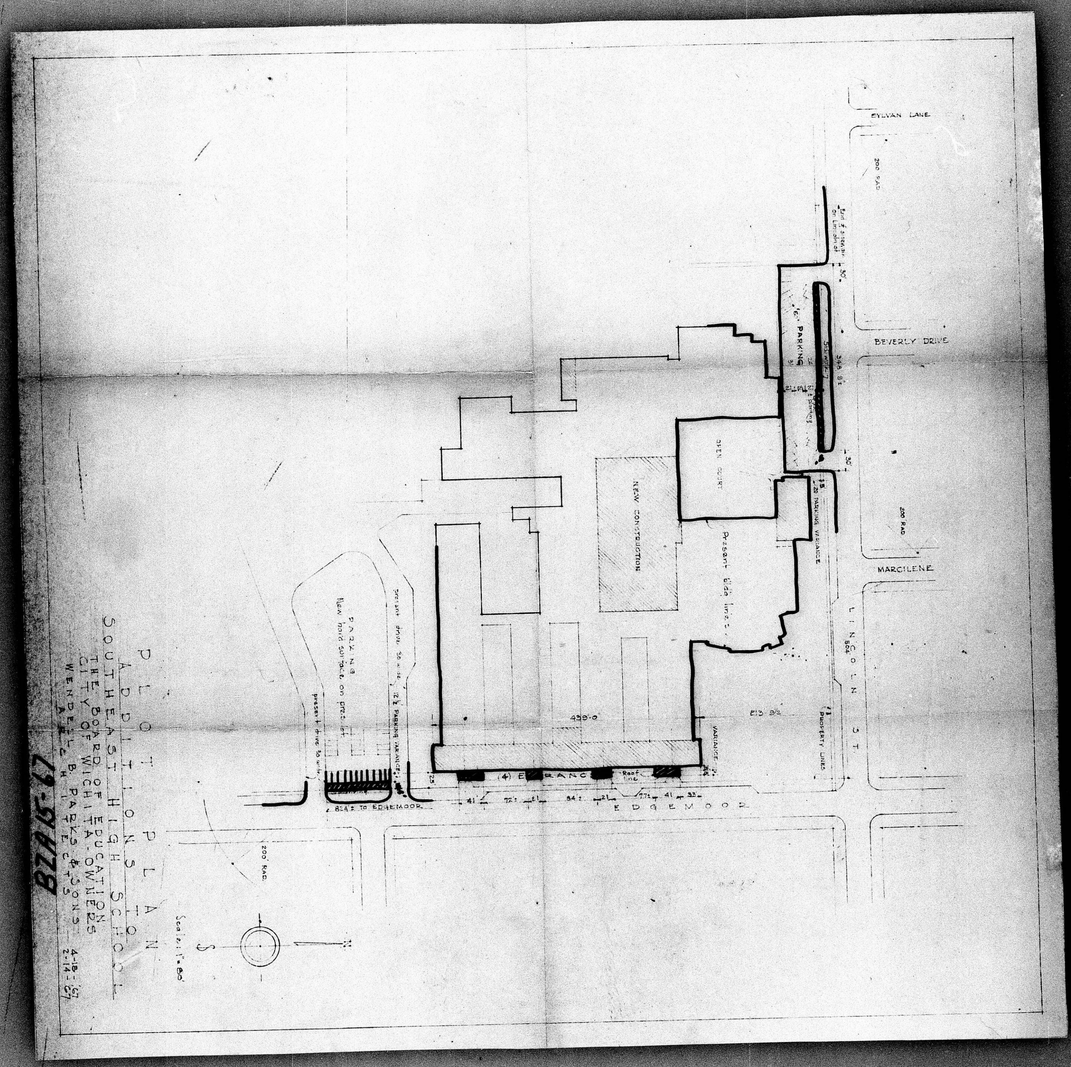

FILMED FROM THE BEST AVAILABLE COPY

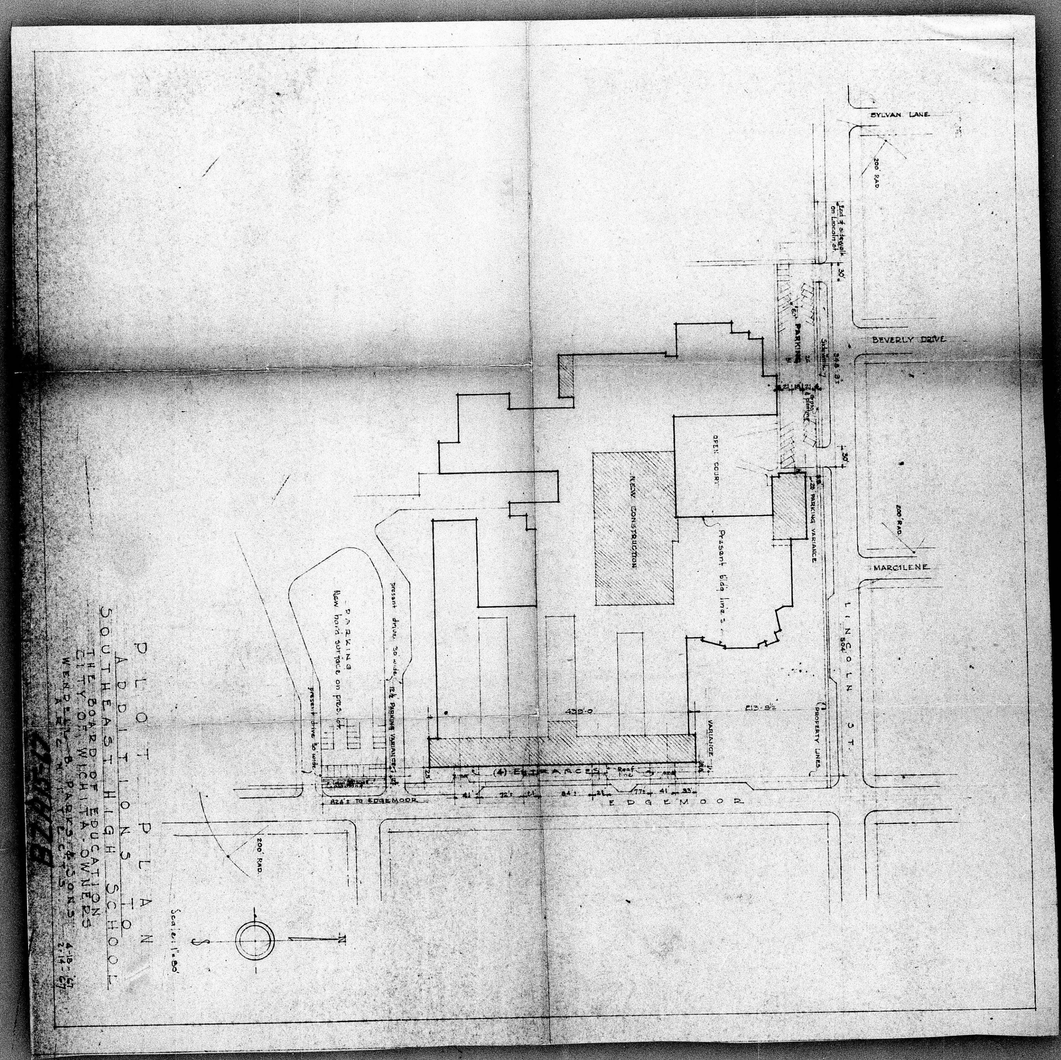

FILMED FROM THE BEST AVAILABLE COPY....