



BZA 15-87

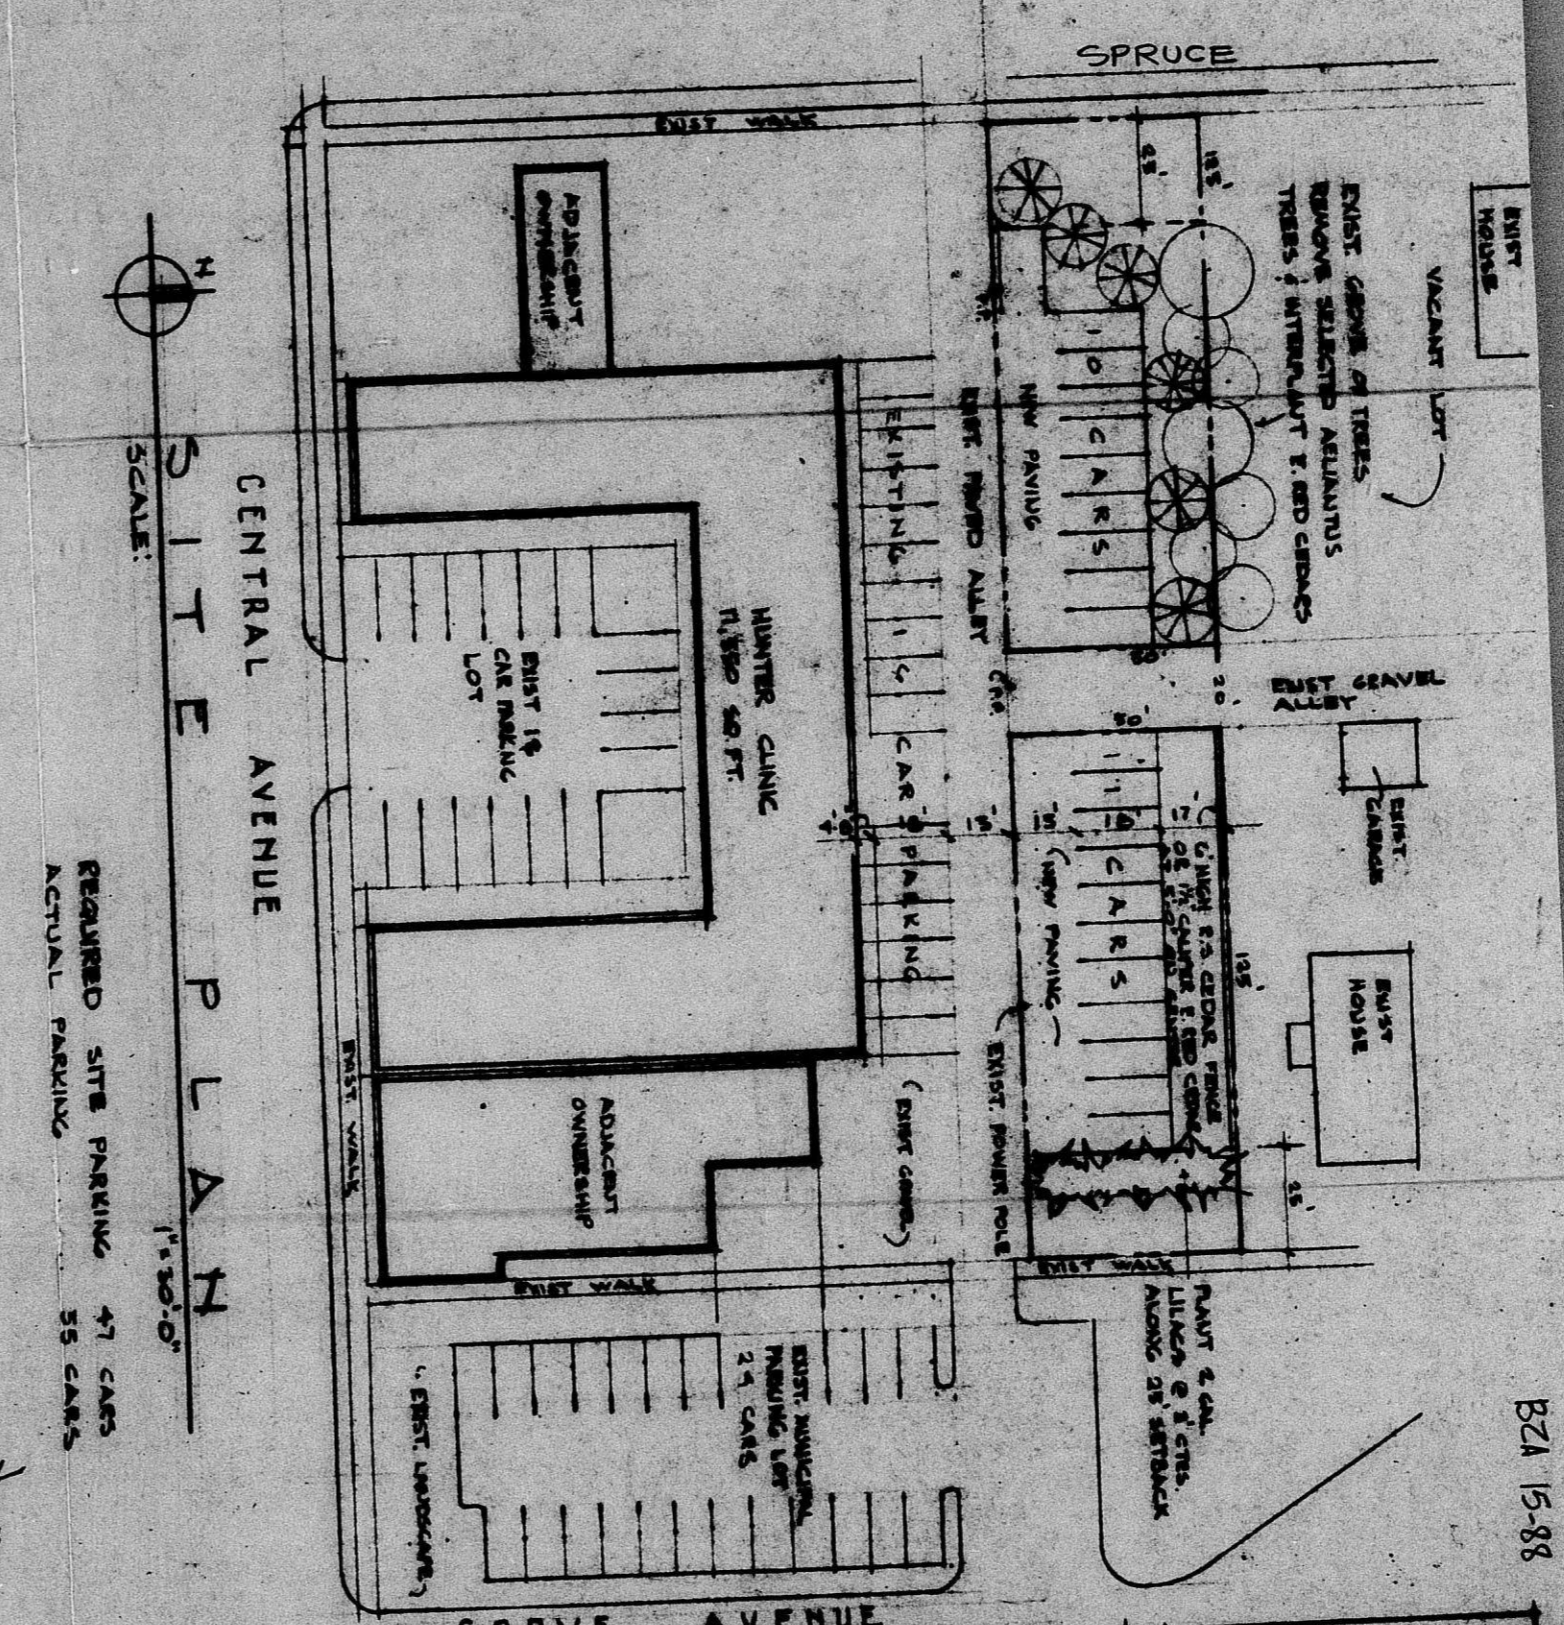

REQUIRED SITE PARKING 47 CARS
 ACTUAL PARKING 55 CARS

*Parking of Home
 s.e. for BZA
 Ed. A. Murabito
 8-15-88*

BZA 15-88

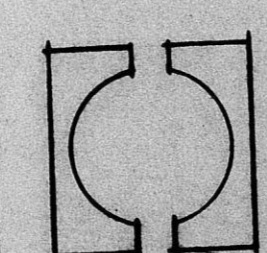


*As submitted
 for BZA review*

HUNTER HEALTH CLINIC
 2915 E. CENTRAL
 WICHITA, KANSAS

EDWARD A. MURABITO
 ARCHITECT
 PLANNER
 WICHITA, KANSAS



HUNTER HEALTH CLINIC

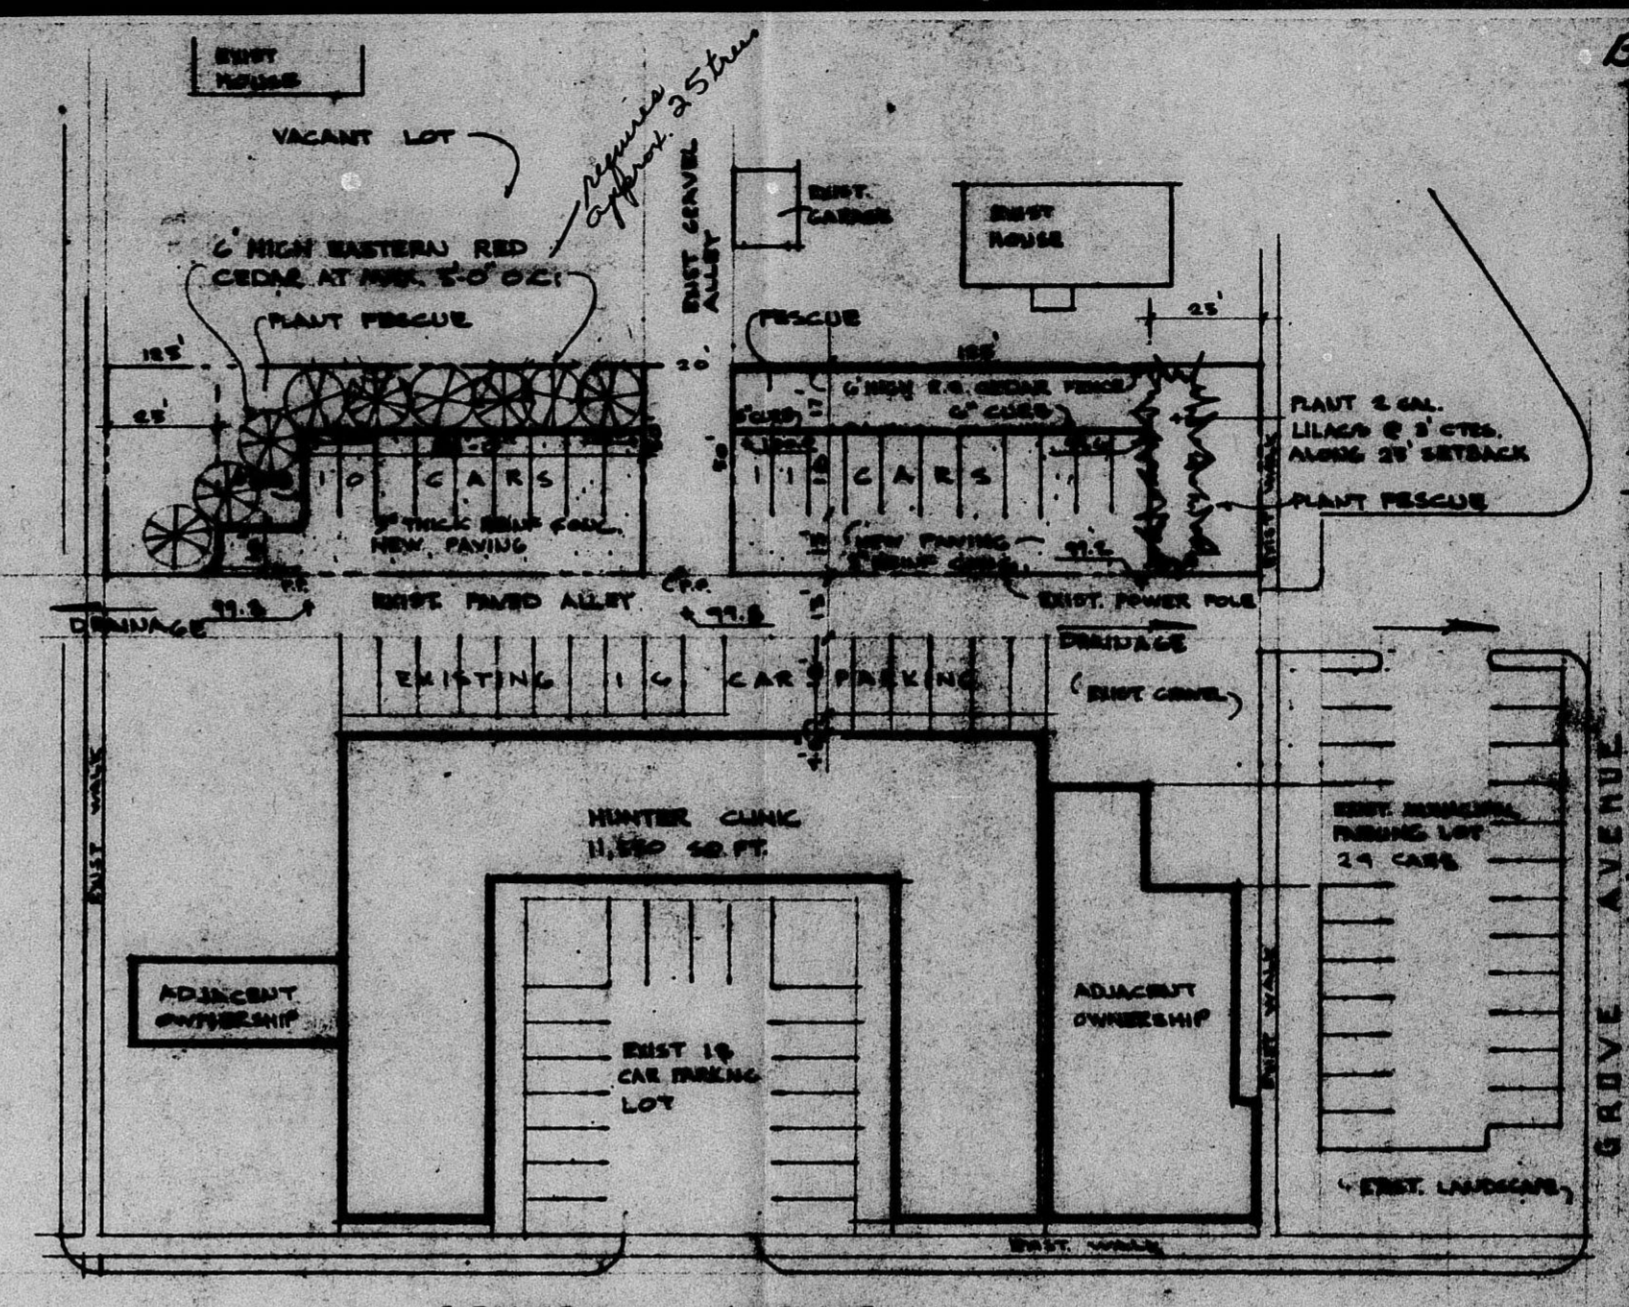

SITE PLAN
SCALE: 1"=20'-0"

- REQUIRED SITE PARKING 47 CARS
- ACTUAL PARKING 33 CARS
- NEW PAVING 2" ASPHALT CONC. W/ 4% CEMENT FILL. SEE PLAN FOR ROLLED CONC. CURB LOCATIONS. CONTRACTOR SHALL ALSO ADD MARKING STRIPS AND PAINT PARKING LINES W/ YELLOW PAINT
- GEN CONTRACTOR SHALL CLEAR REAR LOTS OF ALL TREES, VEGETATION & DEBRIS PRIOR TO PAVING & PLANTING.
- TILL & PREP REQUIRED PRIOR TO PLANTING RESCUE

SCHEDULE OF DRAWINGS
SHEETS 1 THRU 6, M1, M2, P1, E1, E2, E3

BZA 15-88
Approved site plan
w/ landscape plan
M.A.P.R. copy 1 of 1

BZA 15-88

ARCHITECT
PLANNER

HUNTER HEALTH CLINIC

BZA 15-88