


2

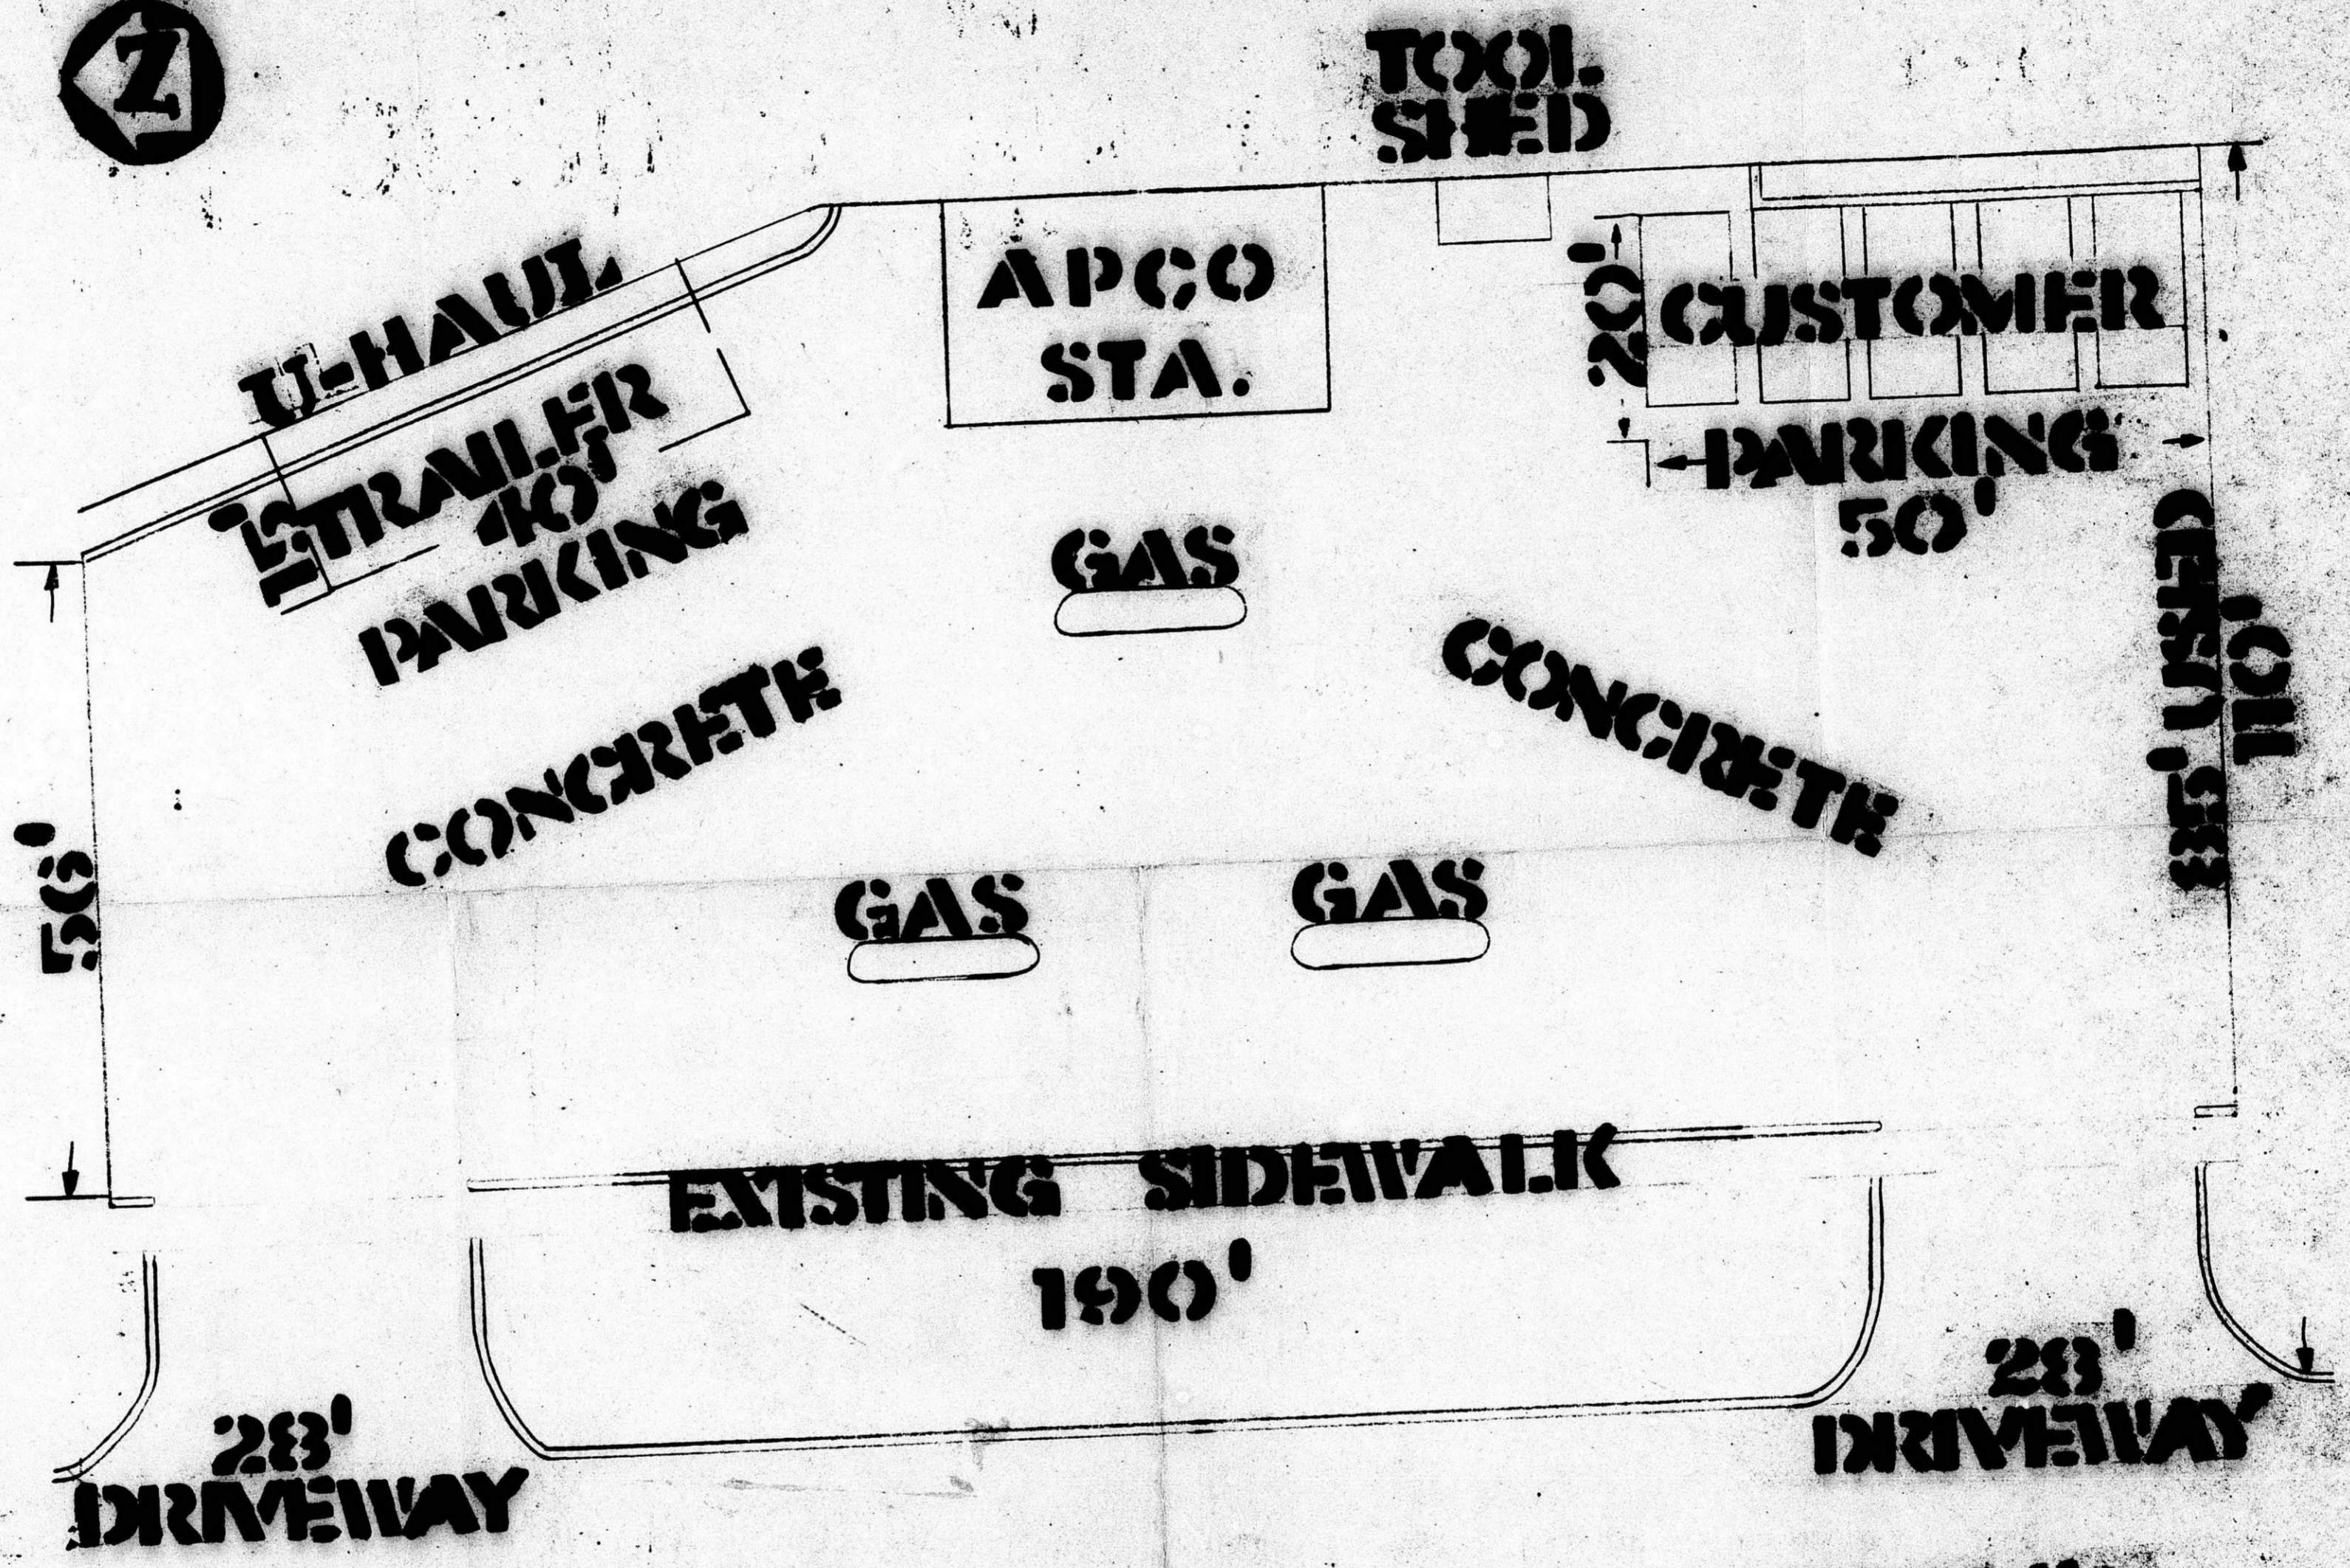

TRAFFIC ENGINEERING DIVISION APPROVED
 Date: 7th Feb
6-5-74
 (A) Parking borders shall be installed at all locations that are adjacent to public property (so that vehicles will not obstruct public property) and have a minimum length of 6 feet and a minimum cross section of 4" x 4".
 (B) Stall lines shall be painted and 4" or greater in width.
 (C) Proper ingress and egress signs shall be installed on private property at the entrances and exits of the parking facility.


BZA
 12-11-74

3850 S. SENECA
 BZA 17-74

SCALE:
 1"=10'

REMOVED FROM THE RECORD

BZA 17-74

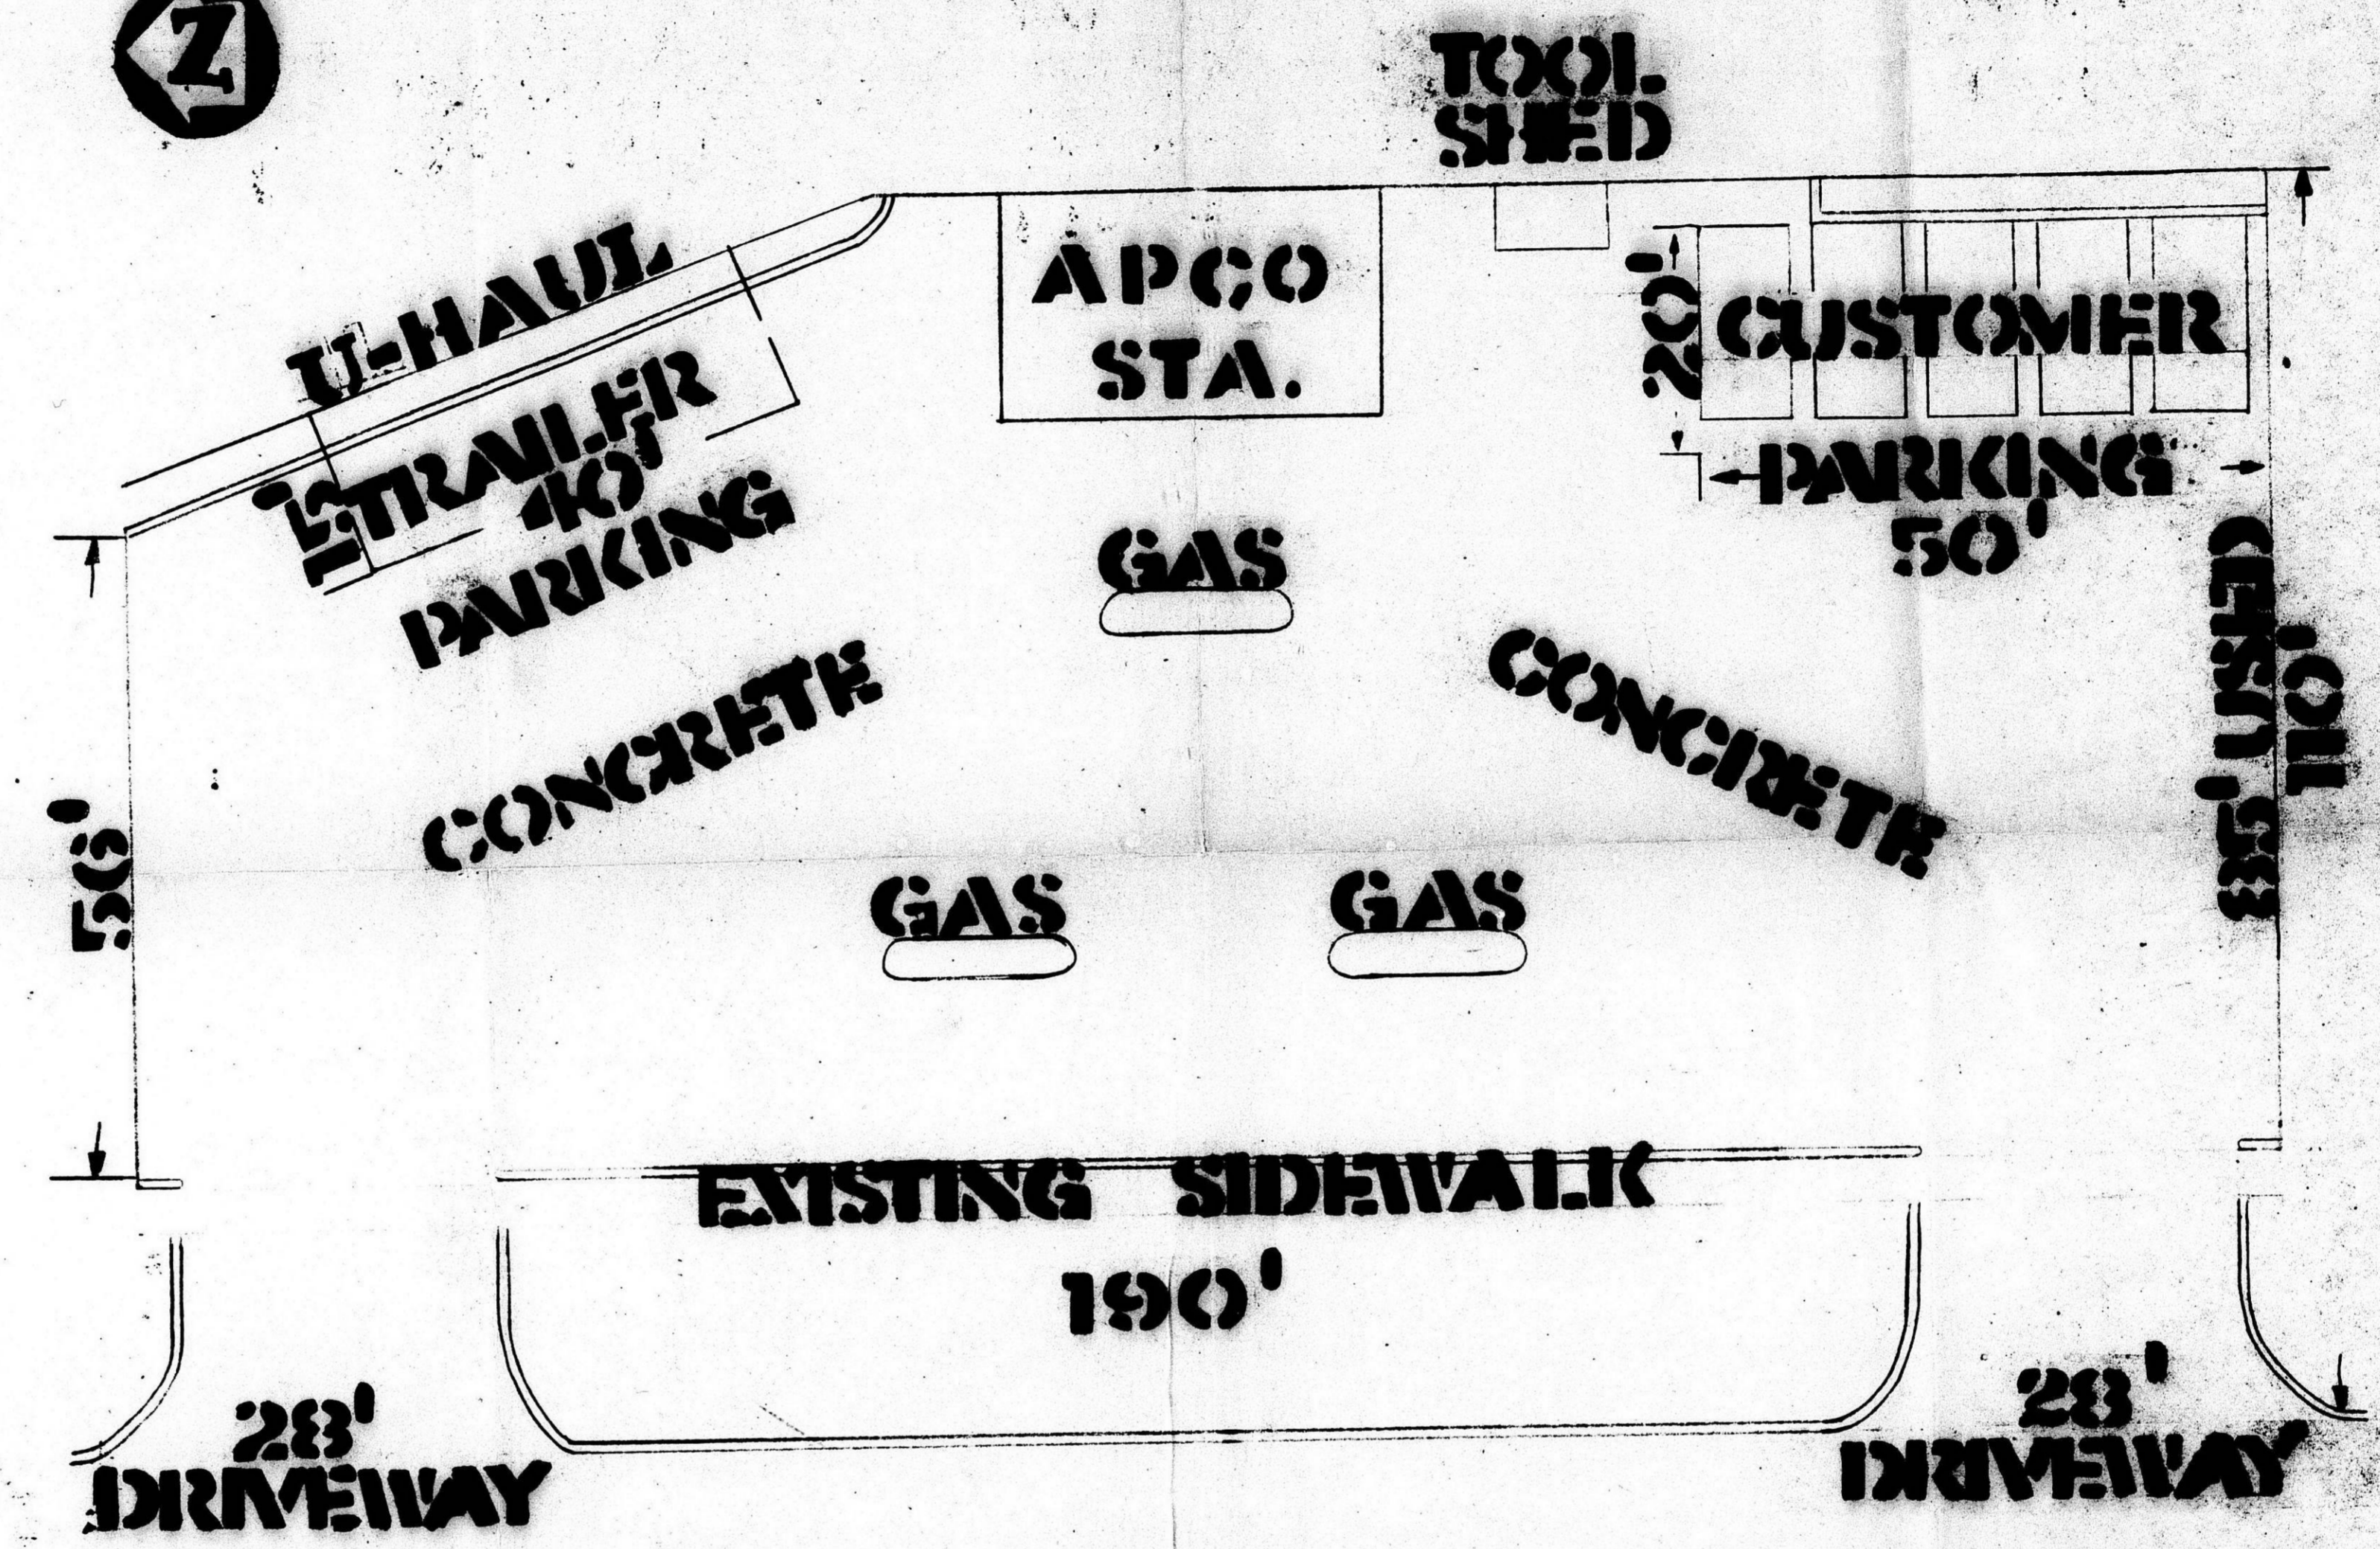

TRAFFIC ENGINEERING DIVISION APPROVED
 MISS TULLO
 6-5-74
 (A) Parking barriers shall be installed at all locations that are adjacent to public property (so that vehicles will not obstruct public property) and have a minimum length of 6 feet and a minimum cross section of 4" x 4".
 (B) Stall lines shall be painted and 4" or greater in width.
 (C) Proper ingress and egress signs shall be installed on private property at the entrances and exits of the parking facility.

38350 S. SENECA

BZA 17-74

SCALE:
1"=10'

FILMED FROM THE BEST AVAILABLE COPY