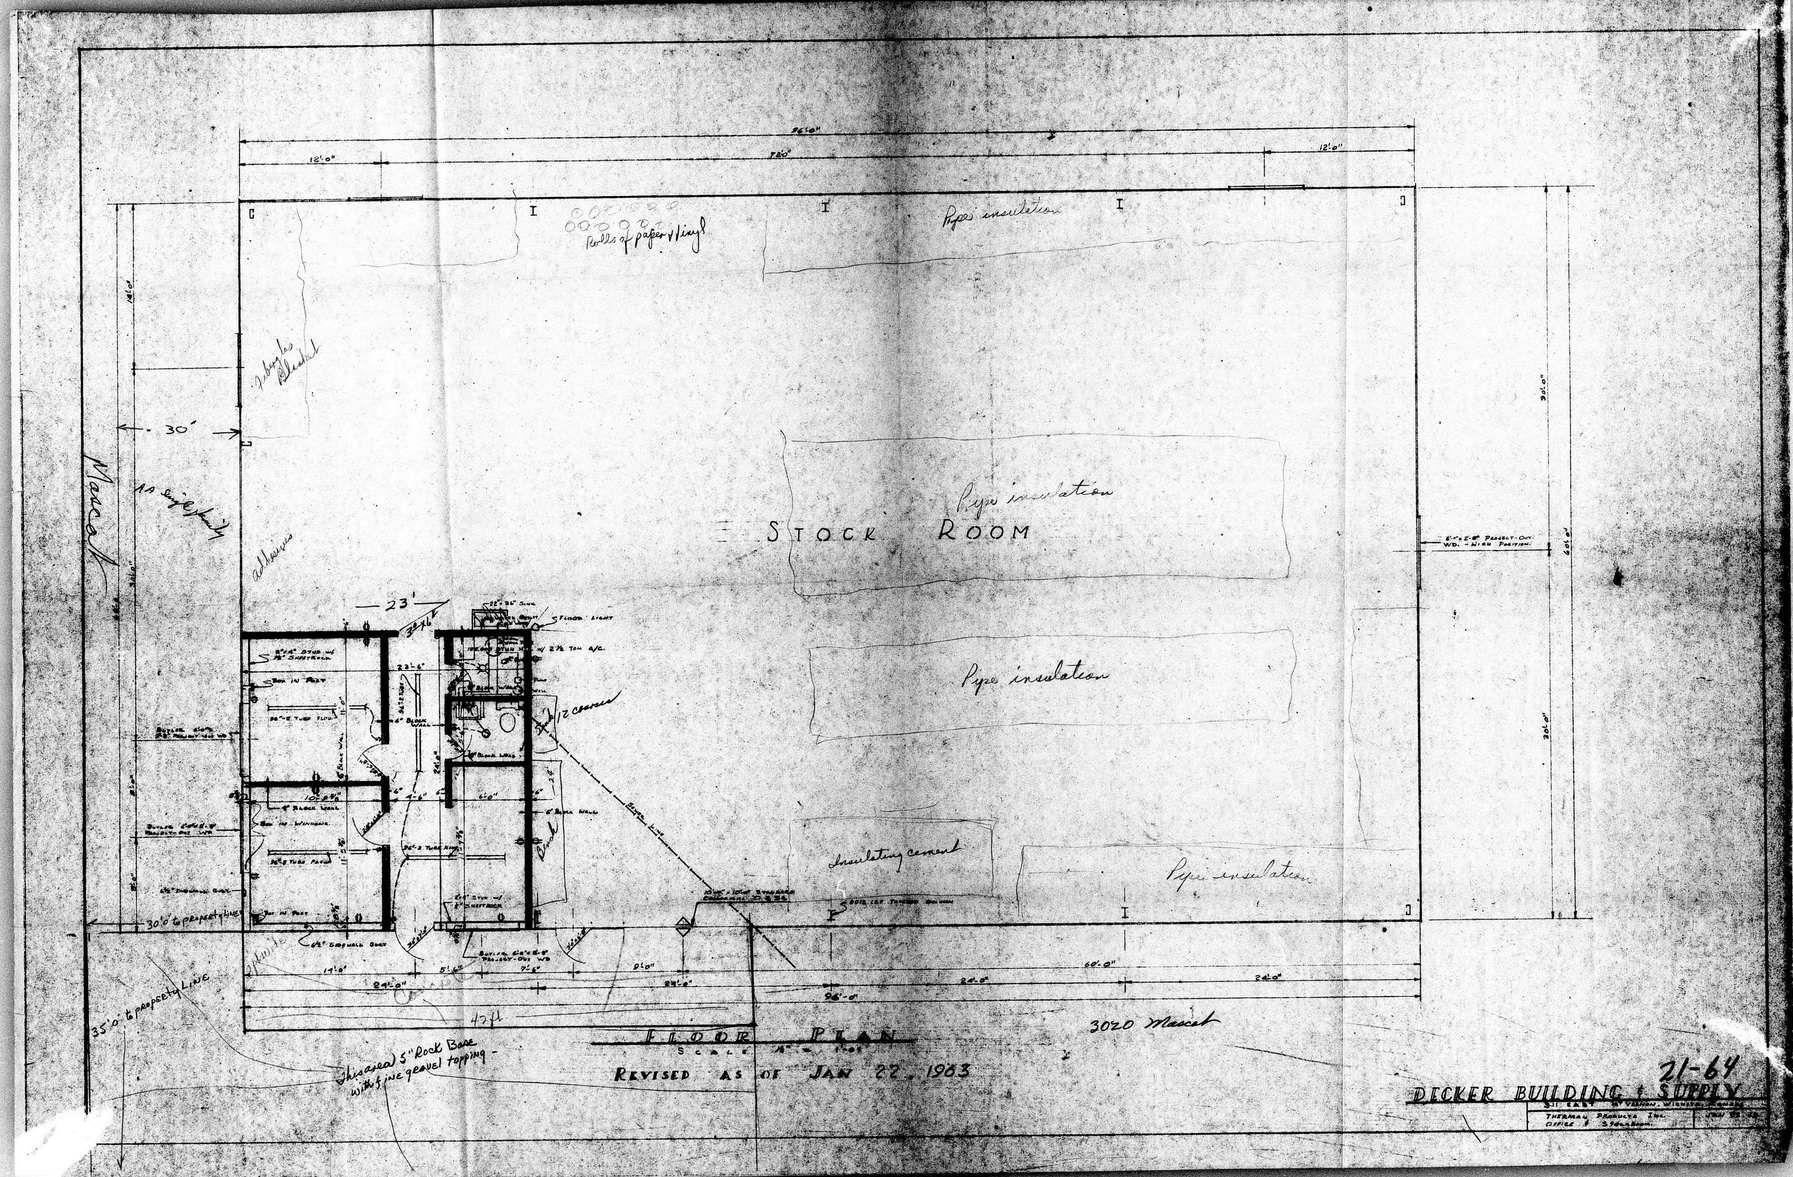
Rolls of paper & vinyl
Pipes insulation
Pipe insulation
STOCK ROOM
Pipe insulation
Insulating cement
Pipe insulation
30'
23'
12 cement
30'0" to property line
35'0" to property line
3020 Mascot

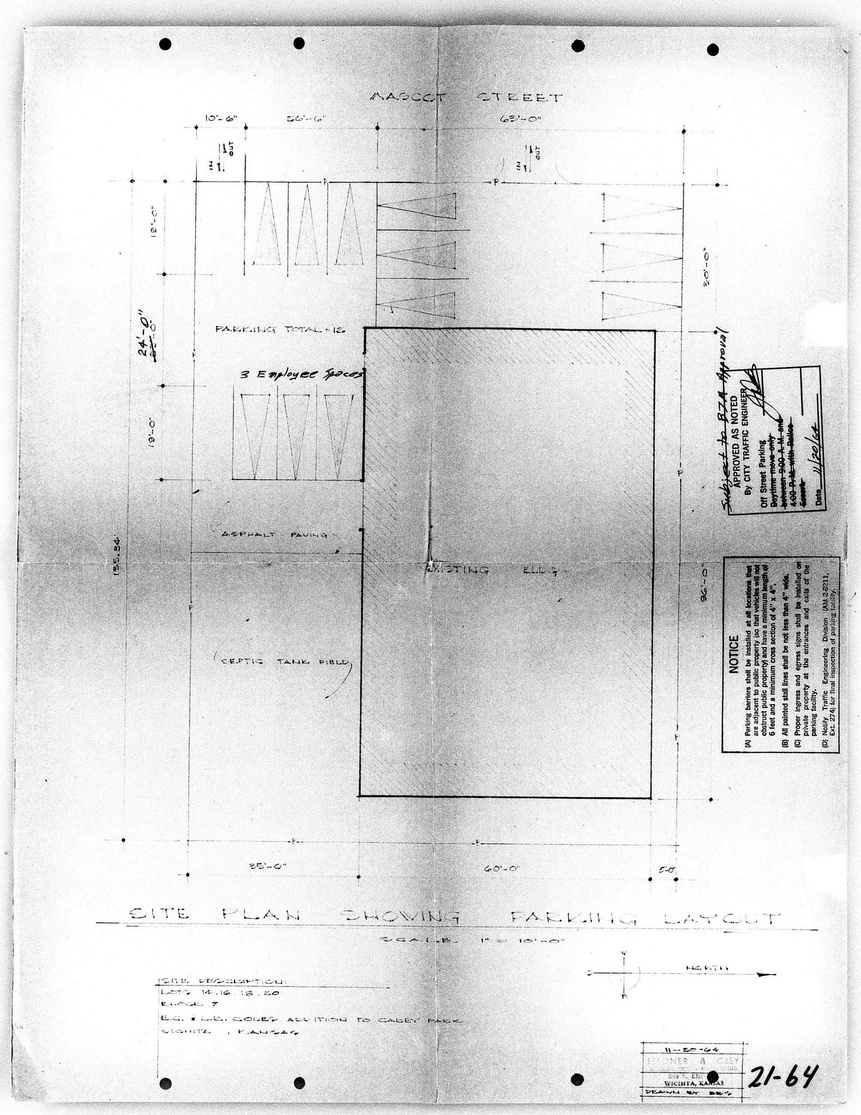

SITE PLAN SHOWING PARKING LAYOUT

SCALE: 1" = 10'-0"

LEGAL DESCRIPTION:
LOTS 14-16 18-20
BLOCK 7
WICHITA, KANSAS

11-20-64
REVISED
WICHITA, KANSAS
DRAWN BY RES

21-64

FILMED FROM THE BEST AVAILABLE COPY....