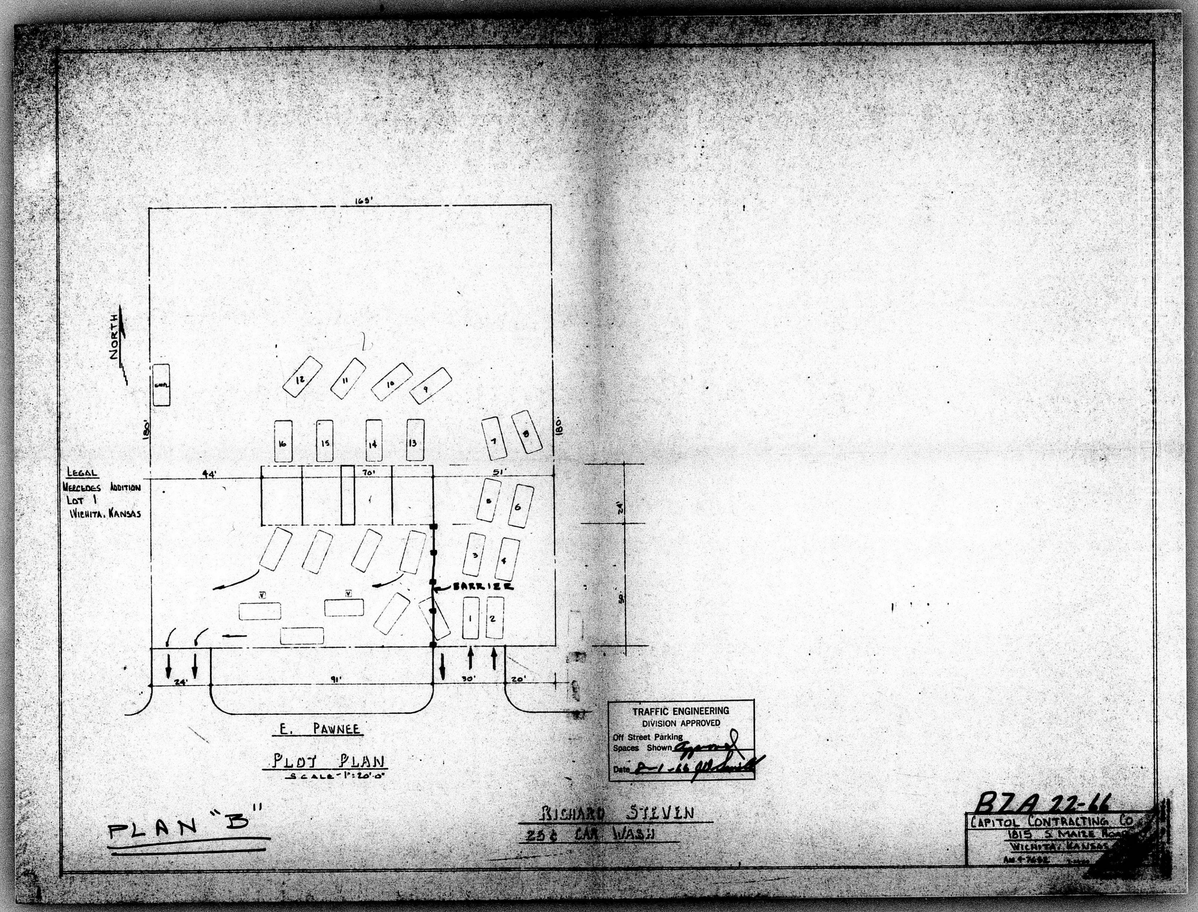

FILMED FROM THE BEST
AVAILABLE COPY

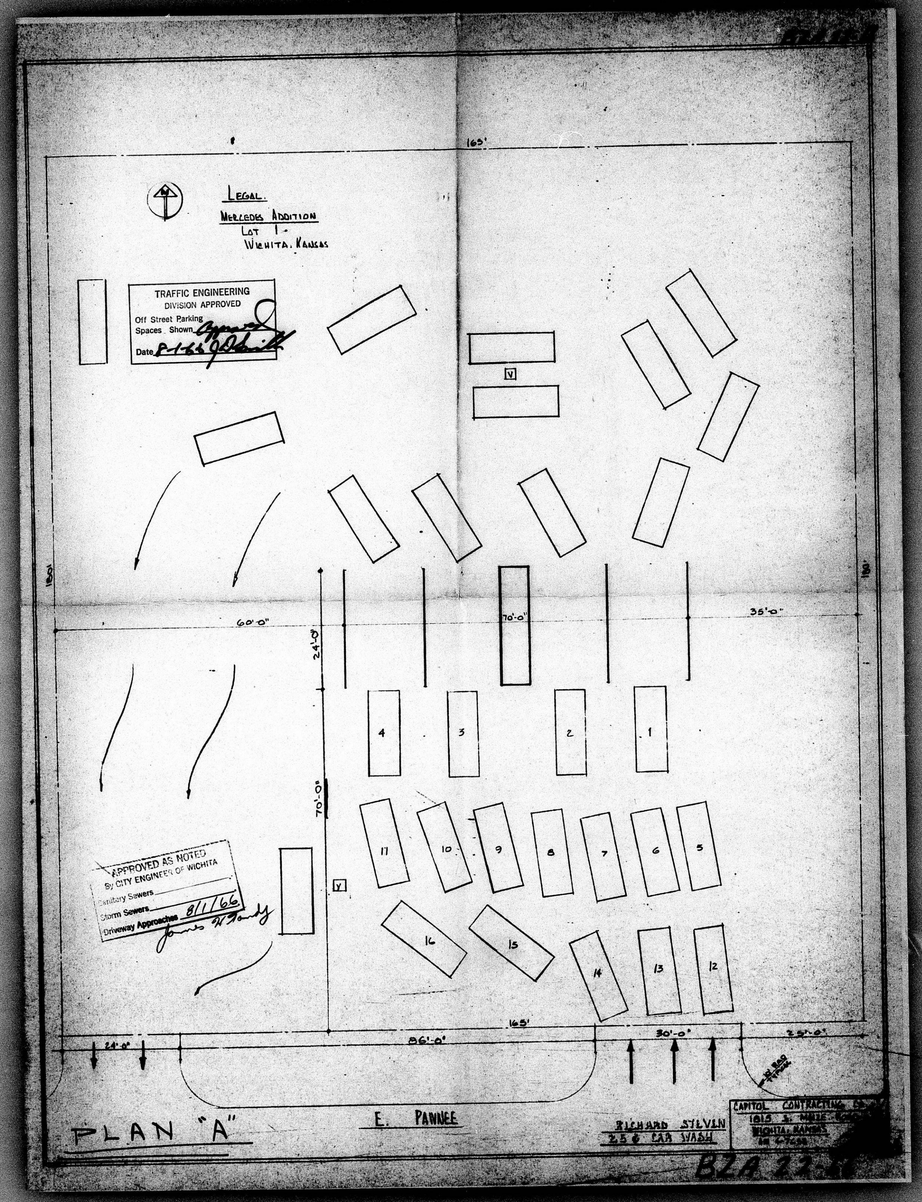

FILMED FROM THE BEST AVAILABLE COPY ....