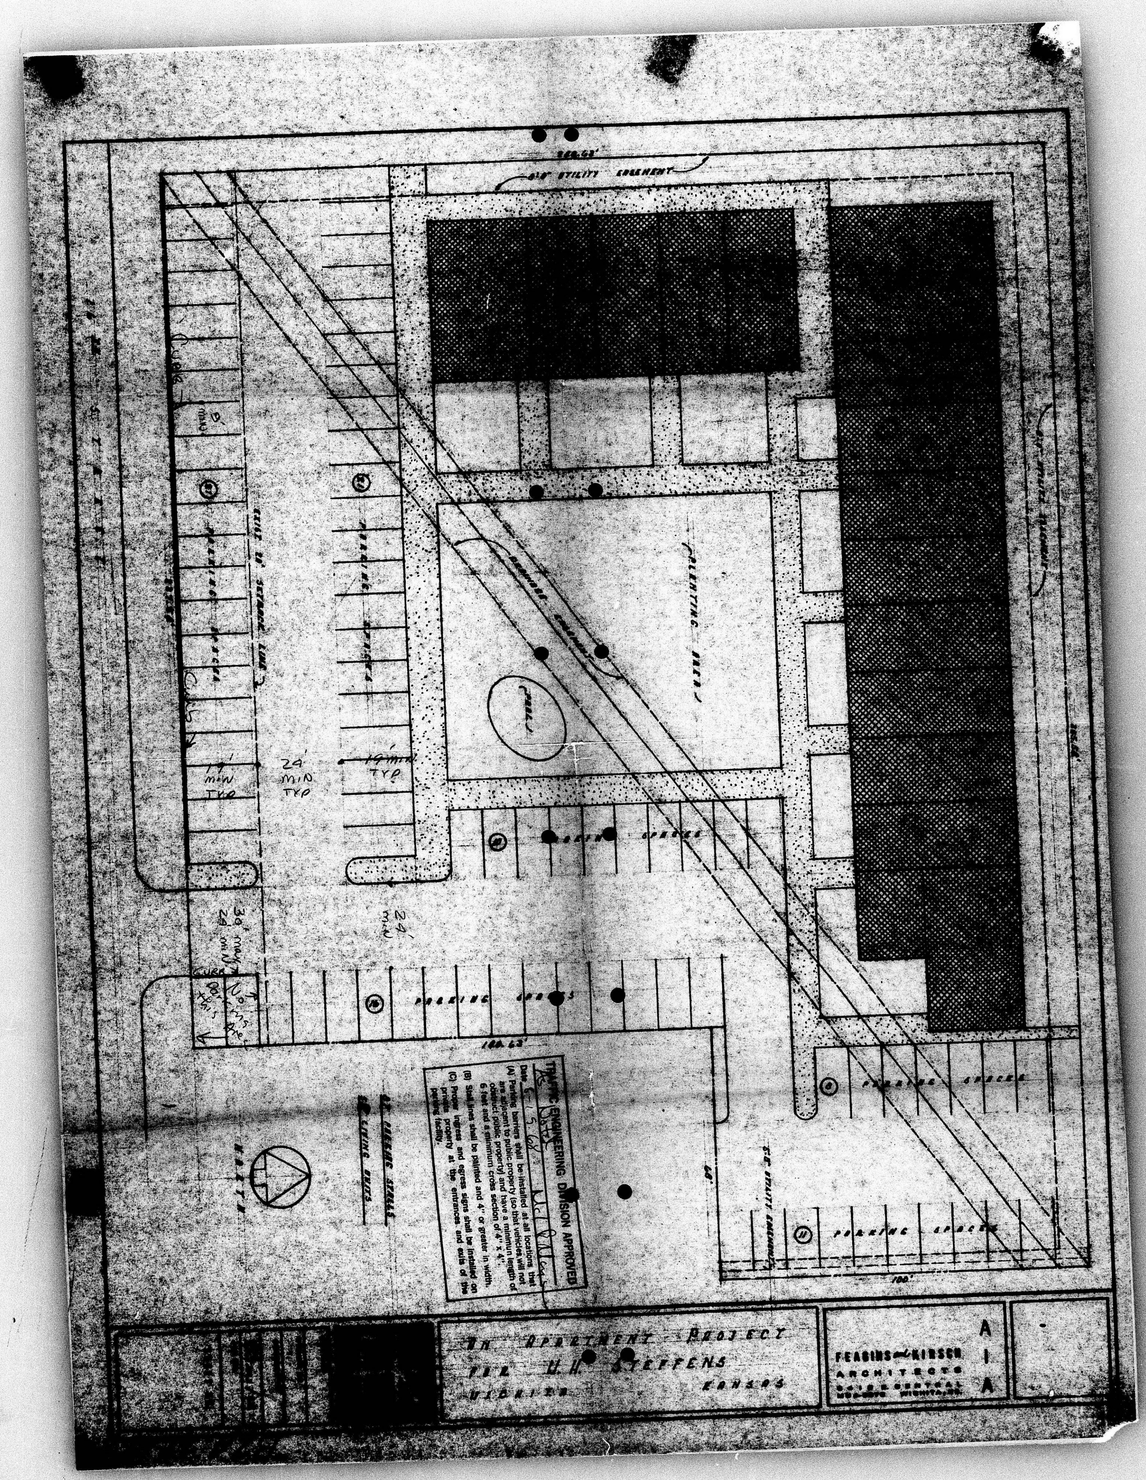
PARKING SPACES
PARKING SPACES
PARKING SPACES
PARKING SPACES
PARKING SPACES
PARKING SPACES
