


BZA 22-91

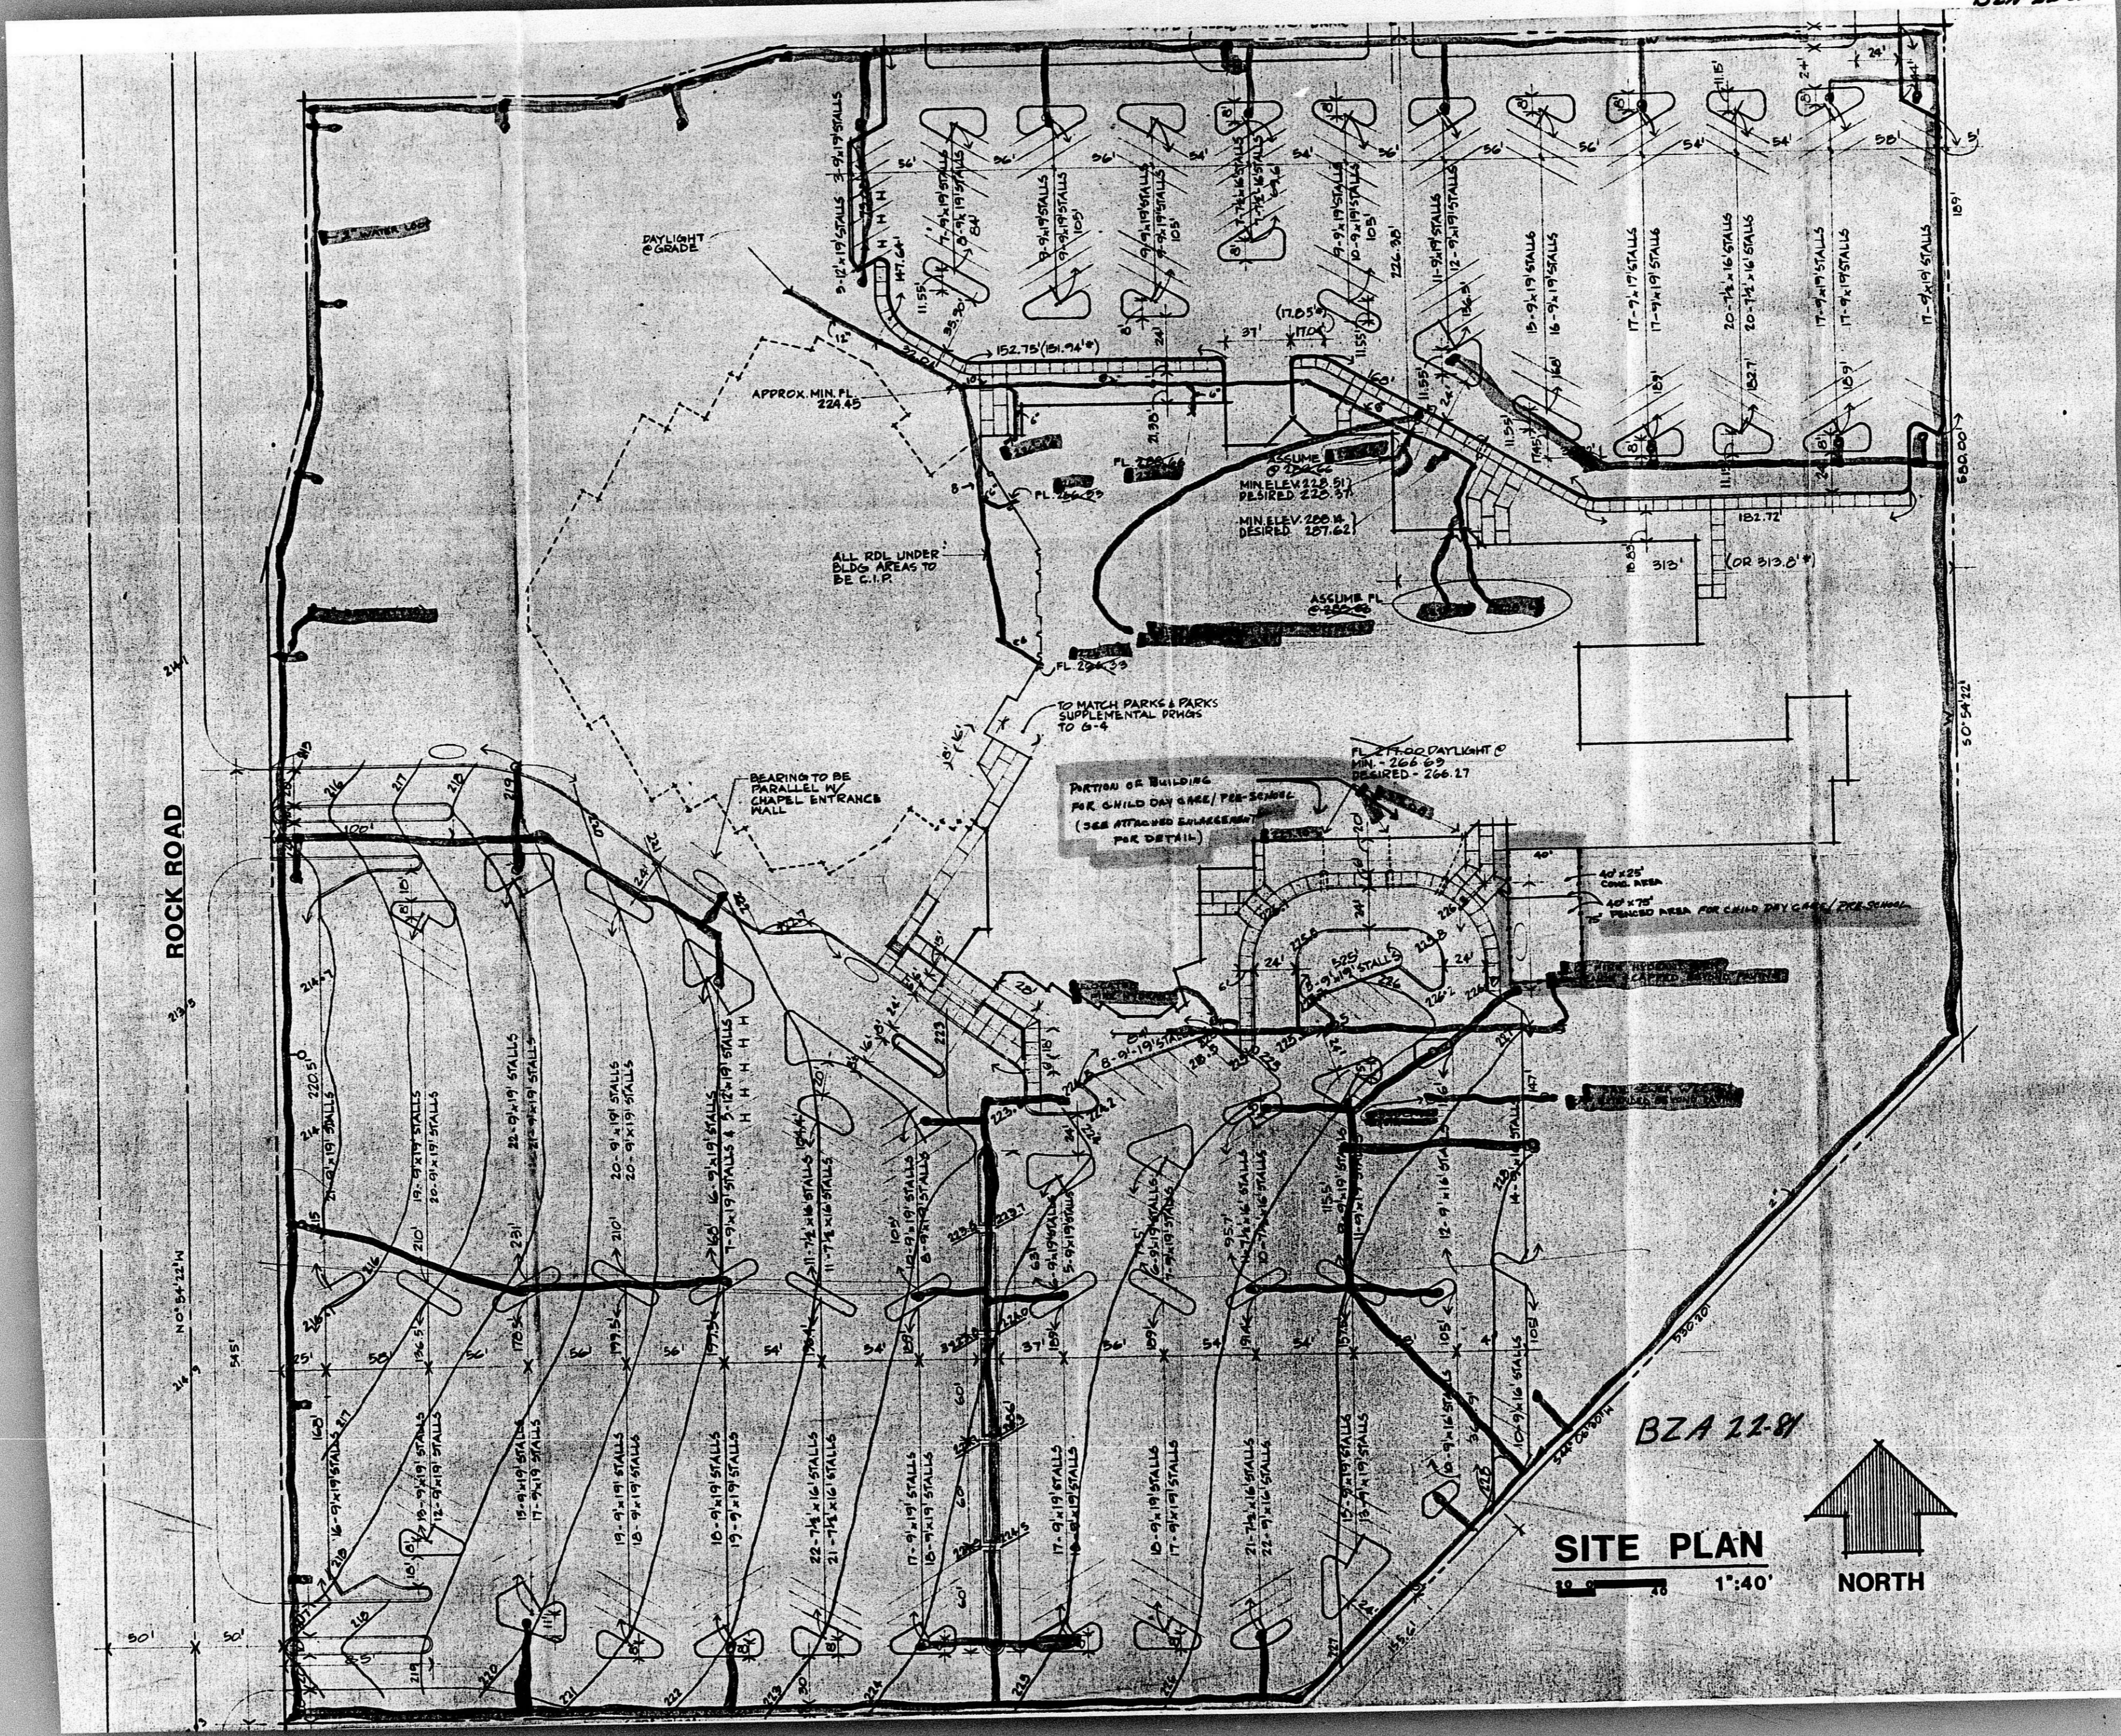

SITE PLAN

1"=40'

