


Note: Leave 25' undisturbed from E. of
hedge row and finish cut slope on 3:1

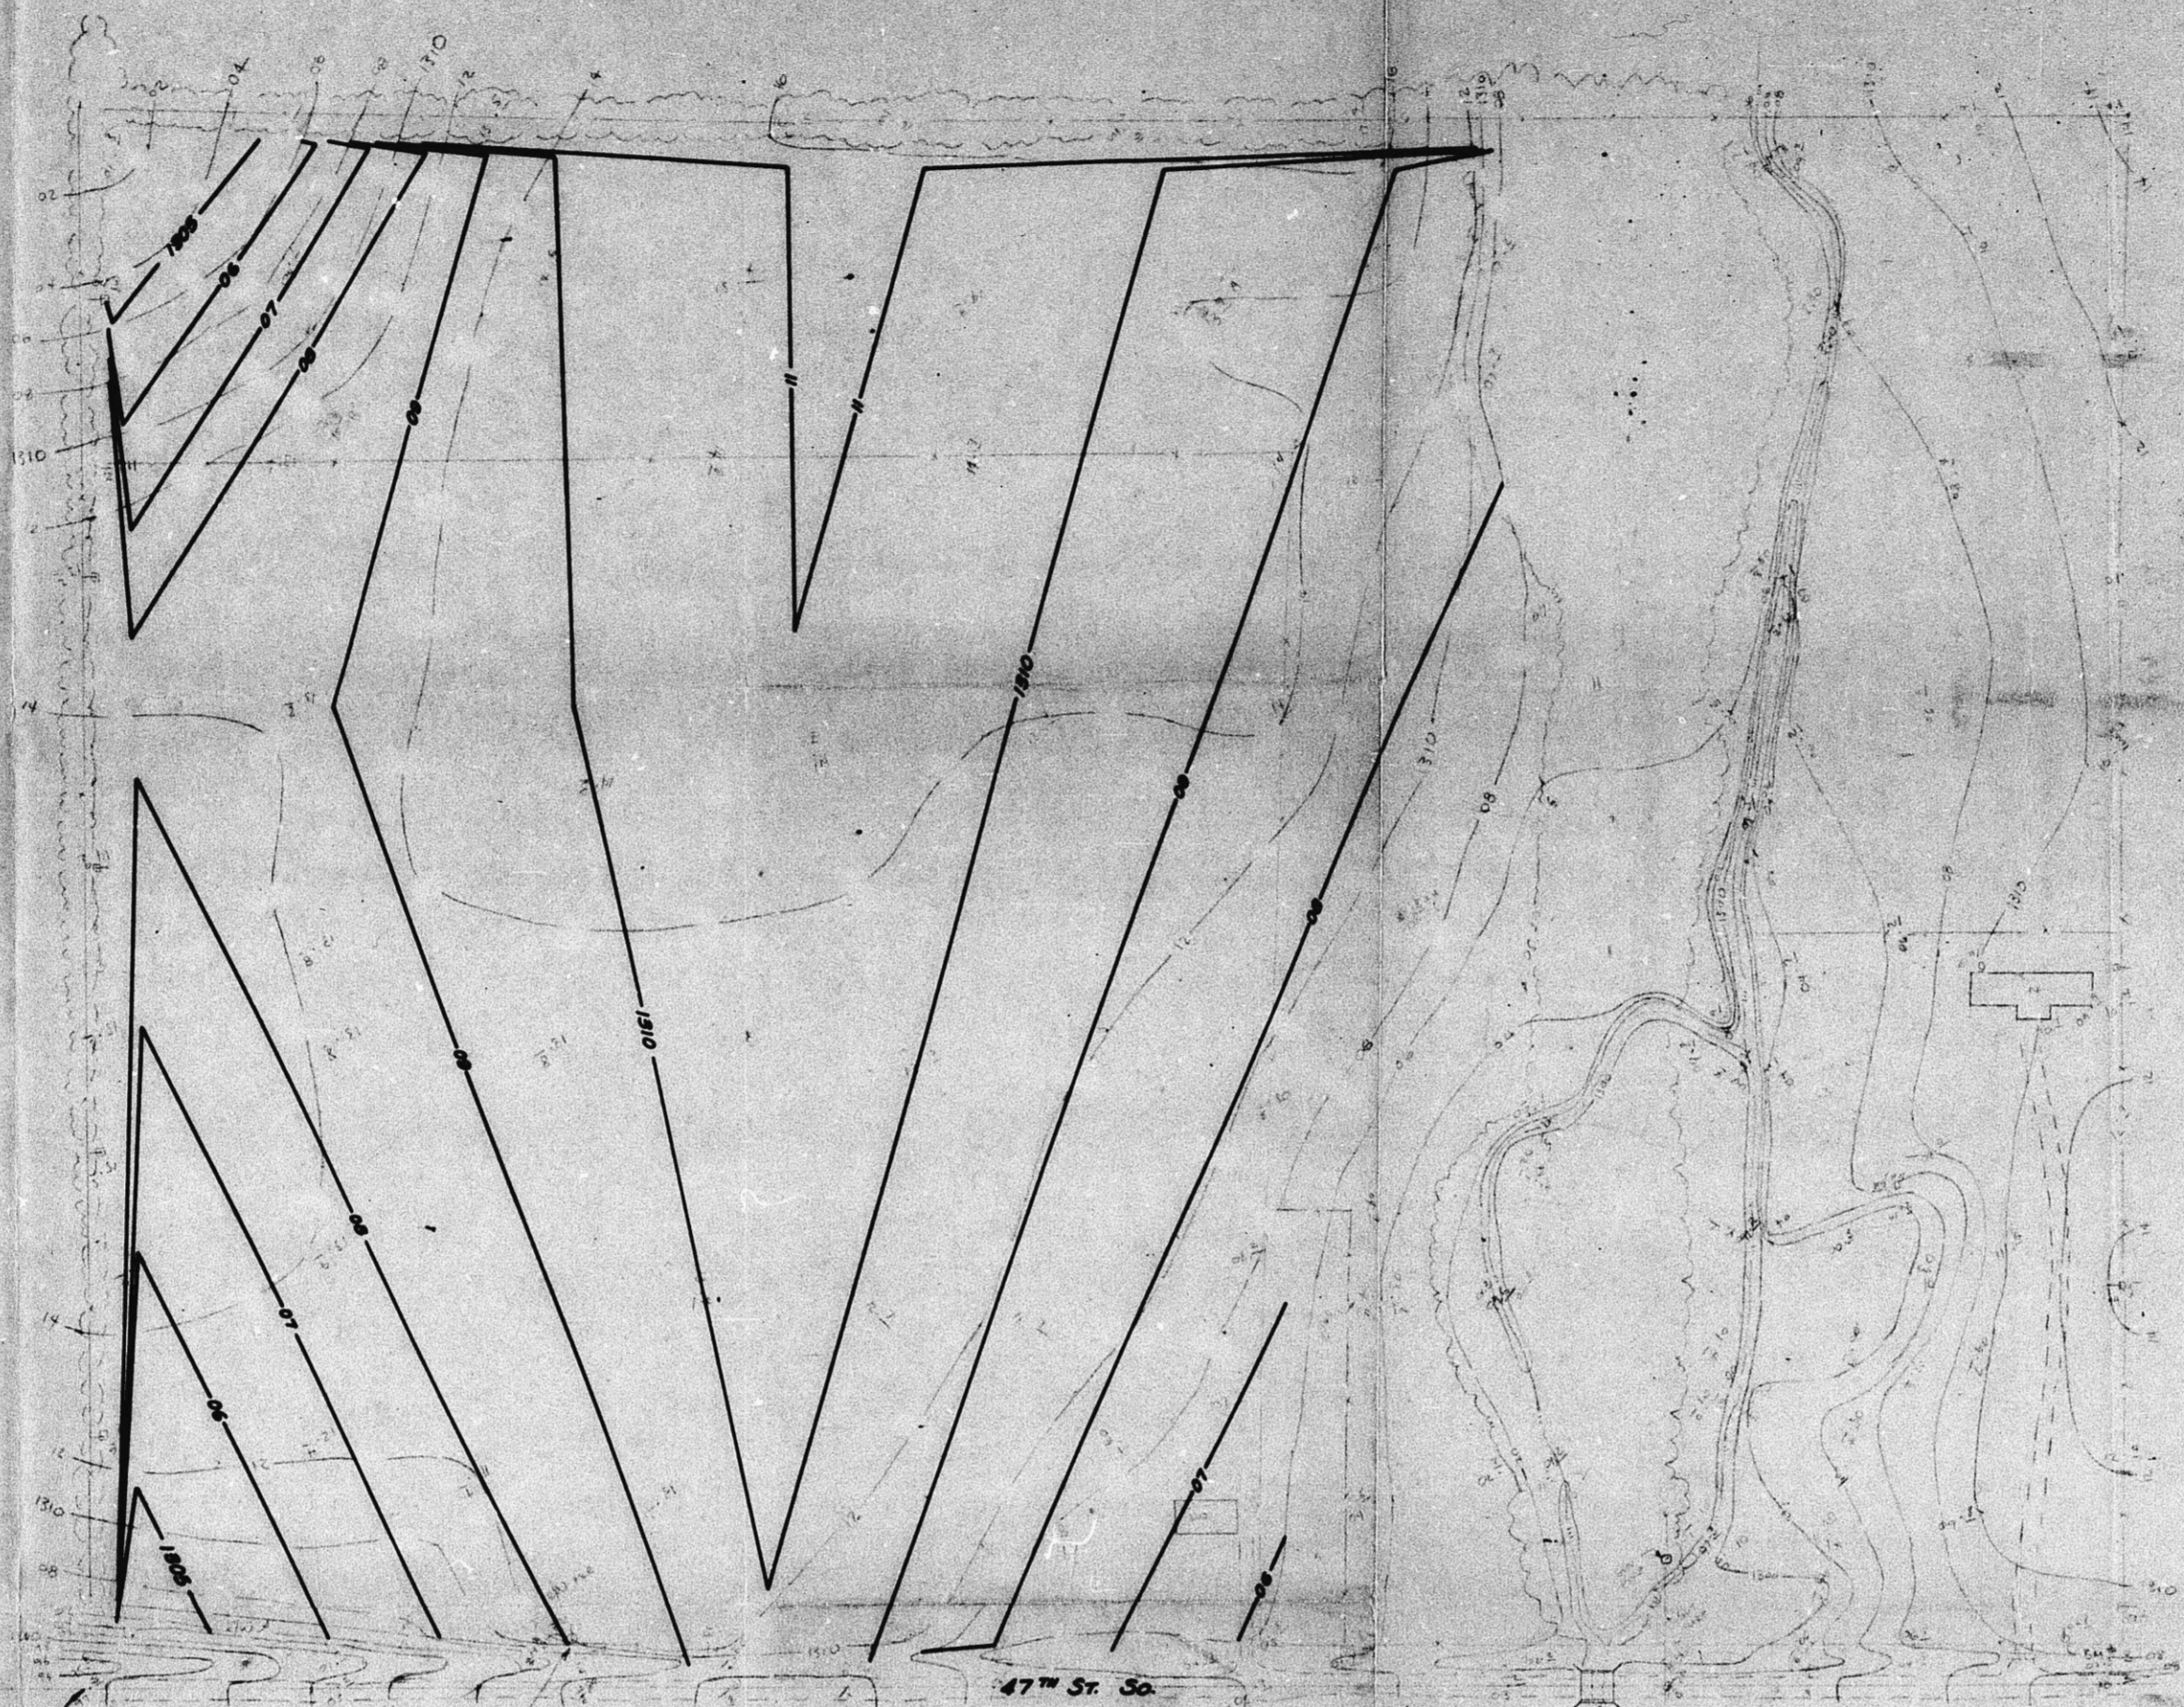

SCALE: 1"=100'

SW Cor. SE 1/4
Sec. 14, T28S, R1E

EM # 1, 26, SEC. 14, 4
TEL. P.O. EL. 1311.59

Grading Approved
MSM 5-14-76

EM # 2, 26, SEC. 14, 4
TEL. P.O. EL. 1302.29

EM # 3, 26, SEC. 14, 4
TEL. P.O. EL. 1309.20

LEGEND
Existing contours (2' intervals)
Proposed finish contours (1' intervals)



CU-187 187

ASSOCIATED MATERIALS SUPPLY COMPANY, INC.

GRADING PLAN

SW 1/4, SE 1/4 & N 300' of SE 1/4, SE 1/4 of Sec. 14, T28S, R1E

DFV DELAMATER, FREUND & SCHERER, P.A.
ENGINEERS & ARCHITECTS
WICHITA, KANSAS

DATE: May 14, 1976

PROJECT: 224-Q-101