


**OPERATIONAL PLAN**  
(REVISED)

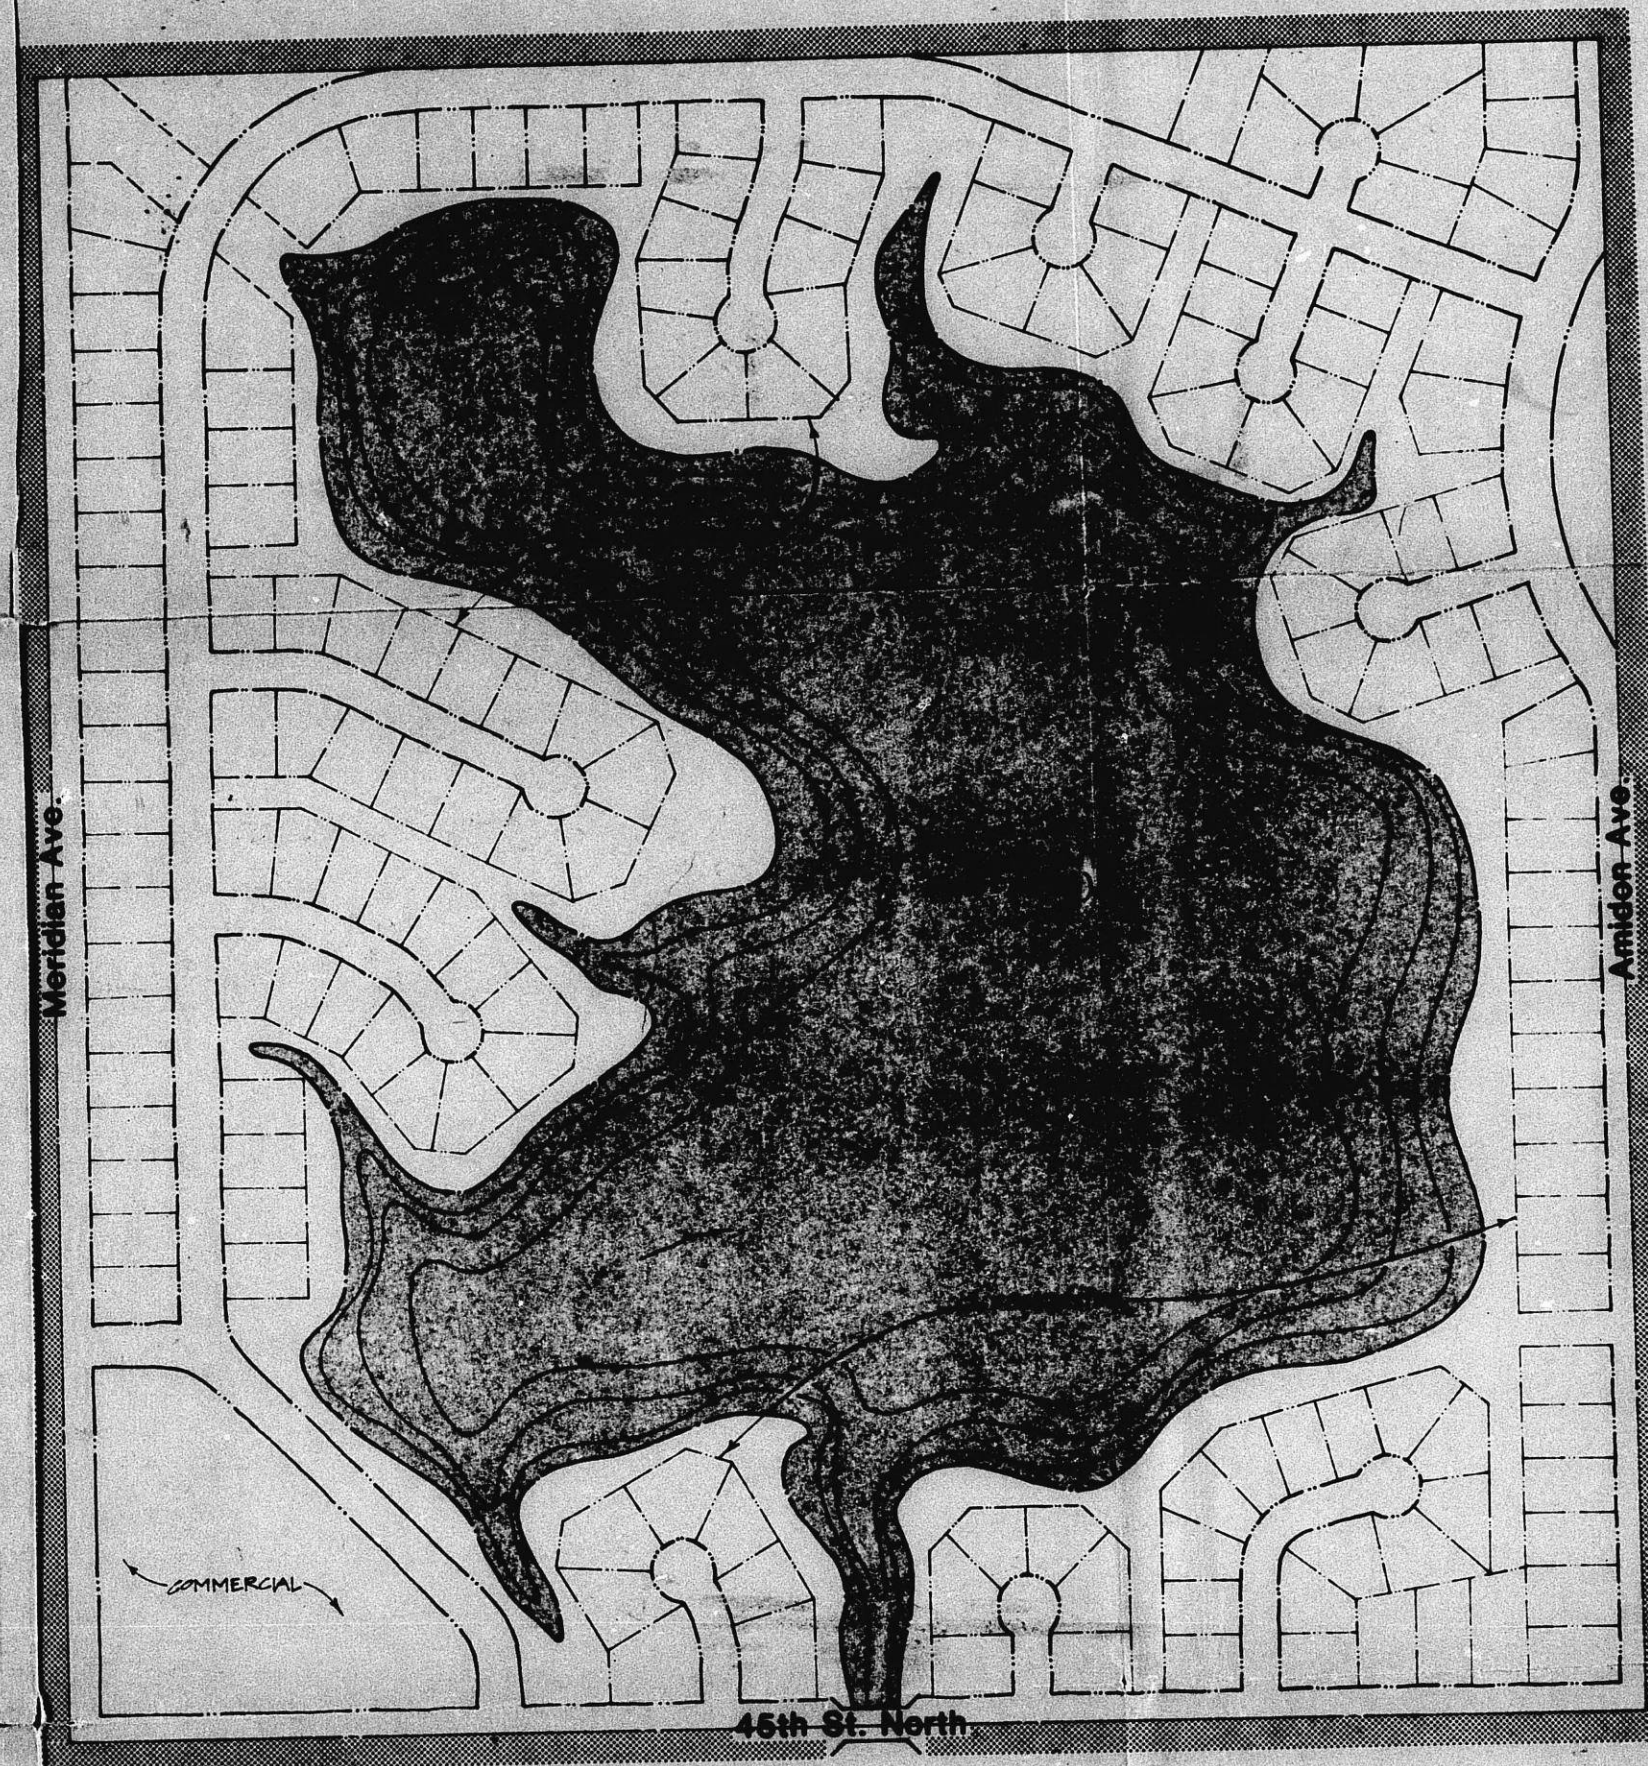


**REDEVELOPMENT PLAN**  
(REVISED)

# MILES SAND INC.

OFFICE COPY  
DO NOT REMOVE

CU-249

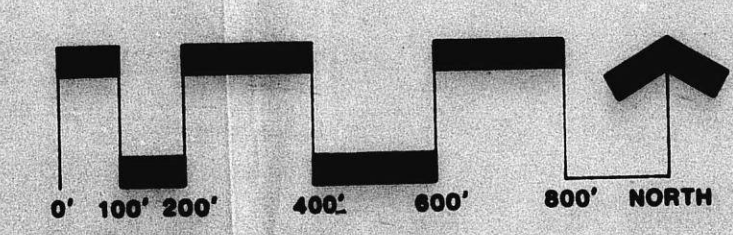

CU-249

CU-249