

COMMITTEE

~~M.A.P.C.~~

B.C.C./B.C.C.-C. *accept* 3-11-75

D-0628 - George Hall, et.al.
dedicates street r-o-w for NW
corner Rock Road and Harry.

POSTED
2-12-75

ACTION

DATE

COMMITTEE _____

M.A.T.C. _____

B.C.C./B.C.C.C. accept 3-11-75

D-0628 - George Hall, et al.
dedicates street r-o-w for NW
corner Rock Road and Harry.

DEDICATION REPORT AND PROGRESS

MAP No. 5946
 Sec. No. 30
 TWP. No. 27S
 RANGE 2E

CASE No. D - 0628


I. OFFER TO DEDICATE: street right of way
 GENERALLY LOCATED: northwest corner Rock Road and Harry

LEGALLY DESCRIBED AS:

The east ten feet of Lot 1, in Dulick-Kutescher Addition to Wichita, Sedgwick County, Kansas.

DEDICATED BY: George Hall, et.al.
 AGENT: _____
 ADDRESS: _____ PHONE _____
 PURPOSE OF DEDICATION: _____

Associated with V-0701

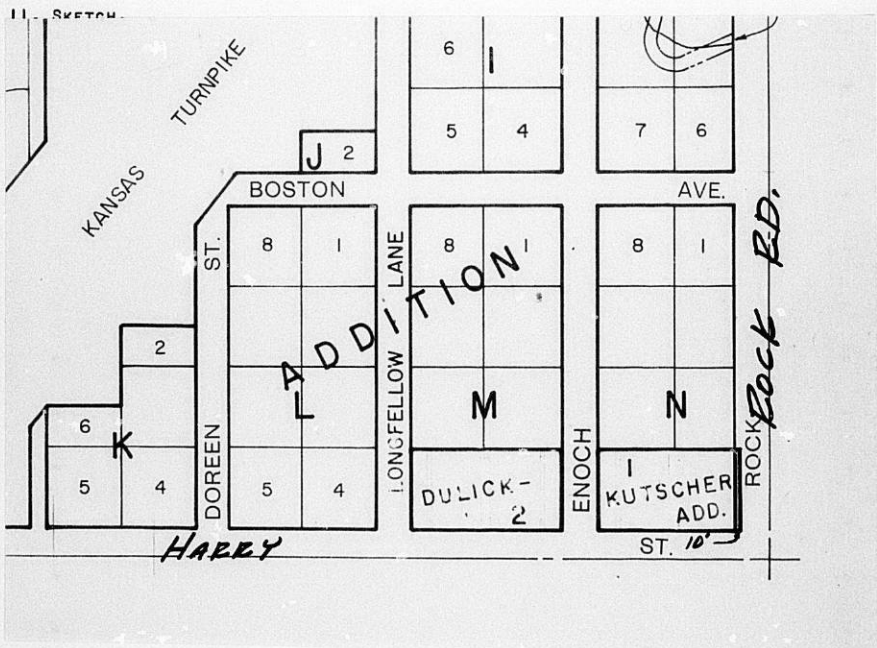

III. FILED 2-11-75
 POSTED TO ATLAS YES
 S/D COMM. ACTION not req.
 M.A.P.C. ACTION not req.
 B.C.C. ACTION 3/11/75 Acpt.
 PLACED ON RECORD _____
 CITY CLERKS No. _____

DEDICATION

KNOW ALL MEN BY THESE PRESENTS:

That for and in consideration of the sum of One Dollar (\$1.00) and other good and valuable considerations, the receipt of which is hereby acknowledged, the undersigned, George L. Hall and Velma L. Hall, husband and wife, and Daniel M. Carney and Beverly L. Carney, husband and wife, being the owners of the following described real estate in Sedgwick County, Kansas, to wit:

The East ten feet (10') of Lot 1, in Dulick-Kutescher Addition to Wichita, Sedgwick County, Kansas,

do hereby dedicate the above described real estate to the public for street purposes.

Executed this 28th day of January 19 75.

George L. Hall
GEORGE L. HALL
Velma L. Hall
VELMA L. HALL

Daniel M. Carney
DANIEL M. CARNEY
Beverly L. Carney
BEVERLY L. CARNEY

STATE OF KANSAS)
SEDGWICK COUNTY)^{ss}

BE IT REMEMBERED, that on this 28th day of January, 1975 came GEORGE L. HALL, VELMA L. HALL, DANIEL M. CARNEY and BEVERLY L. CARNEY

to me personally known to be the same person S who executed the foregoing instrument and duly acknowledged the execution of the same.

IN WITNESS WHEREOF, I have hereunto subscribed my name and affixed my official seal, the day and year last above written.

Submitted to the Wichita-Sedgwick County Metropolitan Area Planning Commission and the Board of Commissioners of the City of Wichita, Kansas, and approved by said Board of Commissioners of the City of Wichita, Kansas,
this _____,

City Clerk

Harvey Davis
Notary Public

My Commission Expires: 9/25/78