

POSTED  
9-13-77  
*[Signature]*

ACTION

	DATE
S/D COMMITTEE	<u>accept</u> 9-22-77
M.A.P.C.	<u>Accepted</u> 9-29-77
B.C.C./B.C.C.	<u>accept</u> 10-25-77

D-0786 - Hartleys Artists In Iron,  
Inc. dedicate Knight St. & Esthner  
St., at the southwest corner of  
Knight & Esthner

DEDICATION REPORT AND PROGRESS

MAP No. 5245  
 SEC. No. 36  
 TWP. No. 27  
 RANGE 1W


CASE No. D - 0786

I. OFFER TO DEDICATE: Knigh Street and Esthner Street  
 GENERALLY LOCATED: at the southwest corner of Knigh and Esthner

LEGALLY DESCRIBED AS: \_\_\_\_\_

DEDICATED BY: Hartleys Artists In Iron, Inc.  
 AGENT: \_\_\_\_\_  
 ADDRESS: \_\_\_\_\_ PHONE \_\_\_\_\_  
 PURPOSE OF DEDICATION: \_\_\_\_\_

II. SKETCH.

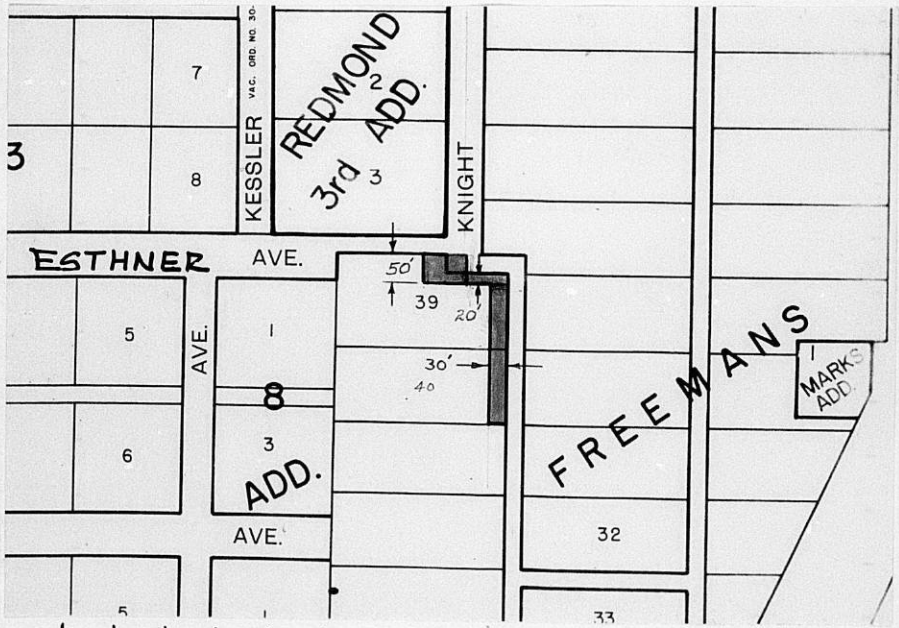

III. FILED 9-12-77  
 POSTED TO ATLAS \_\_\_\_\_  
 S/D COMM. ACTION 9-22-77 accept  
 M.A.P.C. ACTION 9-29-77 Accepted  
 B.C.C. ACTION 10-25-77 accept  
 PLACED ON RECORD \_\_\_\_\_  
 CITY CLERKS No. \_\_\_\_\_



15245  
36  
27  
1W

Knight Street

an

Esthner Street

D-0786

DEDICATION

KNOW ALL MEN BY THESE PRESENTS:

That for and in consideration of the sum of One Dollar (\$1.00) and other good and valuable considerations, the receipt of which is hereby acknowledged, the undersigned, HARTLEY'S ARTISTS IN  
IRON INC

being the owner of the following described real estate in Sedgwick County, Kansas, to wit:

Knight Street

The east thirty (30) feet of the south one hundred twelve (112) feet of Lot 39 and the east thirty (30) feet of Lot 40, Freeman's Addition.

Esthner Street

The north twenty (20) feet of the east eighty-one and five tenths (81.5) feet & the north fifty (50) feet of the east eighty-nine and five tenths (89.5) feet of the west two hundred thirty-three and five tenths (233.5) feet of Lot 39, Freeman's Addition.

*S.W. corner of Knight & Esthner*

do hereby dedicate the above described real estate to the public for street purposes.

Executed this 12th day of September, 19 77.

*Donald L. Hartley*  
*Sidney S. Landwehr Sec.*

STATE OF KANSAS )  
SEDGWICK COUNTY ) SS

BE IT REMEMBERED, that on this 12th day of September 19 77, before me a Notary Public in and for the said County and State came Donald L. Hartley and Sidney S. Landwehr

to me personally known to be the same persons who executed the foregoing instrument and duly acknowledged the execution of the same.

IN WITNESS WHEREOF, I have hereunto subscribed my name and affixed by Sidney S. Landwehr the day and year last above written.



*Donald L. Hartley*  
Notary Public

My Commission Expires: October 2, 1979