



**Wichita-Sedgwick County
Metropolitan Area
Planning Department**

May 27, 2025

Geoffrey Hurst
4401 E. Falcon St.
Wichita, KS 67220

All Size Shed
Attn: Adam Wolfe
8231 W. Kellogg Dr.
Wichita, KS 67209

Re: **BZA2025-00035:** Administrative Adjustment in the City to reduce the west interior side setback from 6 feet to 4 feet (33 percent for an area less than 300 square feet) for an accessory structure, on property zoned SF-5 Single-Family Residential District, generally located within one-quarter mile west of North Oliver Avenue, and within one-half mile south of East 45th Street North (4401 East Falcon St.).

Legal Description: Lot 55, Block A, Eagles Landing at North Oliver 2nd Addition, Wichita, Sedgwick County, Kansas.

Dear Applicant,

We have reviewed your request for a Zoning Adjustment to reduce the west interior side setback from 6 feet to 4 feet (33 percent) on the aforementioned property in order to build an accessory structure (shed). The proposed shed would be 10 feet by 12 feet, and the area of encroachment would be 20 square feet (2 feet x 10 feet).

Section V-1.2.a of the Unified Zoning Code ("UZC") allows reducing the minimum interior side setback (required by the property development standards of the zoning district) by up to 50 percent (for an area less than 300 square feet). This adjustment is permissible when the provisions of this section and the Zoning Adjustment Criteria of Section V-1.6 are met. We find that the reduction of the setback as proposed meets the provisions of Section V-1.2.a and the four criteria required by Section V-1.6 as set out below:

- 1) Impact on safety and convenience of vehicular and pedestrian circulation: The proposed reduction of the west interior side setback from 6 feet to 4 feet will have no impact on the safety and convenience of vehicular and pedestrian circulation in the right-of-way.
- 2) Impact on existing uses in surrounding areas: There will be no impact on the existing uses. The surrounding properties are all zoned SF-5 Single-Family Residential District and developed with single-family dwellings. The proposed shed would be to the side of the exiting dwelling and would be at least 10 feet from the dwelling to the west. It is not likely to have any significant negative impacts on nearby uses.
- 3) Compatibility with existing or permitted uses on abutting sites: The surrounding properties are all zoned SF-5 Single-Family Residential District and developed with single-family

dwellings. An accessory structure (shed) of the proposed size is a compatible structure for the development in the area.

- 4) Effect on public health, safety, or welfare: There will be no negative impact on the public health, safety, or welfare, nor will properties or improvements in the vicinity be materially injured.


Our signatures below indicate that the Zoning Adjustment to reduce the west interior setback from 6 feet to 4 feet is hereby GRANTED, subject to the following conditions:

- 1) The site shall be developed in general conformance with the approved site plan.
- 2) The applicant shall obtain a building permit within one year of the Administrative Adjustment approval. The site shall conform to all codes including but not limited to zoning, building, health, and fire.
- 3) The setback reduction shall apply only to the 4-foot west interior side setback as illustrated on the approved site plan. All other structures or additions on the subject property shall conform to the setbacks permitted by the Unified Zoning Code unless a separate Zoning Adjustment or Variance is granted.
- 4) If the Zoning Administrator finds that there is a violation of any of the conditions of the Zoning Adjustment, the Zoning Administrator, in addition to enforcing the other remedies set forth in the Unified Zoning Code, may, with the concurrence of the Planning Director, declare that the Zoning Adjustment is null and void.

The "Development Application" sign should now be removed from the property.




Scott Wadle, Director
Metropolitan Area Planning Department

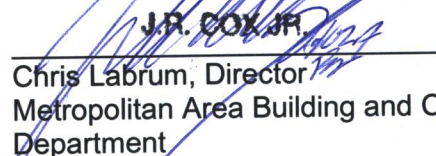

Chris Labrum, Director
Metropolitan Area Building and Construction
Department

cc: MABCD
Brandon Johnson, City Council District I
Cameron Jackson, CSR District I

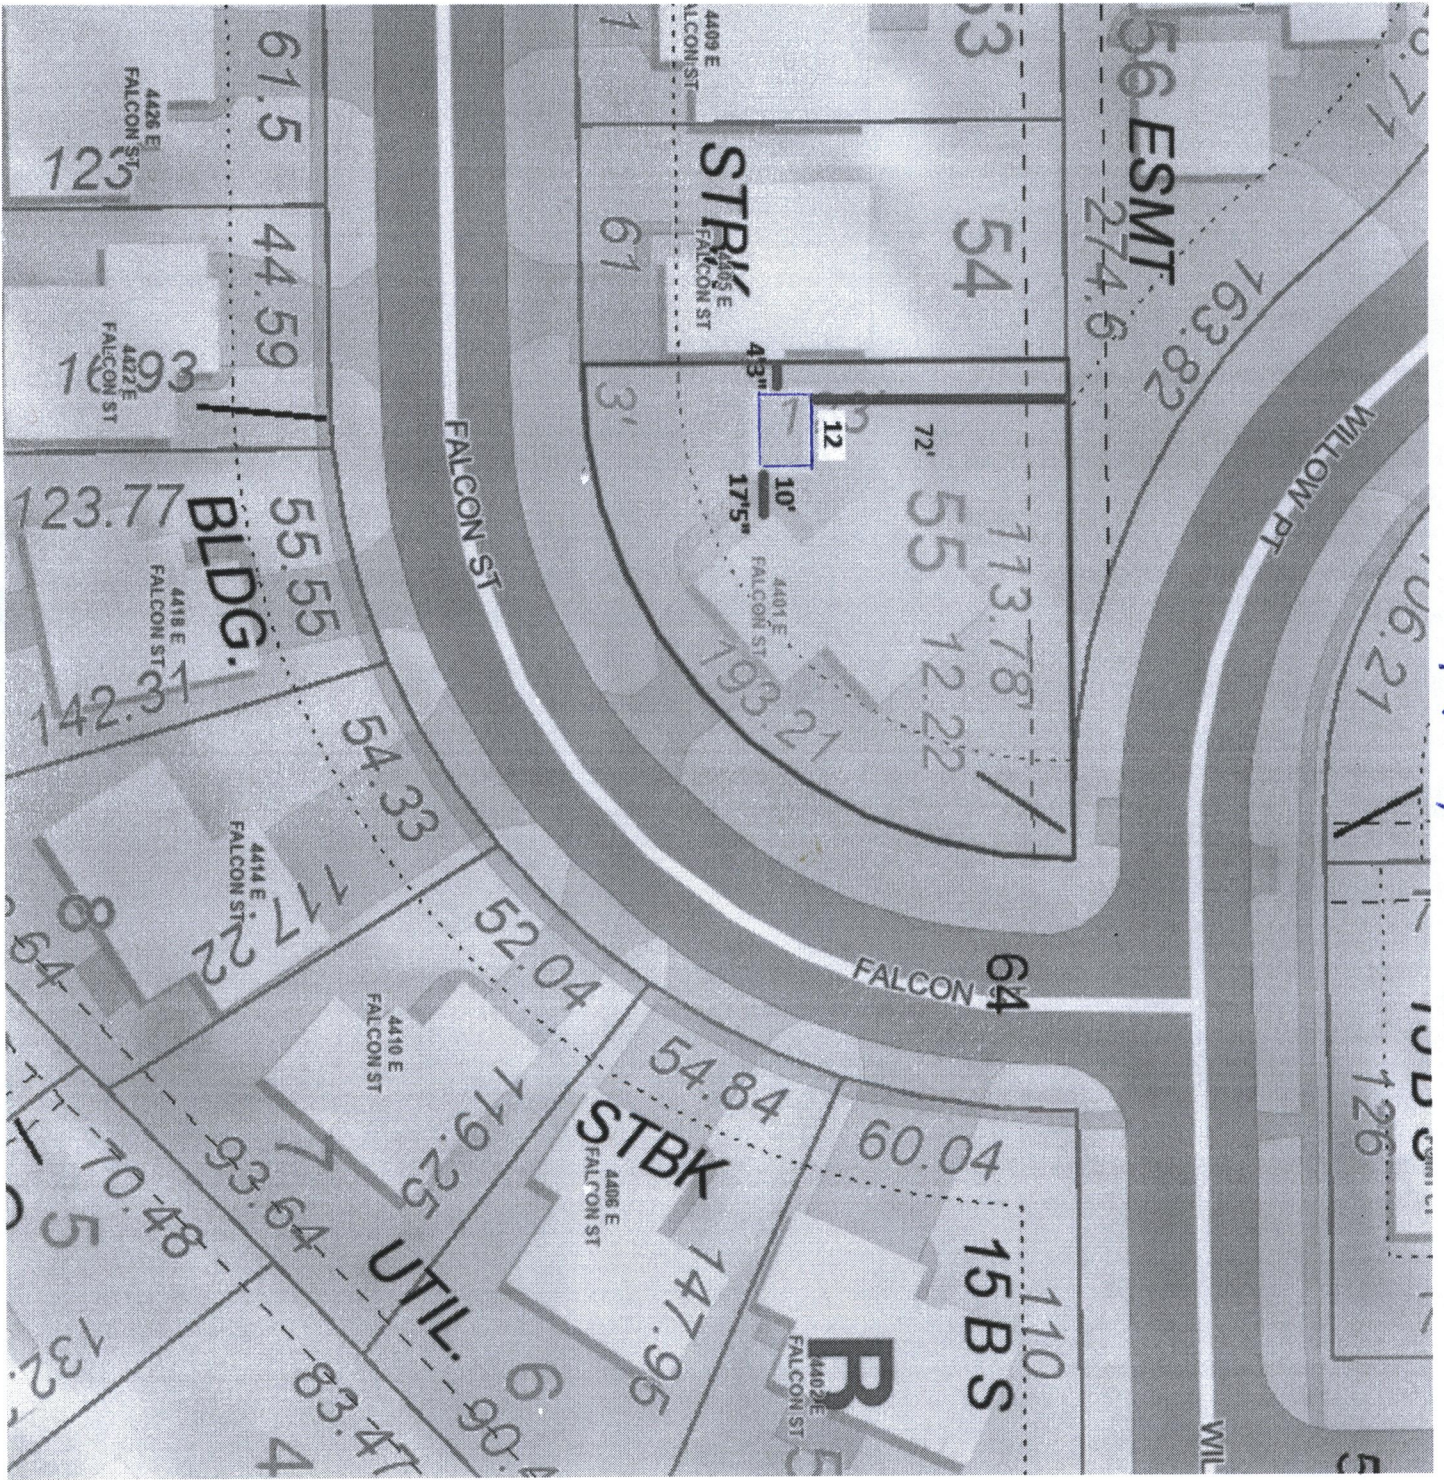

SITE PLAN

APPROVED 5/27/25 BY *[Signature]*
 BZA25-35