

MABCD REVIEWER:

GENERAL LANDSCAPE NOTES


- LANDSCAPE CONTRACTOR IS TO VERIFY THE LOCATION OF ALL UNDERGROUND UTILITIES (INCLUDING THOSE INDICATED ON THE PLAN) PRIOR TO INSTALLATION OF PLANT MATERIAL. UTILITIES CAN BE FLAGGED BY CALLING 811, OR 1-800-344-7233, OR ONLINE AT www.kansasonecall.com. DAMAGE TO UTILITIES SHALL BE AVOIDED DURING THE COURSE OF WORK. THE LANDSCAPE CONTRACTOR IS RESPONSIBLE FOR REPAIRING ANY AND ALL DAMAGE TO UTILITIES, STRUCTURES, SITE APPURTENANCES, ETC. WHICH OCCUR AS A RESULT OF THE LANDSCAPE CONSTRUCTION.
- PLANTING DATES FOR PLANT MATERIAL SHALL BE DURING THE MONTHS BETWEEN FEB. 15TH AND MAY 31ST OR SEPT. 15TH AND DEC. 15. PLANTING SHALL ONLY BE CONDUCTED WHEN THE GROUND IS NOT FROZEN, SNOW-COVERED, OR IN AN OTHERWISE UNSUITABLE CONDITION FOR PLANTING. DEVIATION FROM THE ABOVE PLANTING DATES WILL ONLY BE PERMITTED WITH APPROVAL FROM THE OWNER'S REPRESENTATIVE.
- MULCHED LANDSCAPE BED EDGES SHALL BE LINED WITH PRO-STEEL EDGING (OR APPROVED EQUAL).
- INSTALL 4" MIN. DEPTH FINE-SHREDDED, DARK HARDWOOD MULCH IN ALL PLANTING BED AREAS.
- ALL PLANTS SHALL CONFORM TO ANSI Z60.1 FOR SIZE AND QUALITY STANDARDS.
- LABEL EACH PLANT WITH A SECURELY ATTACHED, WATERPROOF TAG BEARING LEGIBLE DESIGNATION OF BOTH BOTANICAL AND COMMON NAME.
- ALL PLANTS MUST BE HEALTHY, VIGOROUS MATERIAL; FREE OF PEST AND DISEASES.
- ALL LANDSCAPE PLANTS SHALL BE GUARANTEED FOR ONE YEAR FOLLOWING INITIAL ACCEPTANCE. DEAD OR DEFICIENT PLANTINGS SHALL BE ACCEPTABLY REPLACED, IN PROPER PLANTING SEASON, ONE TIME AT NO COST TO THE OWNER.

PLANT SCHEDULE

KEY	QTY	COMMON NAME	BOTANICAL NAME	SIZE & METHOD OF HANDLING	NOTES
SHRUBS					
CGY	4	'COLOR GUARD' YUCCA	YUCCA FILAMENTOSA 'COLOR GUARD'	#3 CONT.	
YUC	6	RED YUCCA	HESPERALOE PARVIFLORA 'BRAKE LIGHTS'	#3 CONT.	
TURF GRASS					
	7,440 SF	BERMUDA GRASS 'MONACO'	CYNODON DACTYLON 'MONACO'	SEED	SEEDING RATE = 4 LBS / 1,000 SF


LANDSCAPE ORDINANCE CALCULATIONS

FRONTAGE OF SITE = 75'. DEPTH OF LOT = 220'
 SQUARE FOOTAGE FACTOR = 10 SQ. FT. PER LINEAR FOOT
 REQUIRED LANDSCAPED STREET YARD = 75 x 10 = 750 SQ. FT.
 LANDSCAPED STREET YARD PROVIDED = 2,792 SQ. FT.
 STREET YARD TREES REQUIRED = 750/500 = 1.5 = 2 TREES
 TREES PROVIDED = (1) EXISTING TREE, (10) SHRUBS = 2 TREE EQUIVALENT

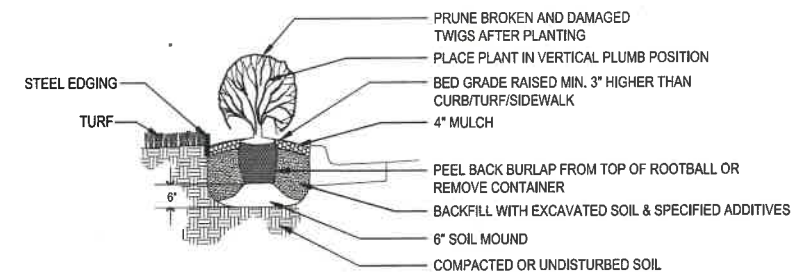

SHRUB PLANTING DETAIL
NOT TO SCALE

Handwritten: PUD #146
LANDSCAPE PLAN
Handwritten: APPROVED 5/4/26 *Signature*

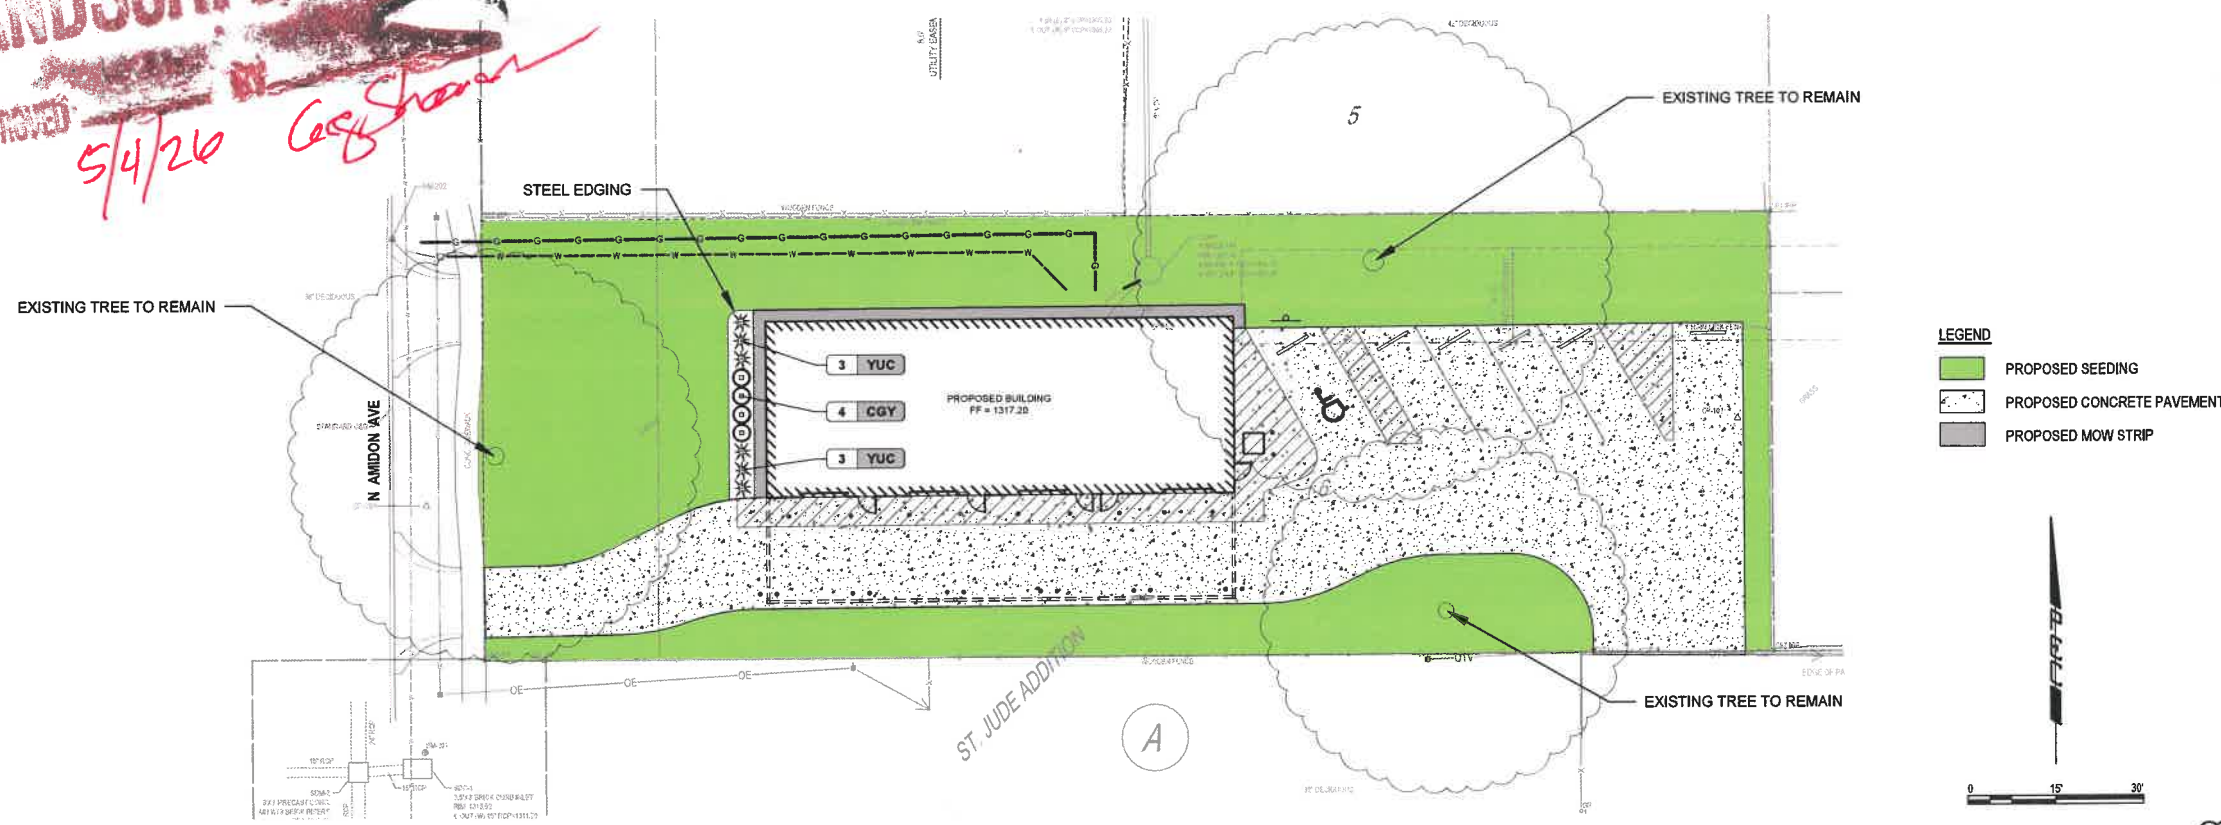

LEGEND
 PROPOSED SEEDING
 PROPOSED CONCRETE PAVEMENT
 PROPOSED MOW STRIP



NEW SHEET

THE LORD'S PANTRY
ST. JUDE CATHOLIC CHURCH
 3142 N AMIDON AVE.
 WICHITA, KS 67204

Issue	Comments	Date
1	MABCD COMMENTS	04/22/2026

JOB NO. 251185-000
 DATE 31 MARCH 2026
 PM DSB
 DESIGNED BY RKO
 DRAWN BY RKO
 CHECKED BY DML
 LANDSCAPE PLAN
LS101