

6' fencing along Greenwich, north property & east property adjacent to Minneha Township. No hurricane slats on 6' fencing.

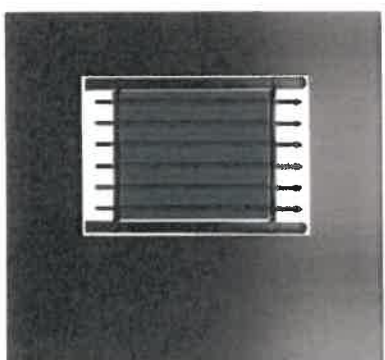
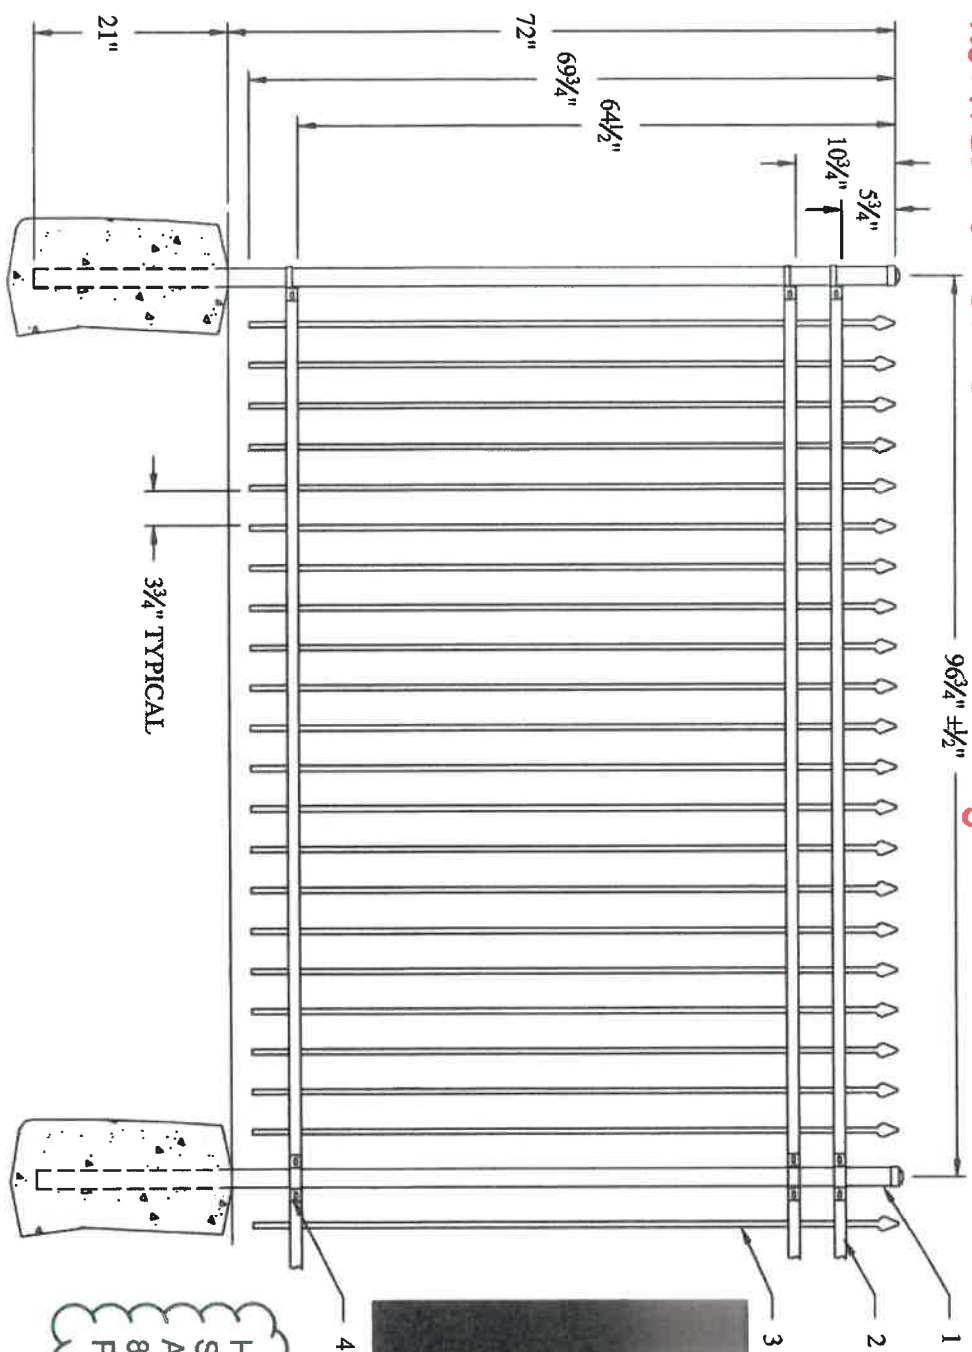


Photo of hurricane

HURRICANE SLATS TO BE ADDED ON ALL 8FT FENCE PANELS.

SITE PLAN

#	QTY.	DESCRIPTION
1	2	2" SQ POST

APPROVED 5/15/16 BY [Signature]


WUPDP 229 3 of 4

PROPRIETARY INFORMATION
This drawing is the property of AMERISTAR, Inc. Or any manufacturer in whole or in part for the



1555 N. Midway
Tulsa, OK 74116
1-888-533-2422
www.ameristar.com

TITLE: MONTAGE PANEL CLASSIC 3R EXT 6T 8W

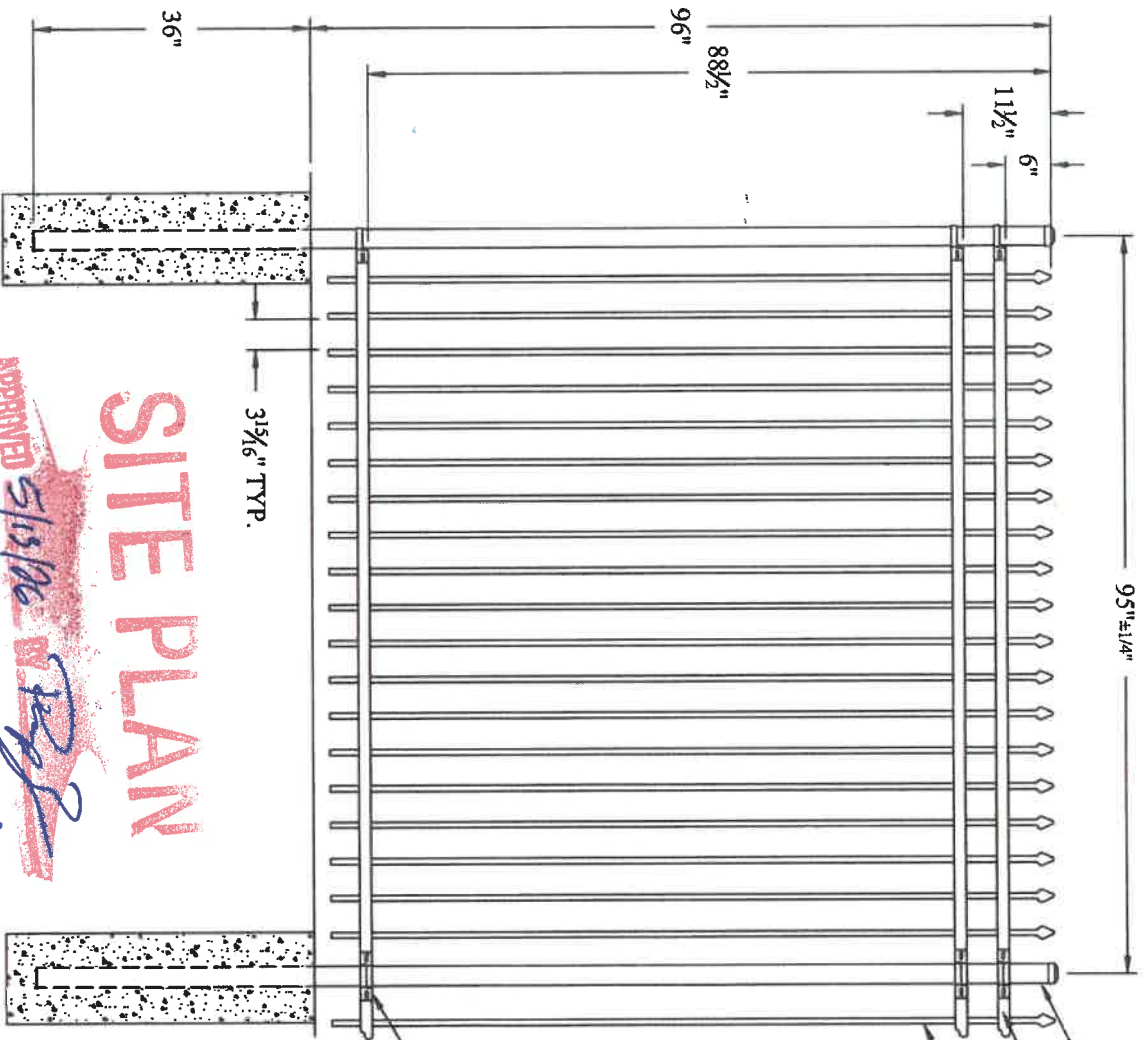

SITE PLAN

APPROVED

5/13/06

4/9/04

CWP/DP/209

HURRICAN SLATS TO BE INSTALLED ON ALL 8FT FENCING.

To be installed along east side adjacent to residential - includes hurricane slats.

PROPRIETARY INFORMATION
This drawing is the proprietary property of AMERISTAR, Tulsa, OK and must not be



1555 N. Midway
Tulsa, OK 74116