



**Wichita-Sedgwick County
Metropolitan Area
Planning Department**

June 8, 2026

Delores J. & Joseph K. Koury
3117 N. Ridge Port St.
Wichita, KS 67205

RE: CON2026-00063 – Administrative Permit to allow a Short Term Rental in the City on property zoned SF-5 Single Family Residential District, generally located approximately one quarter mile north of the corner of West Central Avenue and North Tyler Road (8801 West Bekemeyer Lane).

Legal Description: Lot 11, Block 5, Western Gardens Addition, Wichita, Sedgwick County, Kansas.

We reviewed your Administrative Permit request to permit a non-owner-occupied Short-Term Rental in the City in the SF-5 Single-Family Residential District for the above-described property. Section V-L.2.b. of the Unified Zoning Code (UZC) allows a Short Term Rental in the City to be approved by Administrative Permit subject to Supplementary Use Regulations found in Section III-D.6.qq of the UZC, provided that the application is not protested by greater than 50 percent of the eligible properties that either touch or are across the street or alley from the subject property.

No protests were received against this case.

Therefore, the Administrative Permit to permit a Short Term Rental in the City is hereby **GRANTED** per the previously signed approval letter and subject to the conditions contained in that letter.

Sincerely,

A handwritten signature in blue ink, appearing to read 'Samuel Deetz'.

Samuel Deetz
Current Plans, Associate Planner

cc: MABCD
J.V. Johnston, CM District V, Teresa Veazey, CSR District V



**Wichita-Sedgwick County
Metropolitan Area
Planning Department**

May 22, 2026

Delores J. & Joseph K. Koury
3117 N. Ridge Port St.
Wichita, KS 67205

RE: CON2026-00063 – Administrative Permit to allow a Short Term Rental in the City on property zoned SF-5 Single Family Residential District, generally located approximately one quarter mile north of the corner of West Central Avenue and North Tyler Road (8801 West Bekemeyer Lane).

Legal Description: Lot 11, Block 5, Western Gardens Addition, Wichita, Sedgwick County, Kansas.

Dear Applicants,

We reviewed your Administrative Permit request to permit a non-owner occupied Short Term Rental in the City in the SF-5 Single-Family Residential District for the above-described property.

Section V-L.2.b. of the Unified Zoning Code (UZC) allows a Short Term Rental in the City application to be approved by Administrative Permit subject to Supplementary Use Regulations found in Section III-D.6.qq of the UZC. An approval can be appealed and the Administrative Permit application denied if it is protested by greater than 50 percent of the eligible properties that either touch or are across the street or alley from the subject property.


Below is information regarding the protest procedure.

- Protests must be in writing.
- Protests must include the names and signatures of all owners on record for the property protesting.
- Protests must be submitted to the Metropolitan Area Planning Department. This can be done by mailing or delivering them to 271 West 3rd Street, 2nd Floor, Wichita, KS, 67202 and/or emailing them to planning@wichita.gov. Emailed protests must include the handwritten (not typed) signatures of all owners on record for the property protesting.
- Protests must be received within 2 weeks of the date of this approval letter. The valid protest period ends at **5:00 p.m. on Friday, June 5, 2026**. Protests received after this date will not be considered valid.
- If greater than 50 percent of the eligible properties protest the application, then the applicant can submit a Conditional Use application. A Conditional Use application requires a public hearing process considered by the Metropolitan Area Planning Commission and the Wichita City Council. If this is the situation, then you will be notified


in the future of any scheduled public hearing related to this case at which you will have the opportunity to provide comment.

Our signatures below indicate that the Administrative Permit to permit a Short Term Rental in the City is hereby GRANTED, subject to the following conditions, and subject to any valid protests / appeal received within the valid protest period.

- 1) Permitted only in residential Dwelling Units and permitted Accessory Apartments.
- 2) May be permitted as either a Primary Use or an Accessory Use
- 3) Not permitted to be in any Recreational Vehicle.
- 4) Must be licensed and operated in accordance with the requirements of Chapter 3.40 of the Code of the City of Wichita.
- 5) Must be in compliance at all times with all applicable zoning, building, fire and life-safety, housing and health codes.
- 6) Must not exceed the posted capacity permitted in accordance with Chapter 3.40 of the Code of the City of Wichita.
- 7) If the Zoning Administrator finds that there is a violation of any of the conditions of the Zoning Administrative Permit, the Zoning Administrator, in addition to enforcing the other remedies set forth in the Unified Zoning Code, may, with the concurrence of the Planning Director, declare that the Zoning Administrative Permit is null and void.

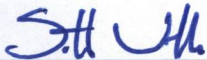

Scott Wadle, Director
Metropolitan Area Planning Department

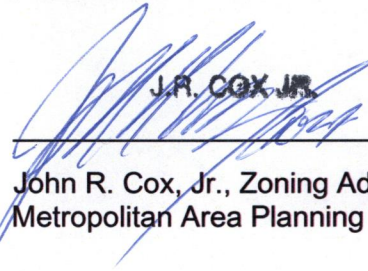

J.R. COX JR.

John R. Cox, Jr., Zoning Administrator
Metropolitan Area Planning Department

cc: MABCD

J.V. Johnston, CM District V

Teresa Veazey, CSR District V

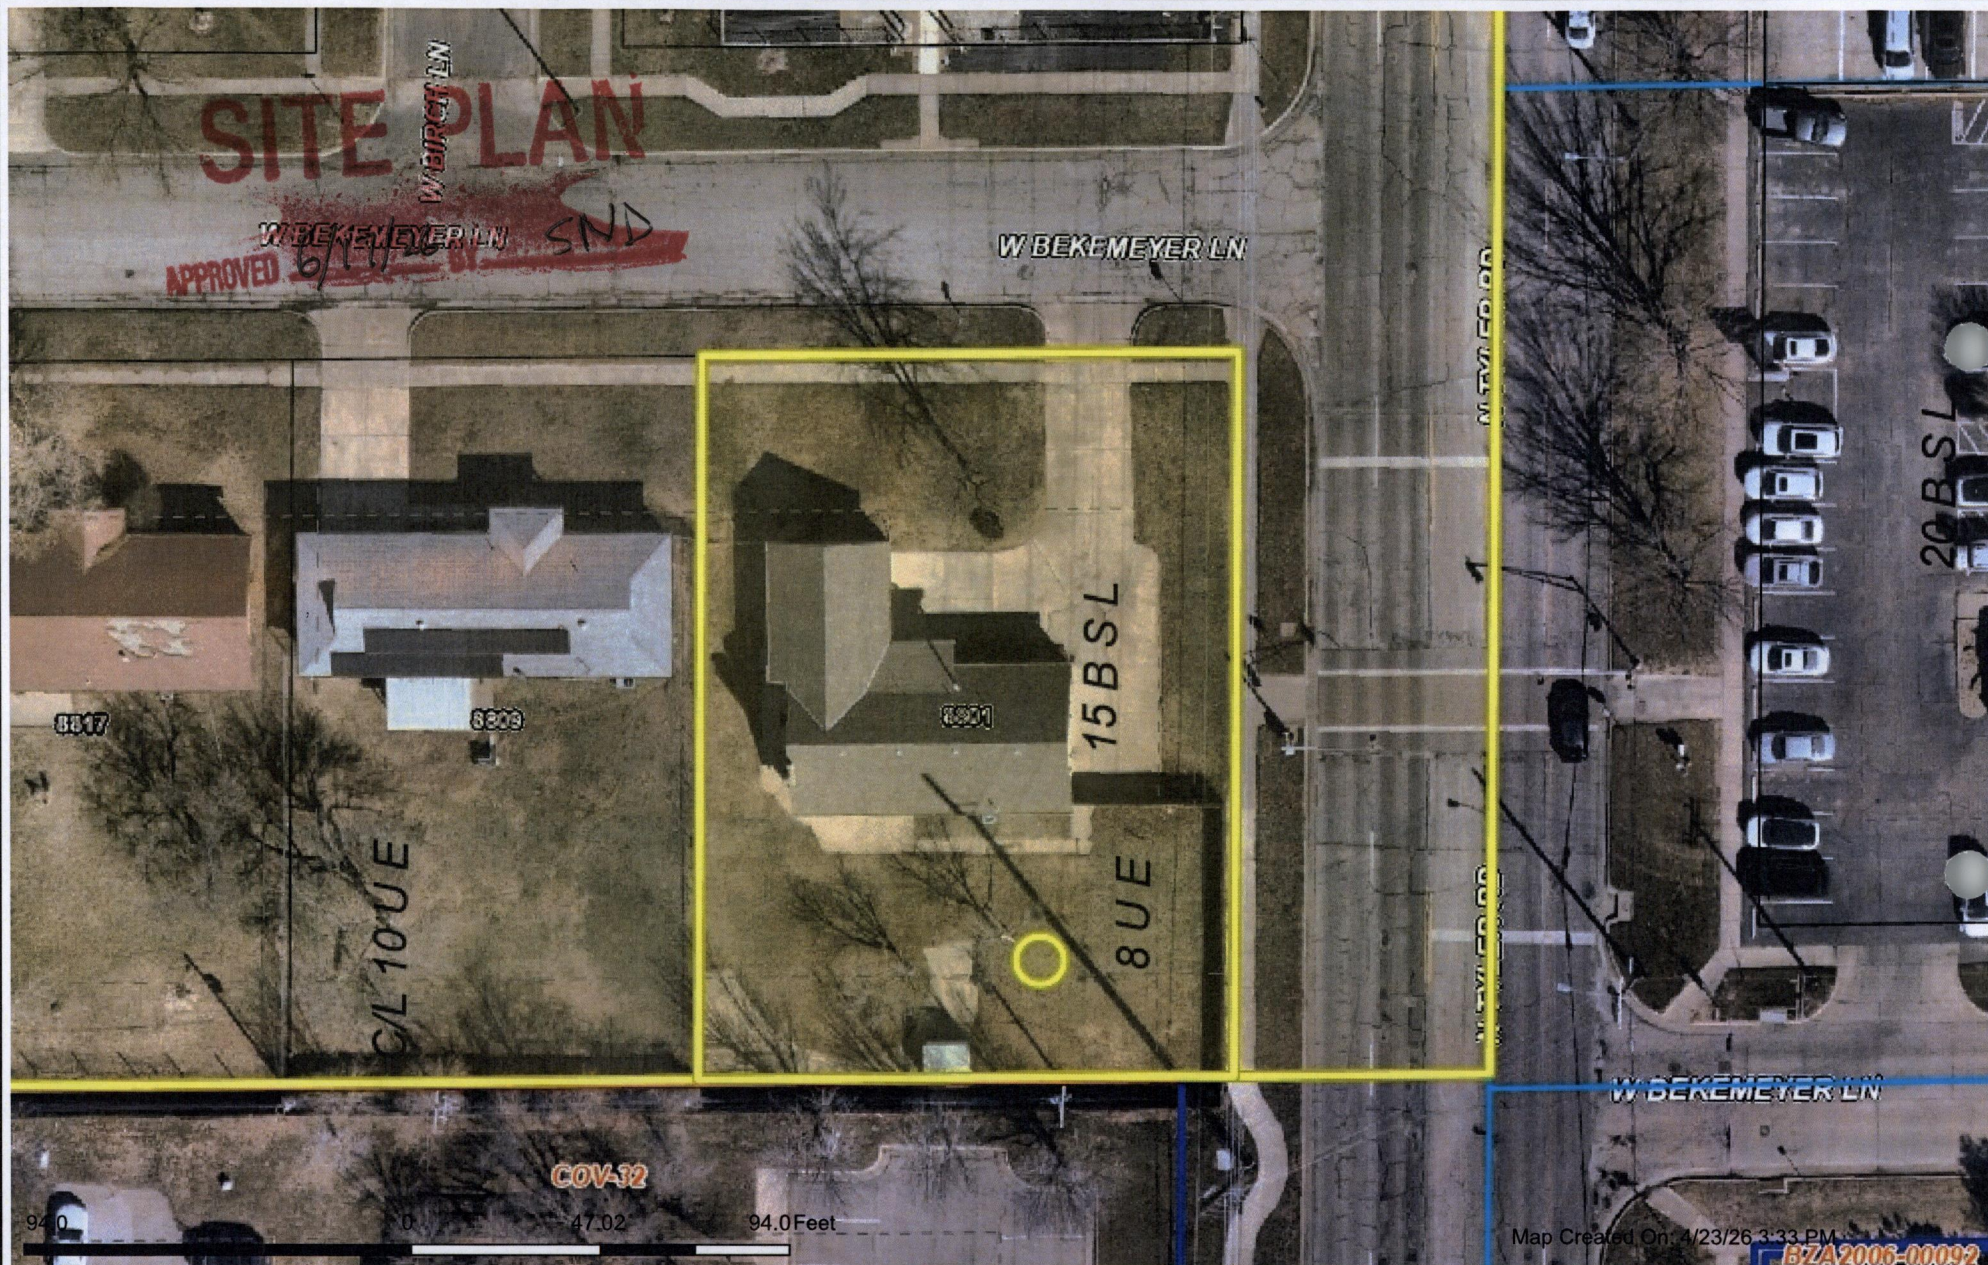

This information is not an official record, and cannot be used as such. The user should rely only upon official records available from the custodian of records in the appropriate City and/or County department. Some data provided here and used for the preparation of these maps has been obtained from public records not created or maintained by the City of Wichita.

1: 564

