

MAP No. 6160B  
 SEC. No. \_\_\_\_\_  
 TWP. No. \_\_\_\_\_  
 RANGE \_\_\_\_\_

CASE No: V - 1193

ASSOCIATED CASE: \_\_\_\_\_


the east-west and the north-south alleys in Block 11,

1. VACATION OF: Furley, Sedgwick Co., Kansas.  
 GENERALLY LOCATED: north of 101st St. North and west of Greenwich Road

744-3100

REQUESTED BY: Bobby D. Eilert, et al, Rte 1, Box 105A, Valley Center 67147AGENT: Alan JosephADDRESS: Box 2373, Suite 210, 434 N. Market. 67201 PHONE 265-9650

REASON FOR REQUEST: \_\_\_\_\_

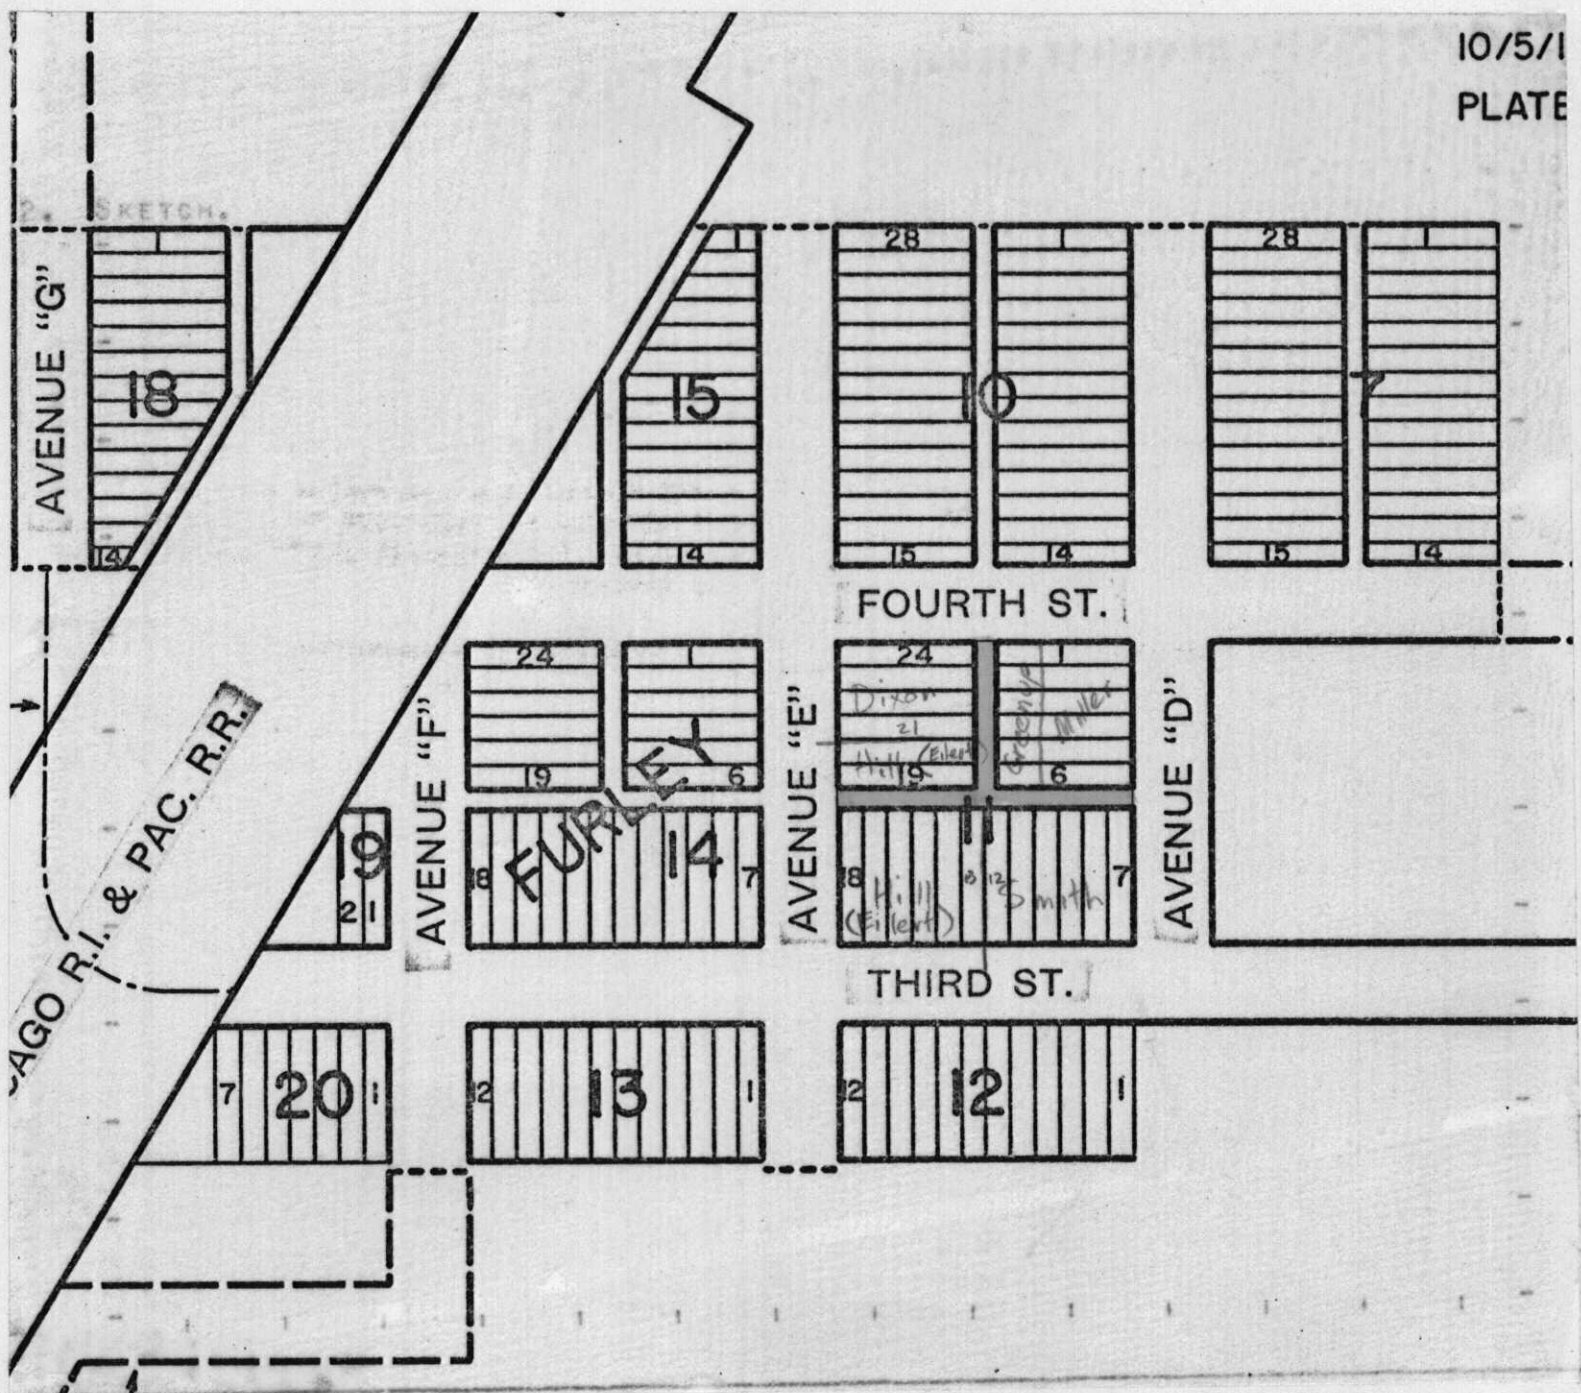

3. APPLICATION FILED 5-25-83  
 POSTED TO ATLAS \_\_\_\_\_  
 NOTICES SENT \_\_\_\_\_  
 S/D COMM. ACTION 6-9-83 Approve  
 DEPT. REPORT \_\_\_\_\_  
 M.A.P.C. ACTION 6-16-83 approve  
 DEPT. REPORT \_\_\_\_\_

ORD/RES. SUBMITTED \_\_\_\_\_  
 APPROVED BY DEPT OF LAW \_\_\_\_\_  
 B.C.C. ACTION \_\_\_\_\_

ORD/RES \_\_\_\_\_ PUBLISHED \_\_\_\_\_  
 BD. Co. Co. ACTION 7-27-83 Approve

ORDER TO VACATE RECORDED \_\_\_\_\_

BEFORE THE BOARD OF COUNTY COMMISSIONERS  
OF SEDGWICK COUNTY, KANSAS

IN THE MATTER OF THE VACATION  
OF  
THE EAST-WEST ALLEY AND THE  
NORTH-SOUTH ALLEY IN BLOCK 11,  
FURLEY, SEDGWICK COUNTY, KANSAS.

VACATION ORDER

Now on this \_\_\_\_\_ day of \_\_\_\_\_, 19\_\_, at 9:00  
o'clock A.M. comes on for hearing the petition filed herein by  
\_\_\_\_\_, praying for the vacation of the  
following described \_\_\_\_\_ alleys \_\_\_\_\_:

The east-west alley and the north-south alley in Block 11,  
Furley, Sedgwick County, Kansas.

the said petitioners being represented by their attorney,  
Alan Joseph.

WHEREUPON, it is shown that proper notice has been given by  
publication in the \_\_\_\_\_, a newspaper printed in  
the State of Kansas and being published in and for general circulation  
in Sedgwick County, Kansas, the first publication being made on the  
\_\_\_\_\_, day of \_\_\_\_\_, 19\_\_, and proper proof of such  
publication being filed herein. The Board being advised in the pre-  
mises finds that such notice is in due legal form and conforms to K.S.A.  
1970 Supp. 12-504.

THEREAFTER, the matter is presented to the Board and the Board  
finds that no private rights will be injured or endangered by such  
vacation and that the public will suffer no loss or inconvenience  
thereby, and that in justice to the petitioners, their prayer should  
be granted and that no written objections have been filed hereto with  
the County Clerk.

The Board further finds that the Wichita-Sedgwick  
County Metropolitan Area Planning Commission ; at its  
regular meeting held on the 16th day of June, 1983,  
recommended and approved the vacation of the above described  
alleys.

IT IS THEREFORE BY THE BOARD OF COUNTY COMMISSIONERS, in regular  
session duly assembled, ordered that the above described \_\_\_\_\_  
hereby vacated.

\_\_\_\_\_  
JACK SPRATT, CHAIRMAN

\_\_\_\_\_  
DONALD E. GRAGG, CHAIRMAN PRO TEM

\_\_\_\_\_  
TOM SCOTT, COMMISSIONER

ATTEST:

\_\_\_\_\_  
DOROTHY K. WHITE, COUNTY CLERK


APPROVED AS TO FORM:

\_\_\_\_\_  
RICHARD EUSON, ASST. COUNTY COUNSELOR



# FURLEY,

Sedgwick County,  
Kansas.

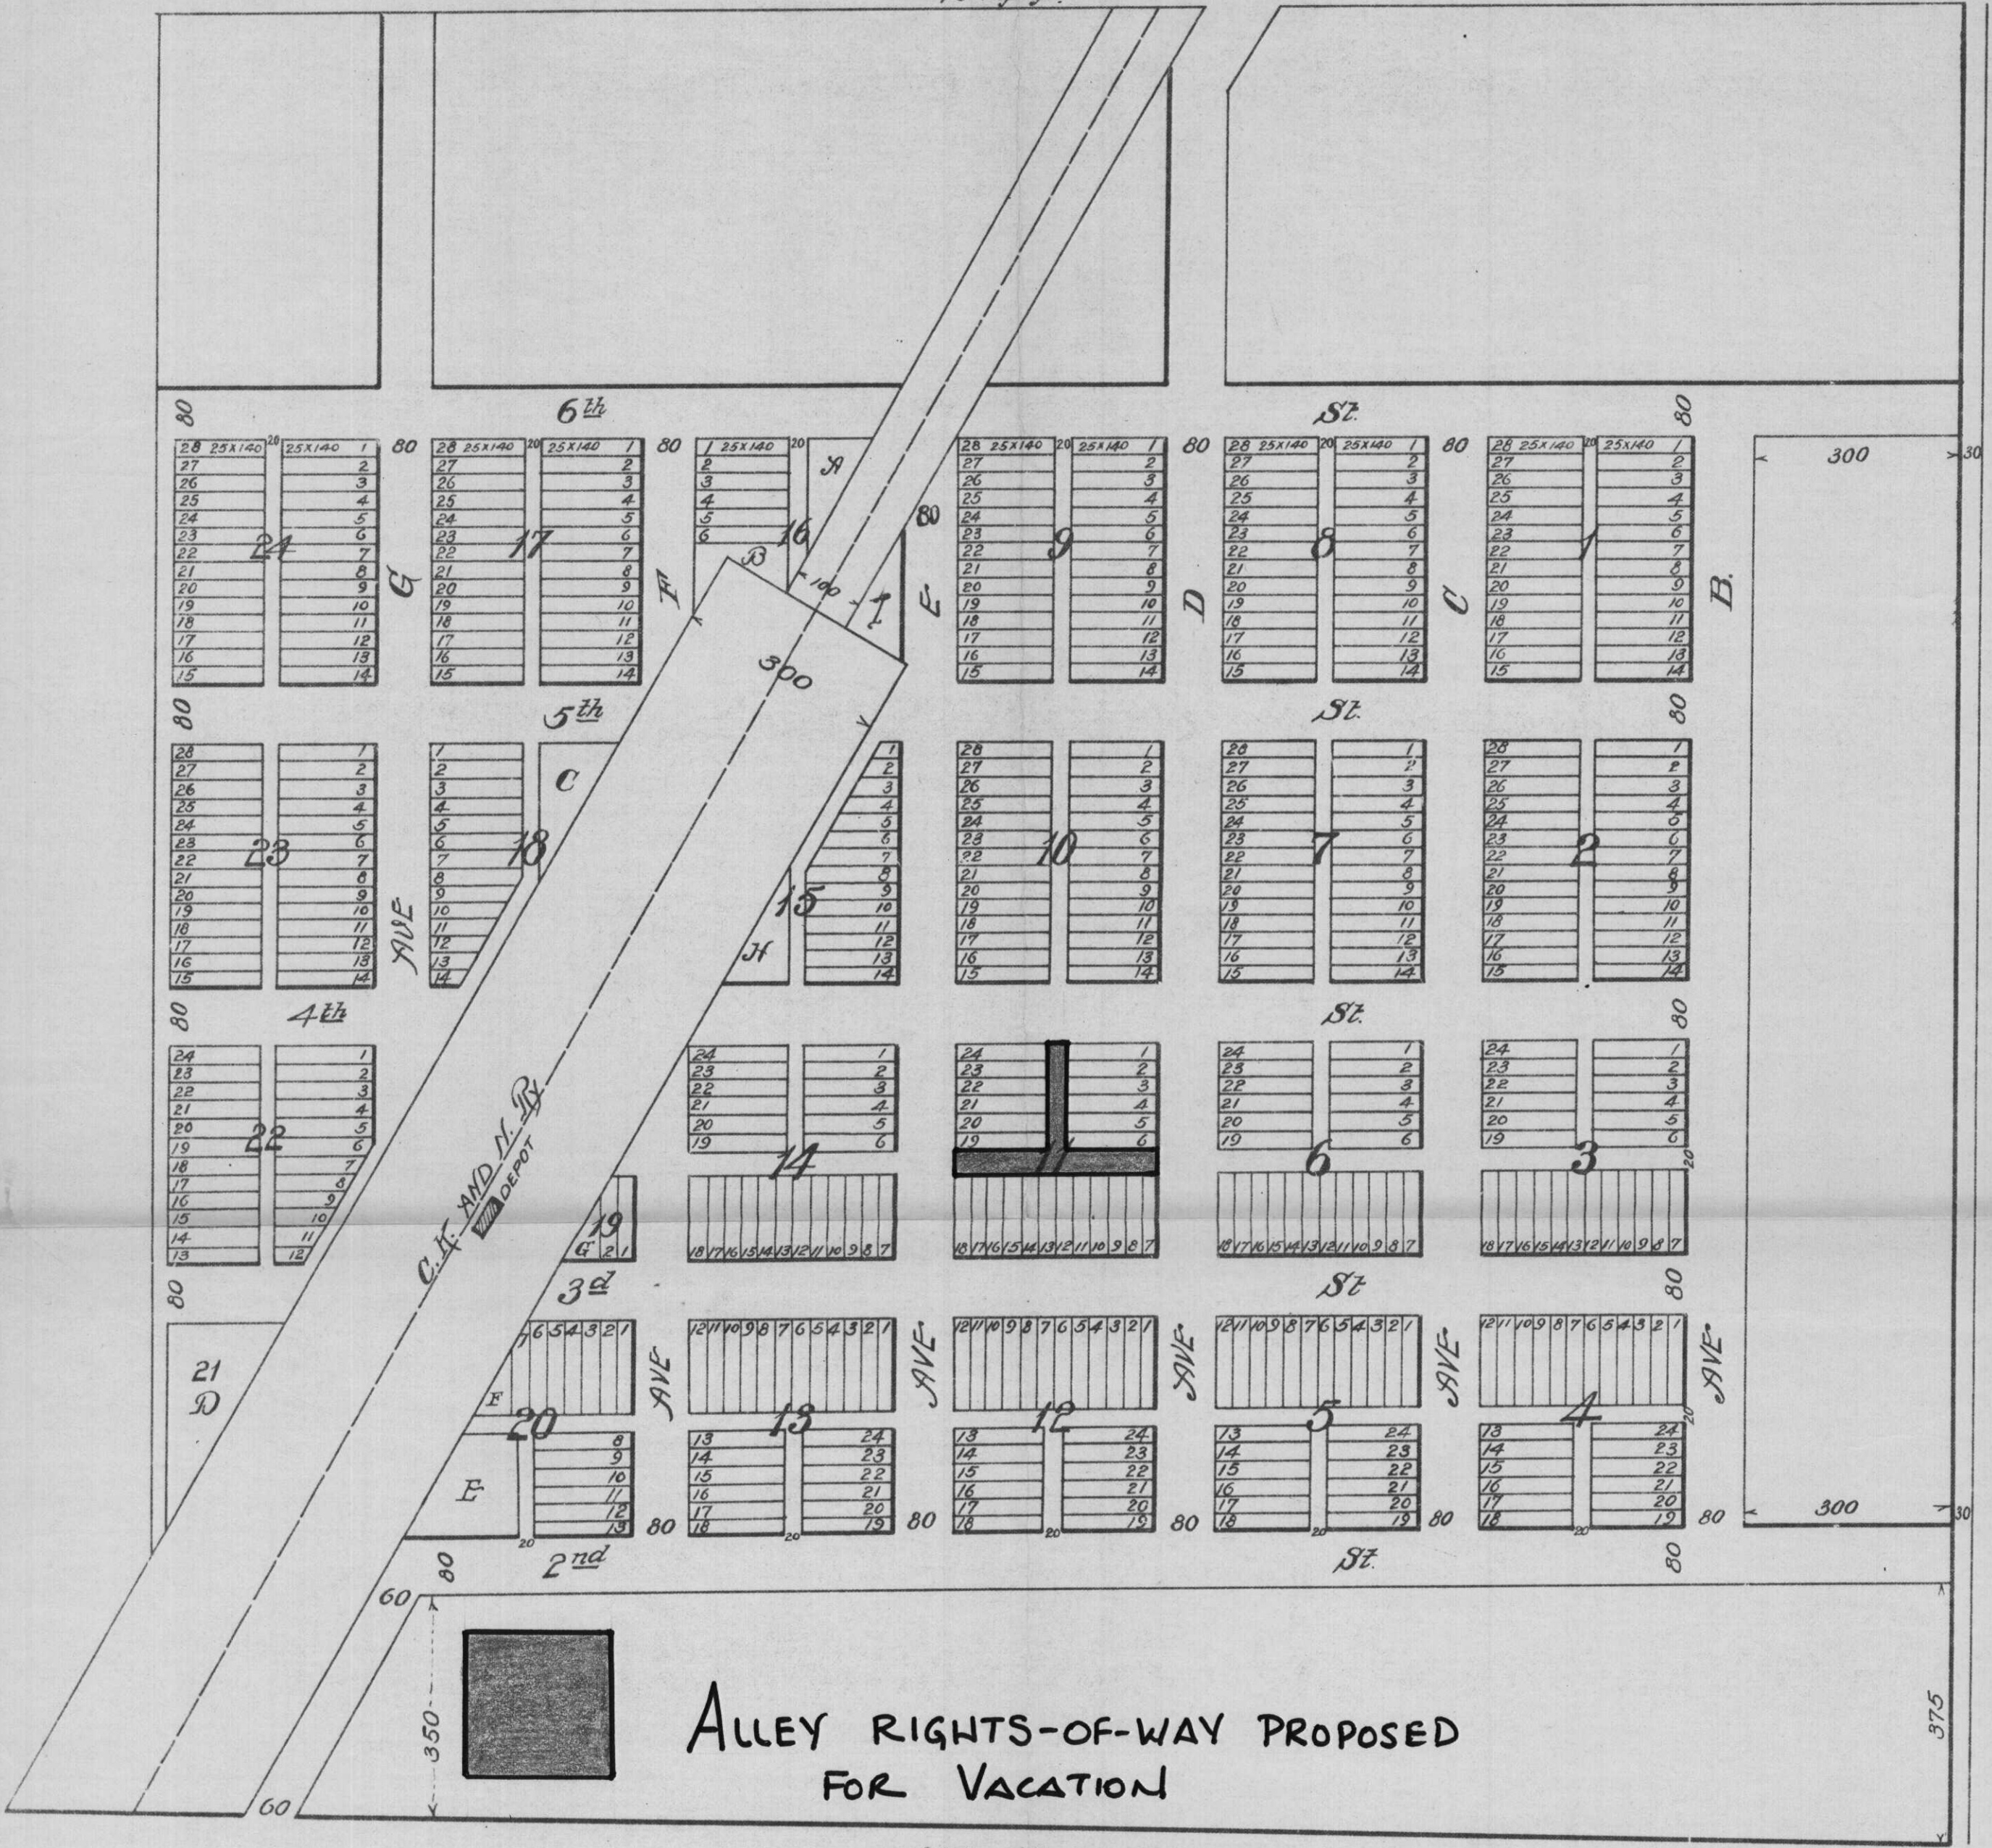

Know all men by these presents that the Golden Belt town Company a corporation duly organized under the laws of the State of Kansas has caused this plat to be made executed and filed by it as a map or plat of a town to be known as the town of Furley, located on a part of the Northeast quarter of section sixteen (16) township twenty five (25) South of range two (2) East in Sedgwick County, Kansas. More particularly described as follows to wit: Beginning at a point on a line running north 10°40' west three hundred and seventy five (375) feet north of and three hundred and thirty (330) feet west of the south east corner of said quarter section running thence northerly on said line seventeen hundred and twenty feet (1720) thence westerly at a right angle to said line to the west line of said quarter section, thence southerly on the west line of said quarter section seventeen hundred and twenty (1720) feet, thence easterly on a line to the place of beginning. All streets and alleys are of the width indicated on plat all lots are 25x140 feet excepting those in blocks 15, 16, 18, 19, and 22 which are of such dimensions and bounded by such streets and alleys and other grounds as indicated by plat. Fractions A, B, C, D, E, F, G, H, I are of such shape and dimensions and bounded by such others grounds as plat indicates. All streets and alleys are hereby dedicated to the public use. In witness whereof the Golden Belt town Company has caused this plat to be subscribed by its President attested to by its Secretary and the seal of said corporation to be fixed hereunto this day of May A.D. 1887.

E.H. Kollock President.  
Charles C. Furley Secretary.

State of Kansas, S.S.  
Marion County.

Be it remembered that on this day of May A.D. 1887 before me a Notary Public in and for said county personally came a F.H. Kollock and to me known to be the identical person described in and who executed the foregoing plat as president of the Golden Belt town company and who duly acknowledged the execution of the same. In testimony whereof I have hereunto set my hand and official seal on the day and year last above written.

Willis Westerbrook,  
Notary Public.

Notary Term expires Jan'y 29-1888.

State of Kansas, S.S.  
Sedgwick County.

Be it remembered that on this 20th day of May 1887 before me a Notary Public in and for said county personally came one C.C. Furley and to me known to be the identical person described in and who executed the foregoing plat as secretary of the Golden Belt town Company and who duly acknowledged the execution of the same. In testimony whereof I have hereunto set my hand and official seal the day and year above written.

W.J. Holbrook,  
Notary Public.

Notary term expires June 9-1890.

FILED 20th MAY 1887 AND RECORDED  
IN PLAT BOOK P  
PAGE 7.  
H.D. WEISERMAN REGISTER OF DEEDS  
GEO. F. BEARSE DEPUTY.

ENTERED ON TRANSFER  
RECORD  
MAY 20 1887  
E.P. FORD CO. CLERK

I, Joseph Bowman,  
Register of Deeds of  
Sedgwick County, Kansas,  
do hereby certify that the  
above is a true and correct  
copy of the plat of Furley,  
Sedgwick County, Kansas;  
that the original, of which  
above is a copy, is on file in  
my office and that I have  
the legal custody thereof.

Witness my hand and the  
seal of my office this 21st day  
of Feb. 1912.

Joseph Bowman  
Register of Deeds.