


DEVELOPMENT GUIDELINES

General Provisions

- Area:
The total development contains 19.58 net acres of land more or less.
- Parcel Descriptions:

Parcel	Summary
Parcel 1	Gross Area= 1.07 Ac. or 46,662 s.f. Maximum Height=35 feet Max. Building Coverage=30% Max. Gross Floor Area=35% or 16,332 s.f. Floor Area Ratio=0.30
Parcel 2	Gross Area= 0.92 Ac. or 40,000 s.f. Maximum Height=35 feet Max. Building Coverage=30% Max. Gross Floor Area=35% or 14,000 s.f. Floor Area Ratio=0.30
Parcel 3	Gross Area= 0.69 Ac. or 30,000 s.f. Maximum Height=35 feet Max. Building Coverage=30% Max. Gross Floor Area=35% or 10,500 s.f. Floor Area Ratio=0.30
Parcel 4	Gross Area= 0.69 Ac. or 30,000 s.f. Maximum Height=35 feet Max. Building Coverage=30% Max. Gross Floor Area=35% or 10,500 s.f. Floor Area Ratio=0.30
Parcel 5	Gross Area= 0.72 Ac. or 31,188 s.f. Maximum Height=35 feet Max. Building Coverage=30% Max. Gross Floor Area=35% or 10,916 s.f. Floor Area Ratio=0.35
Parcel 6	Gross Area= 0.98 Ac. or 40,849 s.f. Maximum Height=35 feet Max. Building Coverage=30% Max. Gross Floor Area=35% or 14,297 s.f. Floor Area Ratio=0.35
Parcel 7	Gross Area= 0.60 Ac. or 26,018 s.f. Maximum Height=35 feet Max. Building Coverage=30% Max. Gross Floor Area=35% or 9,106 s.f. Floor Area Ratio=0.35
Parcel 8	Gross Area= 0.69 Ac. or 30,000 s.f. Maximum Height=35 feet Max. Building Coverage=30% Max. Gross Floor Area=35% or 10,500 s.f. Floor Area Ratio=0.35
Parcel 9	Gross Area= 1.27 Ac. or 55,203 s.f. Maximum Height=35 feet Max. Building Coverage=30% Max. Gross Floor Area=35% or 19,321 s.f. Floor Area Ratio=0.35
Parcel 10	Gross Area= 10.30 Ac. or 449,090 s.f. Maximum Height= 40 feet Max. Building Coverage=33% Max. Gross Floor Area= 38.5% or 172,900 s.f. Floor Area Ratio= 0.385
Parcel 11	Gross Area= 0.99 Ac. or 43,136 s.f. Maximum Height= 35 feet Max. Building Coverage= 30% Max. Gross Floor Area= 35% or 15,098 s.f. Floor Area Ratio=0.35
- Landscaping for this site shall be required as follows:
A. Landscaped street yards, buffers, and parking lot landscaping/screening, shall utilize a shared palette of landscape materials and shall be in accordance with the City of Wichita Landscape Ordinance.
B. A landscape plan shall be prepared by a Kansas Landscape Architect for the above referenced landscaping, indicating the type, location, and specifications of all plant material. This plan shall be submitted to the Metropolitan Area Planning Department (MAPD) for its review and approval prior to issuance of any building permit(s).
C. A financial guarantee for the plant material approved on the landscape plan for that portion of the C.U.P. being developed shall be required prior to issuance of any occupancy permit, if the required landscape has not been planted.
- Lighting:
A. Lighting shall be in accordance with the Wichita-Sedgwick County Unified Zoning Code, Section IV.
B. All Parcels shall share similar or consistent parking lot lighting elements (i.e. fixtures, poles and lamps and etc.), as approved by the Director of the MAPD.
C. All lighting shall be shielded to direct light disbursement in a downward direction and directed away from residential areas.
D. Light poles including above ground base shall be limited to 25 feet tall, except 15 feet tall when within 100 feet of residential zoning with residential use. School is not a residential use.
E. Extensive use of back lit canopies and neon or fluorescent tube lighting on buildings is not permitted on Parcels 3 through 10. Parcel 1 & 2 is prohibited, exclusive of building signage.
- Screening for this site shall be required as follows:
A. Rooftop mechanical equipment shall be screened from ground level view with screening materials matching the building roof or wall materials; and as per Wichita-Sedgwick County Unified Zoning Code.
B. Trash receptacles, loading docks, outdoor storage, and loading areas shall be appropriately screened with materials matching or similar to the building(s) facade materials to reasonably hide them from ground view.
C. Unless otherwise noted Screening shall be in accordance with the Wichita-Sedgwick County Unified Zoning Code, Section IV and Section III-C.2.b.
D. Outdoor display and storage shall be subject to all conditions of Section III-B.1.4.e for all Parcels.
E. A screening wall in conformance with Section III-C.2.b shall be constructed along the south and west lines of Parcel 1 and the west line of Parcel 10; unless, if the buildings in Parcel 1 and the north 300 feet of Parcel 10 abutting the Reserve are designed to use the residential reserve as an amenity with a double-faced facade and with no outdoor work, storage, or loading areas on the west property line, the screening wall may be replaced with landscaping. The landscaping shall consist of the existing mature trees, or if these trees are removed, replacement trees shall be planted at a minimum rate of one tree per 40 feet of property line and a three foot high berm and solid evergreen screening of any parking lot areas.
F. A masonry wall located along the south property lines of the C.U.P. (see wall easement) shall be constructed at least six feet but not more than eight feet high. It shall consist of a solid or semisolid wall constructed of brick, stone, masonry, architectural tile, or other similar material (not including wood or woven wire). Construction of the wall will require a building permit. No wall shall be constructed in a utility easement, however utilities may cross the wall at various locations. Wall openings may be permitted allowing pedestrian access. The wall opening(s) shall be determined and approved by the director of planning prior to the issuance of the building permit.
- Setbacks:
Setbacks are as indicated on the C.U.P. drawing or as specified in Wichita-Sedgwick County Unified Zoning Code. Setback lines that are not depicted within the CUP shall comply with the base district development standards. If contiguous Parcels are to be developed under the same ownership, setbacks between those Parcels will not be required. Interior side building setbacks shall maintain a minimum of 10 feet. A zero-lot-side setback may be acceptable in circumstances where adjoining lots under separate ownership with a common wall. Zero-lot-side setbacks must at meet the following conditions: affected property owners are agreeable to the common wall, all fire codes must be adhered to, and the reduction must be approved by an Administrative Adjustment to this CUP.
- Signs: As permitted under the Sign Code of the City of Wichita.
Additionally, the following conditions apply:
A. All Parcels are subject to the requirements of the Sign Code for the City of Wichita for LC Zoning District except as noted herewith.
B. No flashing, moving, portable, off-site billboards, (except project title signs for the Krug South Subdivision), banner, or pennant signs shall be permitted (except for signs showing time and temperature).
C. Ground signs shall all consist of monument style signs and share similar elements of design. One (1) sign along 21st Street and one (1) sign along 143rd Street shall have a maximum height of 25 feet and a maximum sign face area of 150 square feet to be used for development identification as well as tenant signs for tenants within the CUP. Additional monument signs shall have a maximum height of 20 feet and a maximum sign face area of 150 square feet, except for Parcels 1 and 2 where monument signs shall have a maximum height of 10 feet and a maximum sign face area of 100 square feet.
D. Signs shall be spaced a minimum distance of 150 feet apart, provided however, that this spacing may be reduced to 100 feet between the development identification sign(s) and the adjacent monument sign. However, calculations of the maximum number of sign locations per street frontage shall be based on a distance separation of 150 feet between sign locations allowing a maximum of six (6) signs on 21st Street and four (4) on 143rd Street when one sign is shared at the corner of Parcel 6.
E. The total amount of sign face area of freestanding signage along each arterial street shall not exceed 0.8 times the linear frontage. Building wall signs shall be prohibited on the south elevation of Parcel 9 and the south and west elevations of Parcel 10.
F. Window signage shall be limited to 25% of window area.
- Parking:
All Parcels shall be in accordance with the Wichita-Sedgwick County Unified Zoning Code, Section IV-A, unless otherwise specified.
- Reserves:
Reserves A and B are for the use as planned: Reserve "A" is planned for a public drainage easement granted to the public, drainage facilities, utilities confined by easements, sidewalks, monuments, landscaping, irrigation, and open space. Reserve "B" is planned for a public drainage easement granted to the public, drainage facilities, utilities confined by easements, sidewalks, landscaping, irrigation, and open space. Reserve "B" is also granted as a permanent easement to the public for the purpose constructing and financing stormwater mitigation, drainage, and detention improvements. Reserve "A" shall be owned and maintained by the developer (Bristol Square, LLC), and/or its successors or assigns or a Lot Owner's Association and is reserved for the stated uses. The Reserve "B" shall be owned and maintained by the adjoining developer (Riddle Associates, Inc.), and/or its successors or assigns or a Home Owner's Association and is reserved for the stated uses.

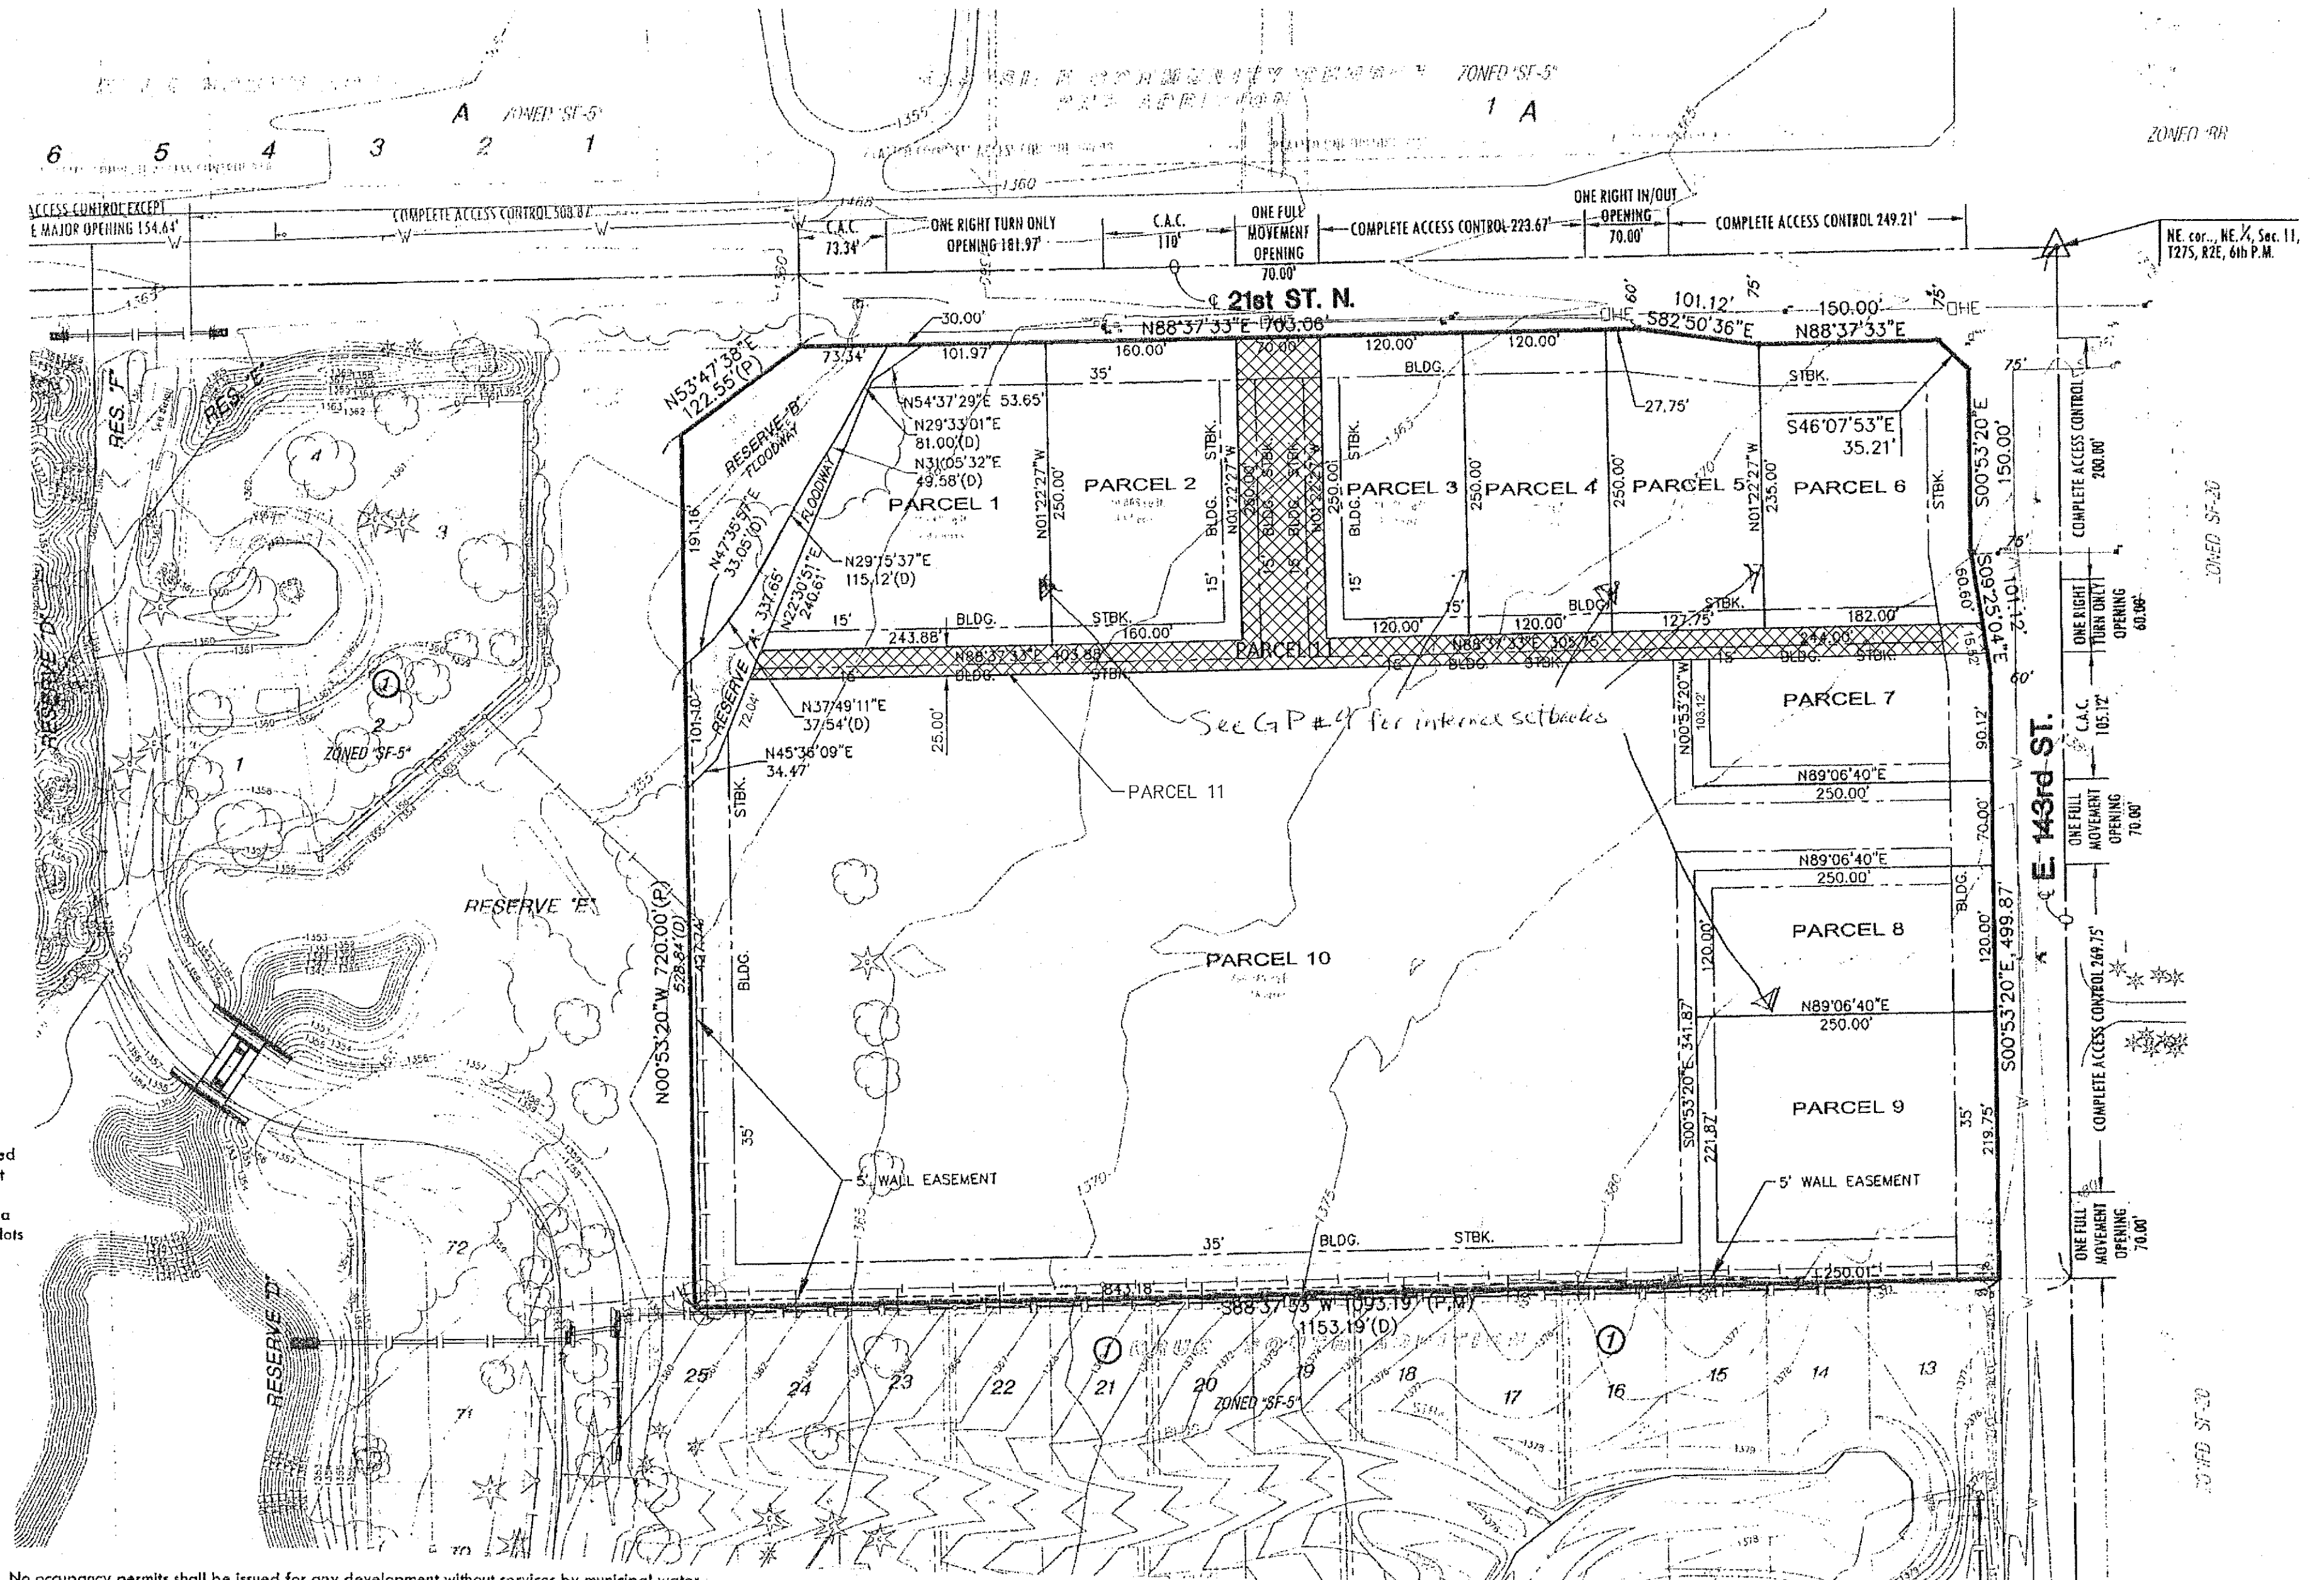


LEGAL DESCRIPTION

A tract of land lying in the Northeast Quarter of Section 11, Township 27 South, Range 2 East of the Sixth Principal Meridian, Wichita, Sedgwick County, Kansas; said tract being more particularly described as follows:

BEGINNING at the northeast corner of said Northeast Quarter, thence along the east line of said Northeast Quarter on a Kansas coordinate system of 1983 south zone grid bearing of S00°53'20"E, 850.00 feet; thence S88°37'33"W, 60.00 feet to the northeast corner of Lot 13, Block 1, Krug South Addition, an addition to Wichita, Sedgwick County, Kansas; thence along a northerly line of said Block 1, said addition, S88°37'33"W, 1093.19 feet to the southeast corner of Reserve "E", said addition; thence along the east line of said Reserve "E", N00°53'20"W, 720.00 feet; thence continuing along said east line of said Reserve "E", N53°47'38"E, 122.55 feet to the northeast corner of said Reserve "E"; thence N01°22'27"W, 60.00 feet to the north line of said Northeast Quarter; thence along said north line, N88°37'33"E, 1053.70 feet to the POINT OF BEGINNING.

C.U.P. LOCATION

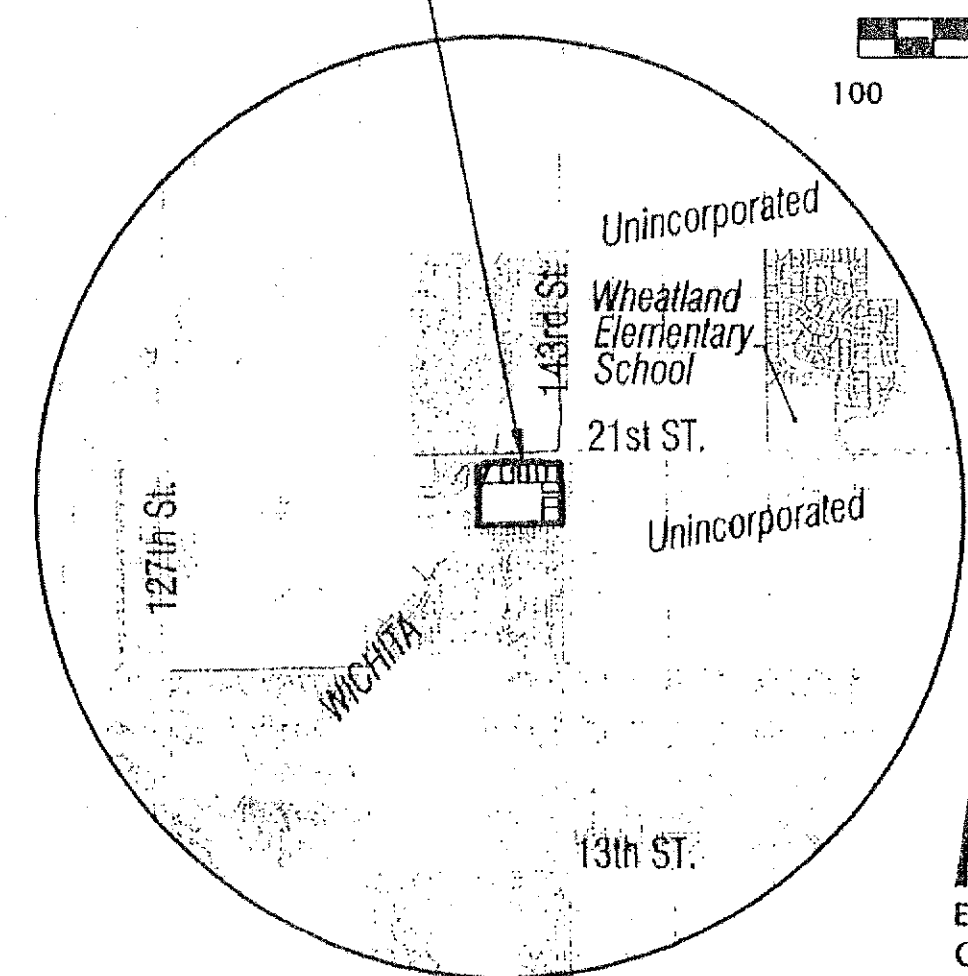

VICINITY MAP

MKEC
ENGINEERING
CONSULTANTS, INC.

411 N. WEBB ROAD
WICHITA, KS. 67206
316-684-9600

COMMUNITY UNIT PLAN DP-302 KRUG SOUTH

A.A.#1 8-18-2009

Owner / Developer: Bristol Square, LLC, a Kansas limited liability company 8111 E. 32nd St., Suite 101, Wichita, KS, 67226 316.262.3331

As per AA CUP 2010-48 1-5-2021

APPROVED CUP

MAPD 12-07-06 PLM

WCC 01-08-06 PLM

MAPD Copy 1 of 1

DEVELOPMENT GUIDELINES

General Provisions

- Area:
The total development contains 19.58 net acres of land more or less.
- Parcel Descriptions:
Summary:
Total allowable floor ratio = .30
Minimum Building Setbacks: (applies to all parcels as shown)
Aerial street setback = 35'
Interior side setback = 10' (See G.P. #9)

Parcel 1 Gross Area= 1.07 Ac. or 46,662 s.f. Maximum Height=35 feet Max. Building Coverage=30% Max. Gross Floor Area=35% or 16,332 s.f. Floor Area Ratio=0.30	Parcel 6 Gross Area= 0.98 Ac. or 40,849 s.f. Maximum Height=35 feet Max. Building Coverage=30% Max. Gross Floor Area=35% or 14,297 s.f. Floor Area Ratio=0.35
Parcel 2 Gross Area= 0.92 Ac. or 40,000 s.f. Maximum Height=35 feet Max. Building Coverage=30% Max. Gross Floor Area=35% or 14,000 s.f. Floor Area Ratio=0.30	Parcel 7 Gross Area= 0.74 Ac. or 32,174 s.f. Maximum Height=35 feet Max. Building Coverage=30% Max. Gross Floor Area=35% or 11,261 s.f. Floor Area Ratio=0.35
Parcel 3 Gross Area= 0.69 Ac. or 30,000 s.f. Maximum Height=35 feet Max. Building Coverage=30% Max. Gross Floor Area=35% or 10,500 s.f. Floor Area Ratio=0.30	Parcel 8 Gross Area= 0.69 Ac. or 30,000 s.f. Maximum Height=35 feet Max. Building Coverage=30% Max. Gross Floor Area=35% or 10,500 s.f. Floor Area Ratio=0.35
Parcel 4 Gross Area= 0.69 Ac. or 30,000 s.f. Maximum Height=35 feet Max. Building Coverage=30% Max. Gross Floor Area=35% or 10,500 s.f. Floor Area Ratio=0.30	Parcel 9 Gross Area= 1.27 Ac. or 55,203 s.f. Maximum Height=35 feet Max. Building Coverage=30% Max. Gross Floor Area=35% or 19,321 s.f. Floor Area Ratio=0.35
Parcel 5 Gross Area= 0.72 Ac. or 31,188 s.f. Maximum Height=35 feet Max. Building Coverage=30% Max. Gross Floor Area=35% or 10,916 s.f. Floor Area Ratio=0.35	Parcel 10 Gross Area= 11.16 Ac. or 486,069 s.f. Maximum Height=35 feet Max. Building Coverage=30% Max. Gross Floor Area=35% or 170,124 s.f. Floor Area Ratio=0.35

- All uses permitted in LC, Limited Commercial District are permitted for all of the Parcels, EXCEPT the following uses:

A. Group Residence, Limited; Group Residence, General; Correctional Placement Residence, Limited; Correctional Placement Residence, General; Parks and Recreation; Recycling Collection Station, Private; Recycling Collection Station, Public; Utility, Major; Utility, Minor; Heliport, Kennel, Boarding/Breeding/Training, Night Club in the City, Night Club in the Country, Pawn Shop, Sexually Oriented Business, Tavern and Drinking Establishment, Wireless Communication Facility, Cemetery, Golf Course, Marine Facility, Recreational, All Industrial / Manufacturing / Extractive Uses.

B. Parcels 1 & 2 shall be restricted to those uses permitted in the "NR" Neighborhood Retail (but not including Special NR District Regulations for commercial use size limit and district size limit) and "GO" General Office Zoning Districts, except Animal Care, Limited and Recreation and Entertainment, Indoor will be permitted.

C. In any parcel, no overhead doors, drive-through or in car service (for restaurants, banks, etc., service station, fuel outlets or gas pumps) shall be permitted within 100 feet of any single-family residential lot and shall not be facing south, west, or for Parcels 1 and 2 the abutting Reserve to the north (Reserve "C", Krug North Addition).

D. For Parcels 1 and 2 queuing for drive-through lanes (restaurants, ATM's etc) shall not direct vehicle headlights to the west or north, unless sufficiently screened to prohibit the direct casting of vehicle headlights onto the adjoining western and northern properties. Such screening shall consist of any one of the following screening techniques: earthen berms, coniferous/evergreen landscaping, buildings, wall(s), or any combination thereof.

E. For the west 200 feet of Parcel 10, and if a screening wall is not required, queuing for drive-through lanes (restaurants, ATM's, etc.) shall not direct vehicle headlights to the west or north.

F. The uses permitted by the C.U.P. are only those uses permitted by right and not by conditional use.

G. No single tenant shall exceed 100,000 square feet except a drug store or a grocery store on Parcel 10.

- Architectural Controls:
All buildings within the C.U.P. shall share a uniform architectural character, color, and same predominate exterior building material, as approved by the Director of Planning. The building(s) walls shall not utilize metal as a predominant exterior facade material.

- Title:
The transfer of the title on all or any portion of the land included in the Community Unit Plan does not constitute a termination of the plan or any portion thereof; but said plan shall run with the land for commercial development and be binding upon the present owners, their successors and assigns and amended. However, the Director of the MAPD, with the concurrence of the Zoning Administrator, may approve minor adjustments to the conditions in this overlay, consistent with the approved development plan, without filing a formal ordinance amendment.

DP-302 Per Admin Adjustment 07-06-09, REV 08-18-09

APPROVED CUP

MAPD 12-27-06 DM

WCC 01-09-07 DM

MAPD Copy 1 of 2

- Landscaping for this site shall be required as follows:

- Landscaped street yards, buffers, and parking lot landscaping/screening, shall utilize a shared palette of landscape materials and shall be in accordance with the City of Wichita Landscape Ordinance.
- A landscape plan shall be prepared by a Kansas Landscape Architect for the above referenced landscaping, indicating the type, location, and specifications of all plant material. This plan shall be submitted to the Metropolitan Area Planning Department (MAPD) for its review and approval prior to issuance of any building permit(s).
- A financial guarantee for the plant material approved on the landscape plan for that portion of the C.U.P. being developed shall be required prior to issuance of any occupancy permit, if the required landscape has not been planted.

- Lighting:

- Lighting shall be in accordance with the Wichita-Sedgwick County Unified Zoning Code, Section IV.
- All Parcels shall share similar or consistent parking lot lighting elements (i.e. fixtures, poles and lamps and etc.), as approved by the Director of the MAPD.
- All lighting shall be shielded to direct light disbursement in a downward direction and directed away from residential areas.
- Light poles including above ground base shall be limited to 25 feet tall, except 15 feet tall when within 100 feet of residential zoning with residential use. School is not a residential use.
- Extensive use of back lit canopies and neon or fluorescent tube lighting on buildings is not permitted on Parcels 3 through 10. Parcel 1 & 2 is prohibited, exclusive of building signage.

- Screening for this site shall be required as follows:

- Rooftop mechanical equipment shall be screened from ground level view with screening materials matching the building roof or wall materials; and as per Wichita-Sedgwick County Unified Zoning Code.
- Trash receptacles, loading docks, outdoor storage, and loading areas shall be appropriately screened with materials matching or similar to the building(s) facade materials to reasonably hide them from ground view.
- Unless otherwise noted Screening shall be in accordance with the Wichita-Sedgwick County Unified Zoning Code, Section IV and Section III-C.2.b.
- Outdoor display and storage shall be subject to all conditions of Section III-B.1.4.e for all Parcels.
- A screening wall in conformance with Section III-C.2.b shall be constructed along the south and west lines of Parcel 1 and the west line of Parcel 10; unless, if the buildings in Parcel 1 and the north 300 feet of Parcel 10 abutting the Reserve are designed to use the residential reserve as an amenity with a double-faced facade and with no outdoor work, storage, or loading areas on the west property line, the screening wall may be replaced with landscaping. The landscaping shall consist of the existing mature trees, or if these trees are removed; replacement trees shall be planted at a minimum rate of one tree per 40 feet of property line and a three foot high berm and solid evergreen screening of any parking lot area(s).
- A masonry wall located along the south property lines of the C.U.P. (see wall easement) shall be constructed at least six feet but not more than eight feet high. It shall consist of a solid or semisolid wall constructed of brick, stone, masonry, architectural tile, or other similar material (not including wood or woven wire). Construction of the wall will require a building permit. No wall shall be constructed in a utility easement, however utilities may cross the wall at various locations. Wall openings may be permitted allowing pedestrian access. The wall opening(s) shall be determined and approved by the director of planning prior to the issuance of the building permit.

- Setbacks:

Setbacks are as indicated on the C.U.P. drawing or as specified in Wichita-Sedgwick County Unified Zoning Code. Setback lines that are not depicted within the CUP shall comply with the base district development standards. If contiguous Parcels are to be developed under the same ownership, setbacks between those Parcels will not be required. Interior side building setbacks shall maintain a minimum of 10 feet. A zero-lot side setback may be acceptable in circumstances where adjoining lots under separate ownership with a common wall. Zero-lot side setbacks must at meet the following conditions: affected property owners are agreeable to the common wall, all fire codes must be adhered to, and the reduction must be approved by an Administrative Adjustment to this CUP.

- Signs: As permitted under the Sign Code of the City of Wichita.
Additionally, the following conditions apply:


- All Parcels are subject to the requirements of the Sign Code for the City of Wichita for LC Zoning District except as noted herewith.
- No flashing, moving, portable, offsite-billboards, (except project title signs for the Krug South Subdivision), banner, or pennant signs shall be permitted (except for signs showing time and temperature).
- Ground signs shall all consist of monument style signs and share similar elements of design. One (1) sign along 21st Street and one (1) sign along 143rd Street shall have a maximum height of 25 feet and a maximum sign face area of 150 square feet to be used for development identification as well as tenant signs for tenants within the CUP. Additional monument signs shall have a maximum height of 20 feet and a maximum sign face area of 150 square feet, except for Parcels 1 and 2 where monument signs shall have a maximum height of 10 feet and a maximum sign face area of 100 square feet.
- Signs shall be spaced a minimum distance of 150 feet apart, provided however, that this spacing may be reduced to 100 feet between the development identification sign(s) and the adjacent monument sign. However, calculations of the maximum number of sign locations per street frontage shall be based on a distance separation of 150 feet between sign locations allowing a maximum of six (6) signs on 21st Street and four (4) on 143rd Street when one sign is shared at the corner of Parcel 6.
- The total amount of sign face area of freestanding signage along each arterial street shall not exceed 0.8 times the linear frontage. Building wall signs shall be prohibited on the south elevation of Parcel 9 and the south and west elevations of Parcel 10.
- Window signage shall be limited to 25% of window area.

- Parking:

All Parcels, shall be in accordance with the Wichita-Sedgwick County Unified Zoning Code, Section IV-A, unless otherwise specified.

- Reserves:

Reserves A and B are for the use as plotted: Reserve "A" is platted for a public drainage easement granted to the public, drainage facilities, utilities confined by easements, sidewalks, monuments, landscaping, irrigation, and open space. Reserve "B" is platted for a public drainage easement granted to the public, drainage facilities, utilities confined by easements, sidewalks, landscaping, irrigation, and open space. Reserve "B" is also granted as a permanent easement to the public for the purpose constructing and financing stormwater mitigation, drainage, and detention improvements. Reserve "A" shall be owned and maintained by the developer (Bristol Square, LLC), and/or its successors or assigns or a Lot Owner's Association and is reserved for the stated uses. The Reserve "B" shall be owned and maintained by the adjoining developer (Ritche Associates, Inc.), and/or its successors or assigns or a Home Owner's Association and is reserved for the stated uses.

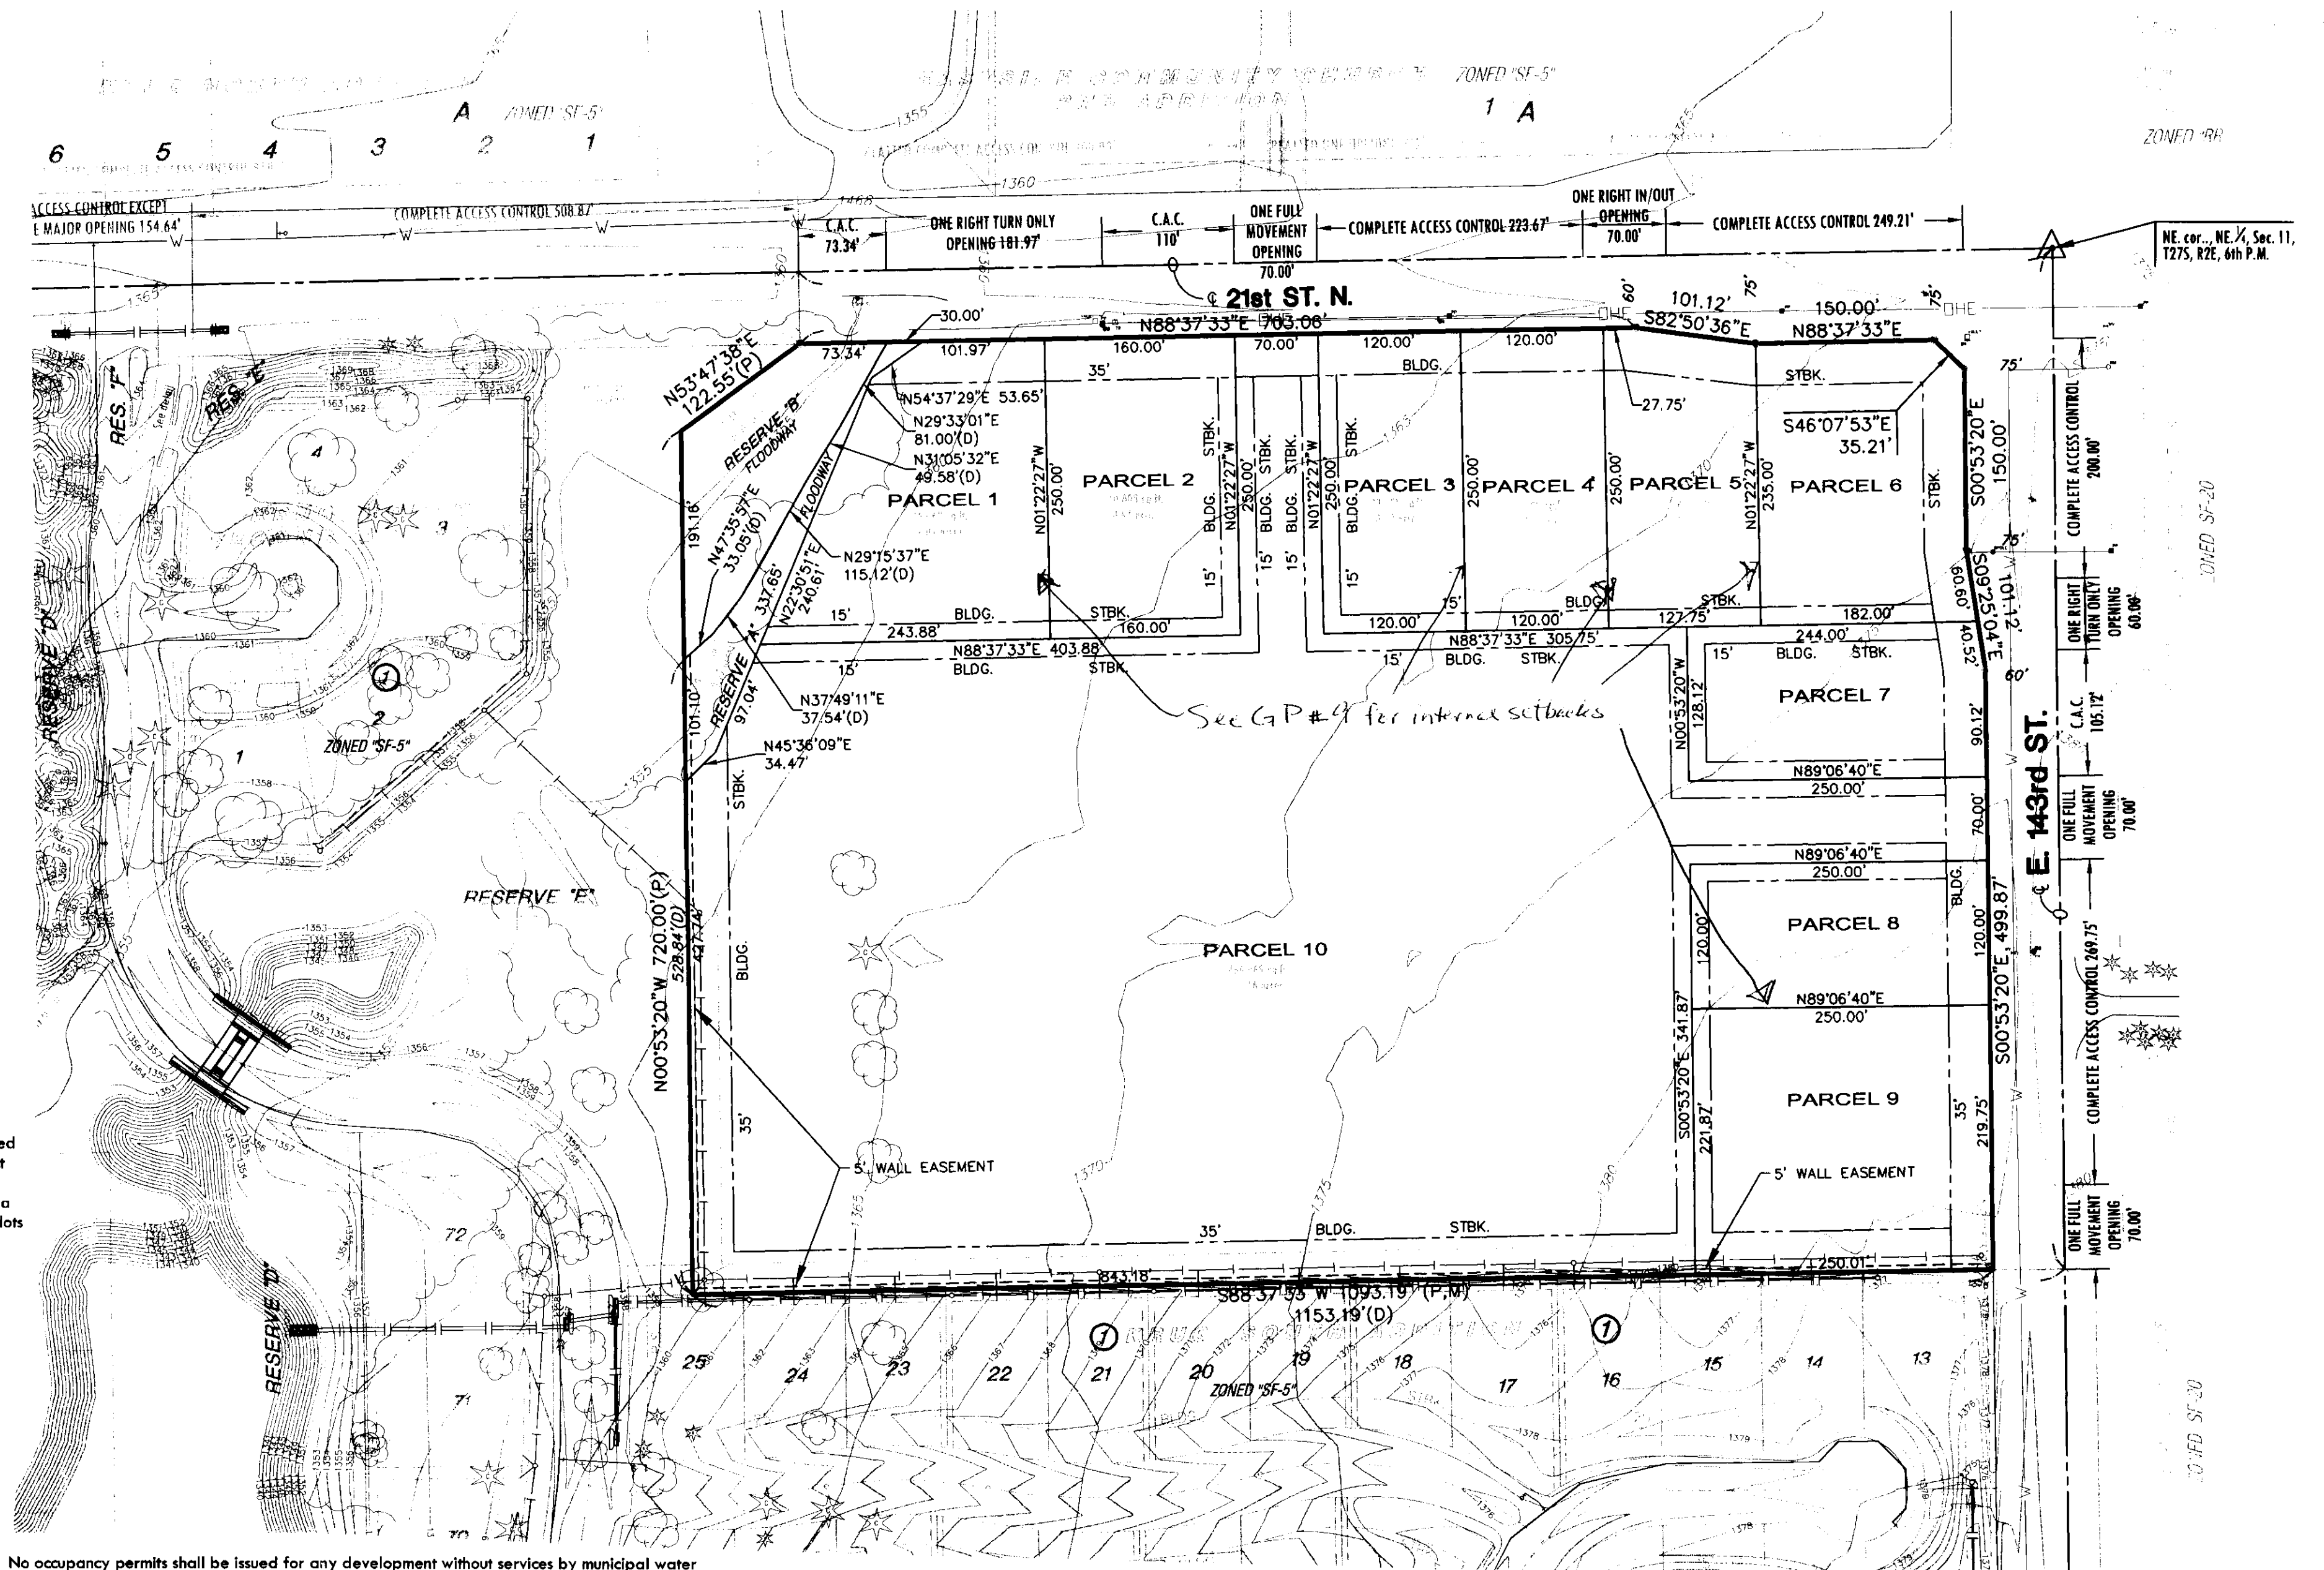


LEGAL DESCRIPTION

A tract of land lying in the Northeast Quarter of Section 11, Township 27 South, Range 2 East of the Sixth Principal Meridian, Wichita, Sedgwick County, Kansas; said tract being more particularly described as follows:

BEGINNING at the northeast corner of said Northeast Quarter, thence along the east line of said Northeast Quarter on a Kansas coordinate system of 1983 south zone grid bearing of S00°53'20"E, 850.00 feet; thence S88°37'33"W, 60.00 feet to the northeast corner of Lot 13, Block 1, Krug South Addition, an addition to Wichita, Sedgwick County, Kansas; thence along a northerly line of said Block 1, said addition, S88°37'33"W, 1093.19 feet to the southeast corner of Reserve "E", said addition; thence along the east line of said Reserve "E", N00°53'20"W, 720.00 feet; thence continuing along said east line of said Reserve "E", N53°47'38"E, 122.55 feet to the northeast corner of said Reserve "E"; thence N01°22'22"W, 60.00 feet to the north line of said Northeast Quarter; thence along said north line, N88°37'33"E, 1053.70 feet to the POINT OF BEGINNING.

- No occupancy permits shall be issued for any development without services by municipal water and sewer services.
- The following transportation improvements and Parcel access shall be provided:
 - Cross-lot circulation agreements shall be required at the time of platting to assure internal vehicular movement between Parcels within the C.U.P.
 - Guarantees for specific street and or signalization improvements shall be determined at the time of final platting. One of which being petition(s) for guarantee construction of left turn center lanes to all major entrances (one on 21st St. and two on 143rd St.) and decel lanes into all four entrances.
 - Access controls shall be as shown on the Final Plat and revised upon the C.U.P.
 - An overall site circulation plan shall be submitted for review and approval by the Director of Planning, in concurrence with the Zoning Administrator and Traffic Engineer. The traffic circulation plan shall assure smooth internal vehicular movements, joint use of Ingress / egress openings as required by the Access Management Policy, and ensure that the main drives are not blocked by parking spaces directly backing onto the main drive aisles. The pedestrian circulation system shall connect all buildings within the development to each other and to the arterial sidewalks on 21st Street and 143rd Street; and may connect to adjoining properties.
 - A site traffic and pedestrian circulation plan for each parcel, upon request for a building permit, shall be reviewed for compliance with the overall site traffic and pedestrian circulation plan.
- Grading Plan:
A lot grading plan will be prepared in conformance with the Drainage Concept Plan for review prior to the issuance of a Building Permit.
- All proposed new utilities shall be installed underground.
- Final determination of minimum pad elevations (at least 2 feet higher than the 100 year flood elevation), street right(s)-of-way, easements, and pavement widths on public private streets shall be resolved at the time of platting.
- The development of this property shall proceed in accordance with the development plan as recommended for approval by the Planning Commission and approved by the Governing Body, and any substantial deviation of the plan, as determined by the Zoning Administrator and the Director of Planning, shall constitute a violation of the building permit authorizing construction of the proposed development.
- Any major changes within this Community Development Plan shall be submitted to the Planning Commission and the Governing Body for their consideration. Amendments, adjustments, or interpretations to the C.U.P. shall be done in accordance with the Unified Zoning Code.

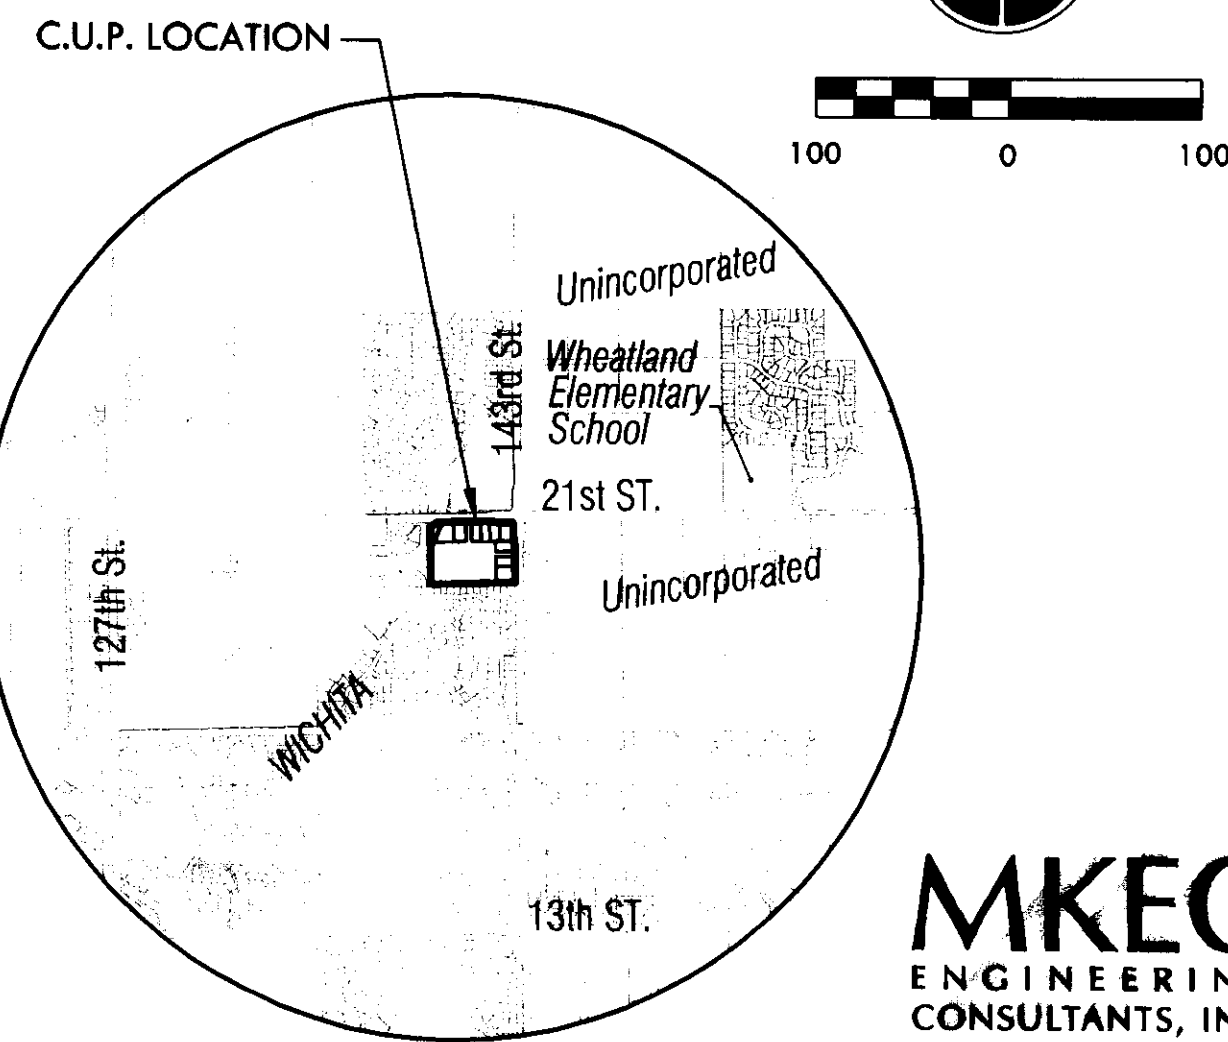

MKEC
ENGINEERING
CONSULTANTS, INC.
411 N. WEBB ROAD
WICHITA, KS. 67206
316-684-9600

COMMUNITY UNIT PLAN DP-302 KRUG SOUTH

AA#1 8-18-2009

Owner / Developer: Bristol Square, LLC, a Kansas limited liability company 8111 E. 32nd St., Suite 101, Wichita, KS, 67226 316.262.3331