



Wichita-Sedgwick County Metropolitan Area Planning Department

November 19, 2007

David Tarhini
902 S Edgemoor
Wichita, KS 6718

Gene Razook
358 N Rock
Wichita, KS 67206

Re: **BZA2007-66**: Zoning Adjustment to the site plan for BZA9-95, and a zoning adjustment to reduce the parking requirement by 10%, from 10 to 9, in LC zoning, generally located south Lincoln and east of S Edgemoor (902 S Edgemoor).

Legal Description: Reserve C Except part deeded to City, Replat of Part of Block 1, Purcell's 5th Addition to Wichita, Sedgwick County, Kansas.

Dear Applicants,

We have reviewed your Zoning Adjustment request to adjust the BZA9-95 site plan, and reduce the parking requirement on the above-referenced property. From reviewing your application we understand that you paved the east 30 feet of this site, in accordance with BZA9-95 Condition 13.

Sec. V-I.2.i. of the Unified Zoning Code allows an adjustment to reduce the parking requirement when the conditions required by Sec. V-I.6. of the Code are met. We find that the BZA9-95 site plan adjustment and reduction of the parking requirement as proposed meets the four conditions required by Sec. V-I.6. of the Code as set out below:

- 1) **Impact on safety and convenience of vehicular and pedestrian circulation**: The proposed site plan adjustment and reduction in parking requirement should have no detrimental impact on the safety and convenience of vehicular and pedestrian circulation in the vicinity of the application area. Sufficient parking should be available for the anticipated need, and the parking does not interfere with public right-of-way.
- 2) **Impact on existing uses in surrounding areas**: The proposed reduction in parking should not impact existing uses in surrounding areas, as all parking for this project should be adequately

City Hall • 10th Floor • 455 North Main • Wichita, Kansas 67202-1688

T 316.268.4421 F 316.268.4390

www.wichita.gov

provided on the site.

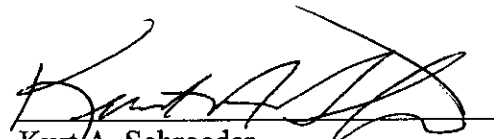
- 3) Compatibility with existing or permitted uses on abutting sites: A reduction of 10% of the parking requirement should not compromise existing or permitted uses on abutting sites, as all parking for this project should be adequately provided on the site.
- 4) Effect on public health, safety or welfare: There will be no encroachment into public right of way or utility easements; therefore there should be no impact on the public's safety, health or welfare.

Our signatures below indicate that an administrative adjustment to adjust the BZA9-95 site plan, and reduce parking by 10%, from 10 to 9 spaces is hereby granted for the aforementioned property subject to the following conditions:

- 1) The site shall be developed in general conformance with the approved site plan.
- 2) The parking area shall be paved and marked.
- 3) If the Zoning Administrator finds that there is a violation of any of the conditions of the Zoning Adjustment, the Zoning Administrator, in addition to enforcing the other remedies set forth in the Unified Zoning Code, may, with the concurrence of the Planning Director, declare the Zoning Adjustment null and void.

The "Development Application" sign should now be removed from the property.


John L. Schlegel
Planning Director

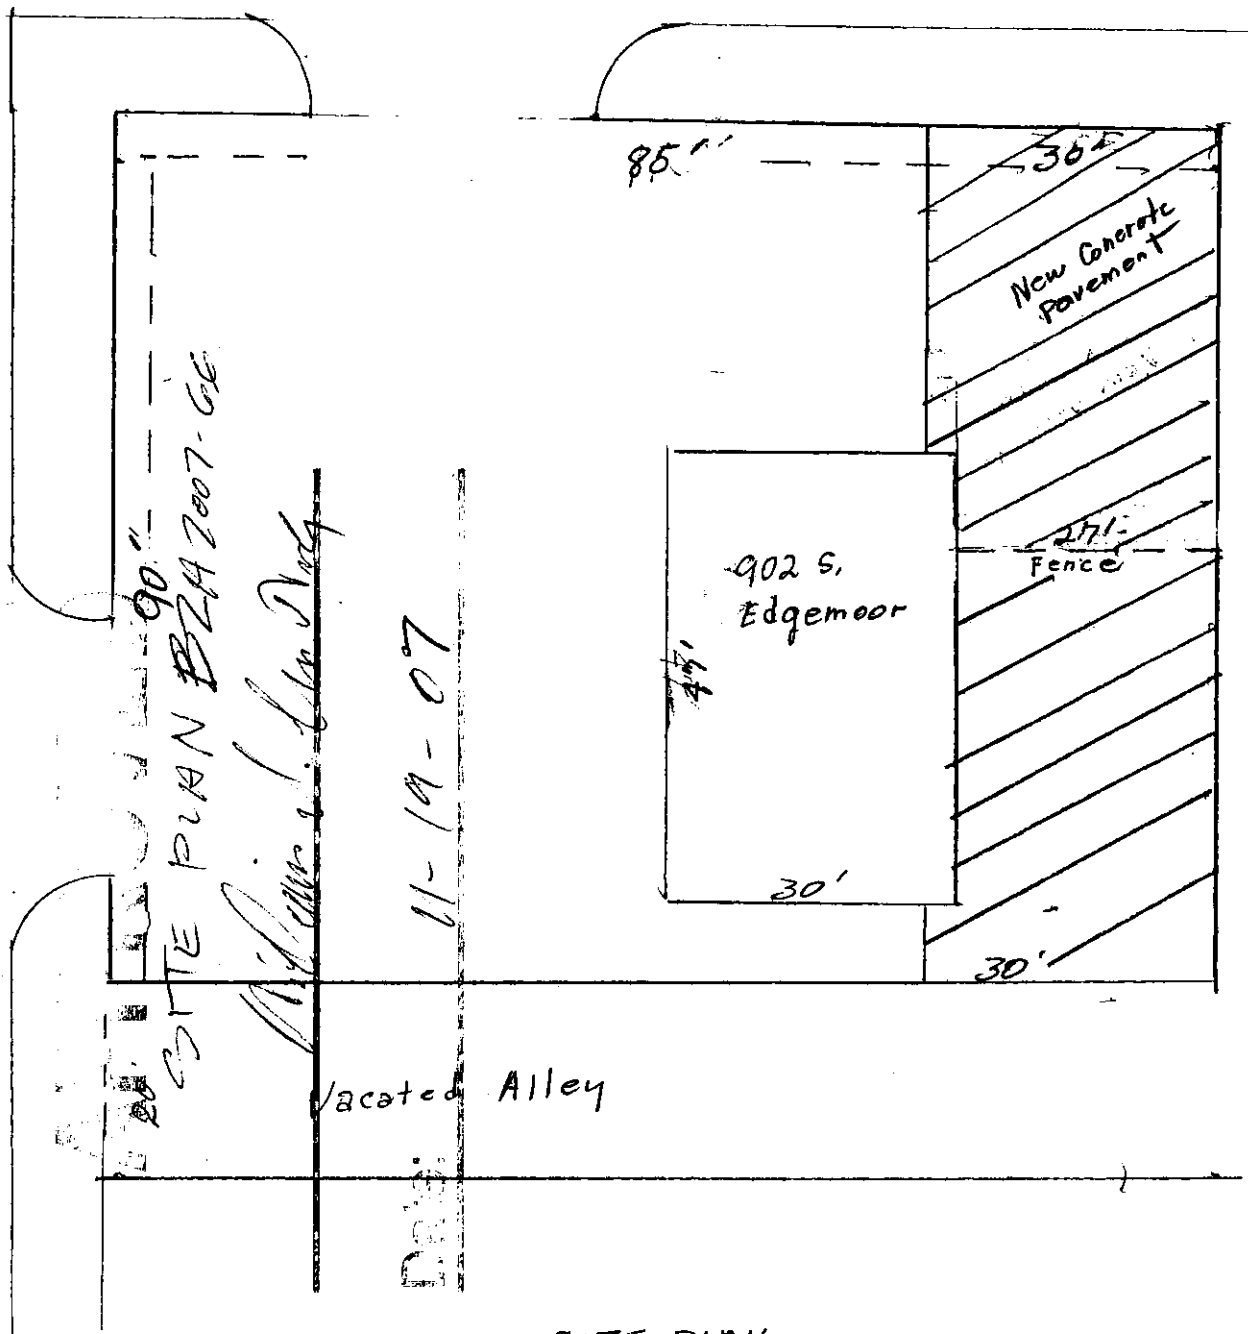

Kurt A. Schroeder
Superintendent of Central Inspection

Enclosure

cc: Kurt Schroeder, OCI
Paul Hays, OCI

LINCOLN

EDGEWOOD



SITE PLAN