


- 2) Impact on existing uses in surrounding areas: There should be no negative impact on the existing uses in surrounding areas as a result of the garage being placed in front of the house, as the structure will be set back 25-feet from the public street.
- 3) Compatibility with existing or permitted uses on abutting sites: Placing an accessory structure in front of a principal structure is within allowable adjustments and should not detract from the existing or permitted uses on abutting sites, which primarily are single family residences.
- 4) Effect on public health, safety or welfare: There will be no encroachment into public utility easements or right-of-way. There will be no negative impact on the public health, safety or welfare, nor will properties or improvements in the vicinity be materially injured.


Our signatures below indicate that a Zoning Adjustment to permit an accessory structure to be placed in front of the principal structure on less than five acres of land for the aforementioned property is hereby GRANTED, subject to the following conditions:

- 1) The site shall be developed in general conformance with the approved site plan, provided a variance or administrative adjustment has been obtained to permit the southeastern corner of the proposed structure to be located as shown on the site plan, and all permits necessary to construct the improvements shall be acquired.
- 2) The permitting of an accessory structure in front of the principal structure shall apply only to the proposed garage illustrated on the approved site plan. All other structures or additions on the subject property shall conform to the development standards of the Unified Zoning Code unless a separate Zoning Adjustment or Variance is granted.
- 3) If the Zoning Administrator finds that there is a violation of any of the conditions of the Zoning Adjustment, the Zoning Administrator, in addition to enforcing the other remedies set forth in the Unified Zoning Code, may, with the concurrence of the Planning Director, declare that the Zoning Adjustment is null and void.

The "Development Application" sign should now be removed from the property.

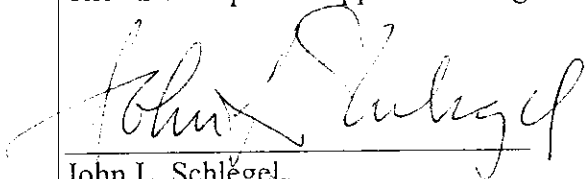


John L. Schlögel
Planning Director

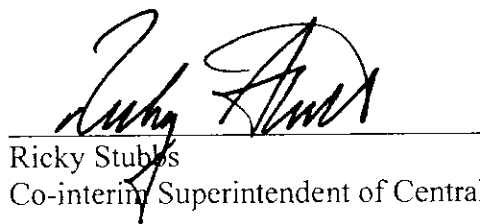

Ricky Stubbs
Co-interim Superintendent of Central Inspection

cc: Rick Stubbs, Office of Central Inspection
J.R. Cox, Office of Central Inspection
Mike Gable, Office of Central Inspection
Janet Miller, CM District VI
Terri Dozal, NA District VI

- THE

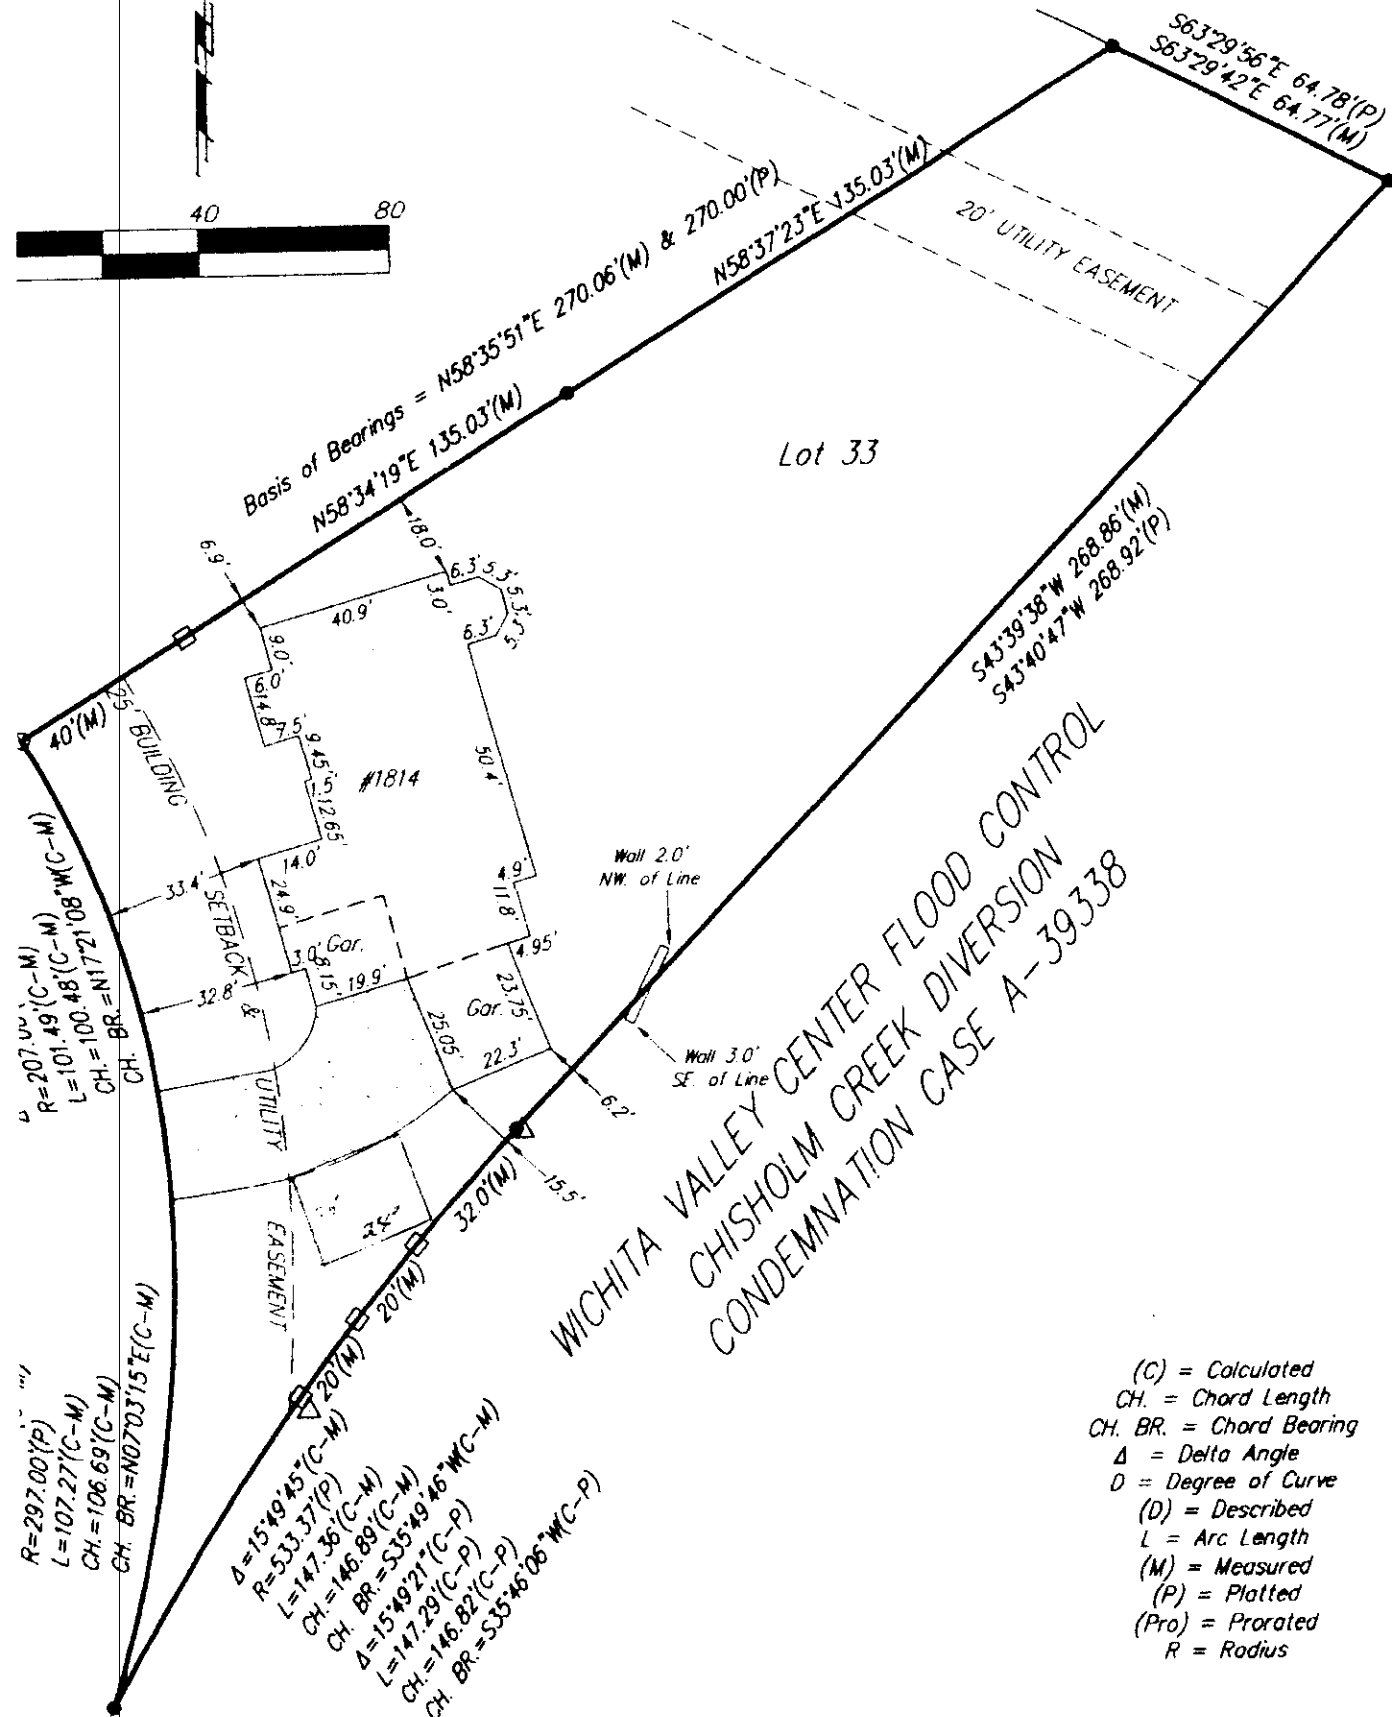

(C) = Calculated
CH. = Chord Length
CH. BR. = Chord Bearing
 Δ = Delta Angle
D = Degree of Curve
(D) = Described
L = Arc Length
(M) = Measured
(P) = Platted
(Pro) = Prorated
R = Radius



Wichita-Sedgwick County Metropolitan Area Planning Department

June 7, 2012

Randall E. Schrag Trustee
Marilyn K. Schrag Rev. Trust
1814 West Harborlight Street

Re: BZA2012-30: City Administrative Adjustment to allow an accessory structure in front of the principal structure on property zoned SF-5 Single-family Residential ("SF-5").

Legal Description: Lots 33, Block 1, Harbor Isle 2nd Addition, Wichita, Sedgwick County, Kansas; generally east of North Meridian Avenue and south of West 53rd Street North (1814 West Harborlight Street.).

Dear Applicants:

We have reviewed your request for a Zoning Adjustment to permit an accessory structure in front of the principal structure on less than five acres. From reviewing your application, we understand that you propose to construct a 20-foot by 24-foot structure on the aforementioned property. We understand that you propose to construct the accessory structure closer to Harborlight than the primary dwelling. Therefore, you have requested a Zoning Adjustment to permit an accessory structure to be placed in front of the principal structure. From the drawing submitted, the southeastern corner of the proposed accessory structure will be located closer to the lot's eastern property line than can be accommodated by an Administrative Adjustment, and will require a variance. This administrative adjustment does not permit any portion of the accessory structure to encroach into the side yard setback.

Sec. V-I.2.n of the Unified Zoning Code allows a Zoning Adjustment that would permit an accessory structure to be placed in front of the principal structure on less than five acres of land, when the conditions required by Sec. V-I.6 of the Code are met. We find that permitting an accessory structure in front of the principal structure on your property meets the four conditions required by Sec. V-I.6 of the Unified Zoning Code as set out below:

- 1) Impact on safety and convenience of vehicular and pedestrian circulation: This request is for a detached accessory structure on a private lot with the structure located 25 feet from the property line, as shown on the attached site plan. Public vehicular and pedestrian circulation will not be affected as the garage will provide space for the property owner's personal property and will not interfere with traffic circulation patterns.

City Hall • 10th Floor • 455 North Main • Wichita, Kansas 67202-1698

T 316.268.4421 **F** 316.268.4390

www.wichita.gov