

feet from the proposed carport.


- 4) Effect on public health, safety or welfare: There will be no encroachment into public utility easements or right-of-way. There should be no impact on the public health, safety or welfare nor will properties or improvements in the vicinity be materially injured.

Our signatures below indicate that a Zoning Adjustment to reduce the side setback from 6 to 4.8 feet for a carport in SF-5 zoning is hereby granted, subject to the following conditions:

- 1) The site shall be developed in general conformance with the approved site plan.
- 2) The adjustment shall apply only to the carport as illustrated on the approved site plan. All other structures or additions on the subject property shall conform to the locations and setbacks permitted by the Unified Zoning Code unless a separate Zoning Adjustment or Variance is granted.
- 3) The applicant shall obtain a building permit within one year of the administrative adjustment approval. The site shall conform to all codes including but not limited to building, health and fire.
- 4) If the Zoning Administrator finds that there is a violation of any of the conditions of the Zoning Adjustment, the Zoning Administrator, in addition to enforcing the other remedies set forth in the Unified Zoning Code, may, with the concurrence of the Planning Director, declare that the Zoning Adjustment is null and void.

The "Development Application" sign should now be removed from the property.


John L. Schlegel
Planning Director

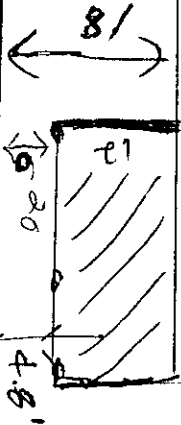

Ricky Stubbs
Interim Co-superintendent of MABCD

cc: Rick Stubbs, Office of Central Inspection
Mike Gable, Office of Central Inspection
Janet Miller, CM District VI
Terri Dozal, NA District VI

711

EMTE PLAN B2A2013-13
APPROVED
William J. Conroy
Date: 4-17-13

UE



3424 N. Amidon



Wichita-Sedgwick County Metropolitan Area Planning Department

April 8, 2013

Alison Brown
3424 N. Amidon
Wichita, KS 67204

Don Rutherford and Sons
807 W. Second St.
Wichita, KS 67203

Re: BZA2013-13: City BZA Administrative Adjustment for a 20% reduction of the required side yard setback in SF-5 Single-family Residential zoning, generally located east of Amidon and north of 33rd Street North (3424 N. Amidon).

Legal Description: LOT 14 BLOCK B PLEASANT VALLEY ADD., Wichita, Sedgwick County, Kansas.

Dear Applicants,

We reviewed your request for a Zoning Adjustment to reduce the side setback by 20% for a carport on the aforementioned property. From reviewing the application and site plan, we understand that you wish to add a carport to the existing house within 4.8 feet of the north side property line. The Zoning Code requires a six foot side setback in SF-5 zoning.

Section V-I.2.a of the Unified Zoning Code allows an administrative adjustment to reduce setbacks by 20% when the provisions of that section and the Zoning Adjustment Criteria of Section V-I.6 are met. We find that reducing the setback by 20% as proposed meets the four criteria required by Section V-I.6 as set out below:

- 1) Impact on safety and convenience of vehicular and pedestrian circulation: The carport location should have no impact on the safety and convenience of vehicular and pedestrian circulation in the vicinity as right-of-way and driveways are not affected.
- 2) Impact on existing uses in surrounding areas: There will be no impact on the existing uses in surrounding areas as a result of the carport location; sufficient separation between the buildings will be maintained and adequate street visibility is maintained for neighboring properties.
- 3) Compatibility with existing or permitted uses on abutting sites: The side setback reduction for a carport will be compatible with the abutting property to the north. The nearest house will be over 18

City Hall • 10th Floor • 455 North Main • Wichita, Kansas 67202-1688

T 316.268.4421 F 316.268.4390

www.wichita.gov