



SEWER SERVICE TABLE

NUMBER	TYPE	LOCATION			FOR INFORMATION ONLY	
		LOT NO.	BLOCK NO.	LINE NO.	STATION	APPROXIMATE LENGTH 4" PIPE
1	8" X 4" Tee Saddle	1	2	1	1+05.0/W	11.5'
2	8" X 4" Tee Saddle	2	2	1	1+05.0/W	9.0'
3	4" Manhole Stub	3	2	1	1+68.93/W	9.0'
4	4" Manhole Stub	4	2	1	3+19.72/NW	9.0'
5	4" Manhole Stub	5	2	1	3+19.72/SW	9.0'
6	4" Manhole Stub	6	2	1	4+51.66/SW	10'
7	4" Manhole Stub	7	2	1	4+51.66/S	8'
8	4" Manhole Stub	8	2	1	5+86.62/SW	
9	4" Manhole Stub	9	2	1	5+86.62/SE	

NOTE: 1. All Riser Pipe shall be extended to 2' minimum above ground water elevation and 4' minimum below proposed ground elevation.

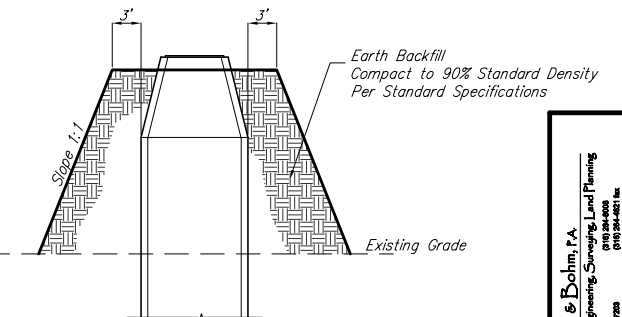

SEE REVISED SHEET

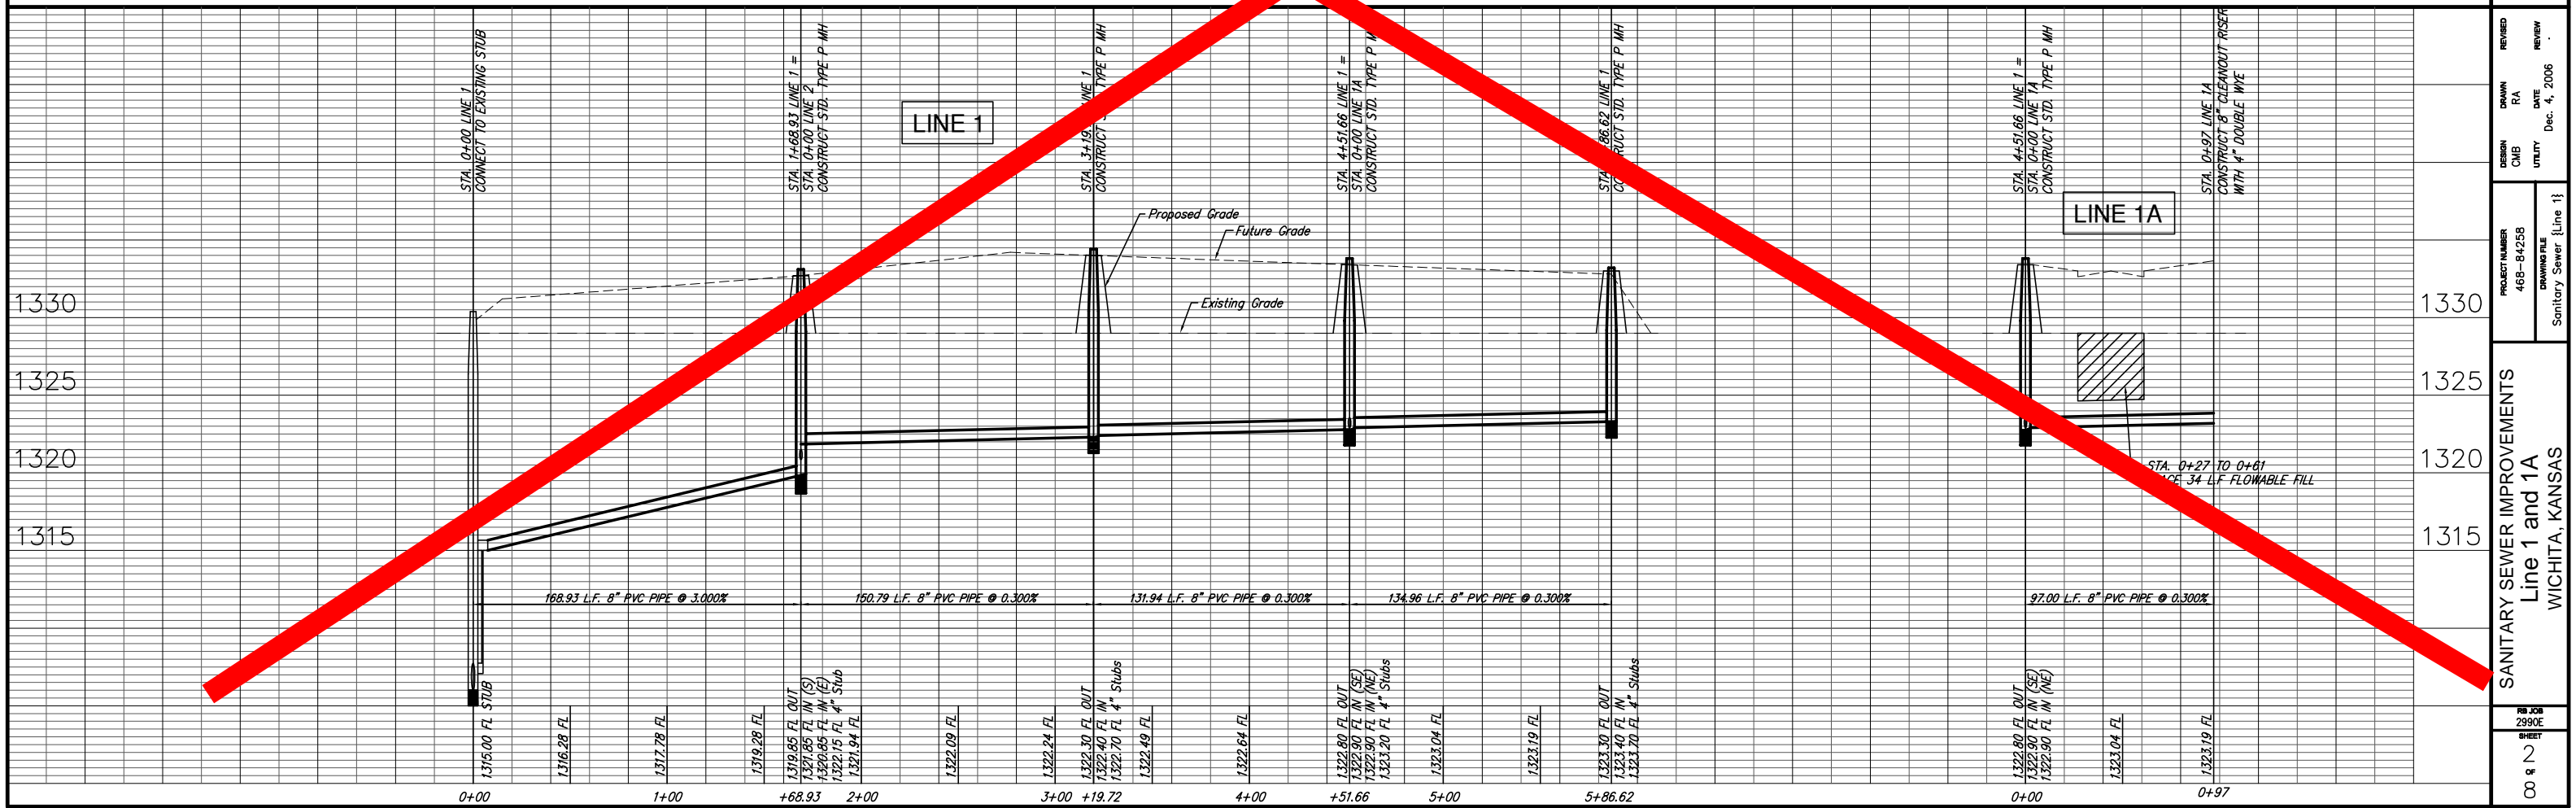

**Ruggles & Bohm, P.A.**  
 Engineering, Surveying, Land Planning  

PROJECT NUMBER: 468-84258  
 DRAWING FILE: Sanitary Sewer (Line 1)  
 DESIGN: CMB  
 DRAWN: RA  
 CHECKED: RA  
 DATE: Dec. 4, 2006  
 REVIEW:

SANITARY SEWER IMPROVEMENTS  
 Line 1 and 1A  
 WICHITA, KANSAS

JOB NO: 2990E  
