




GARDINER
ACRES
FIRST
ADDITION

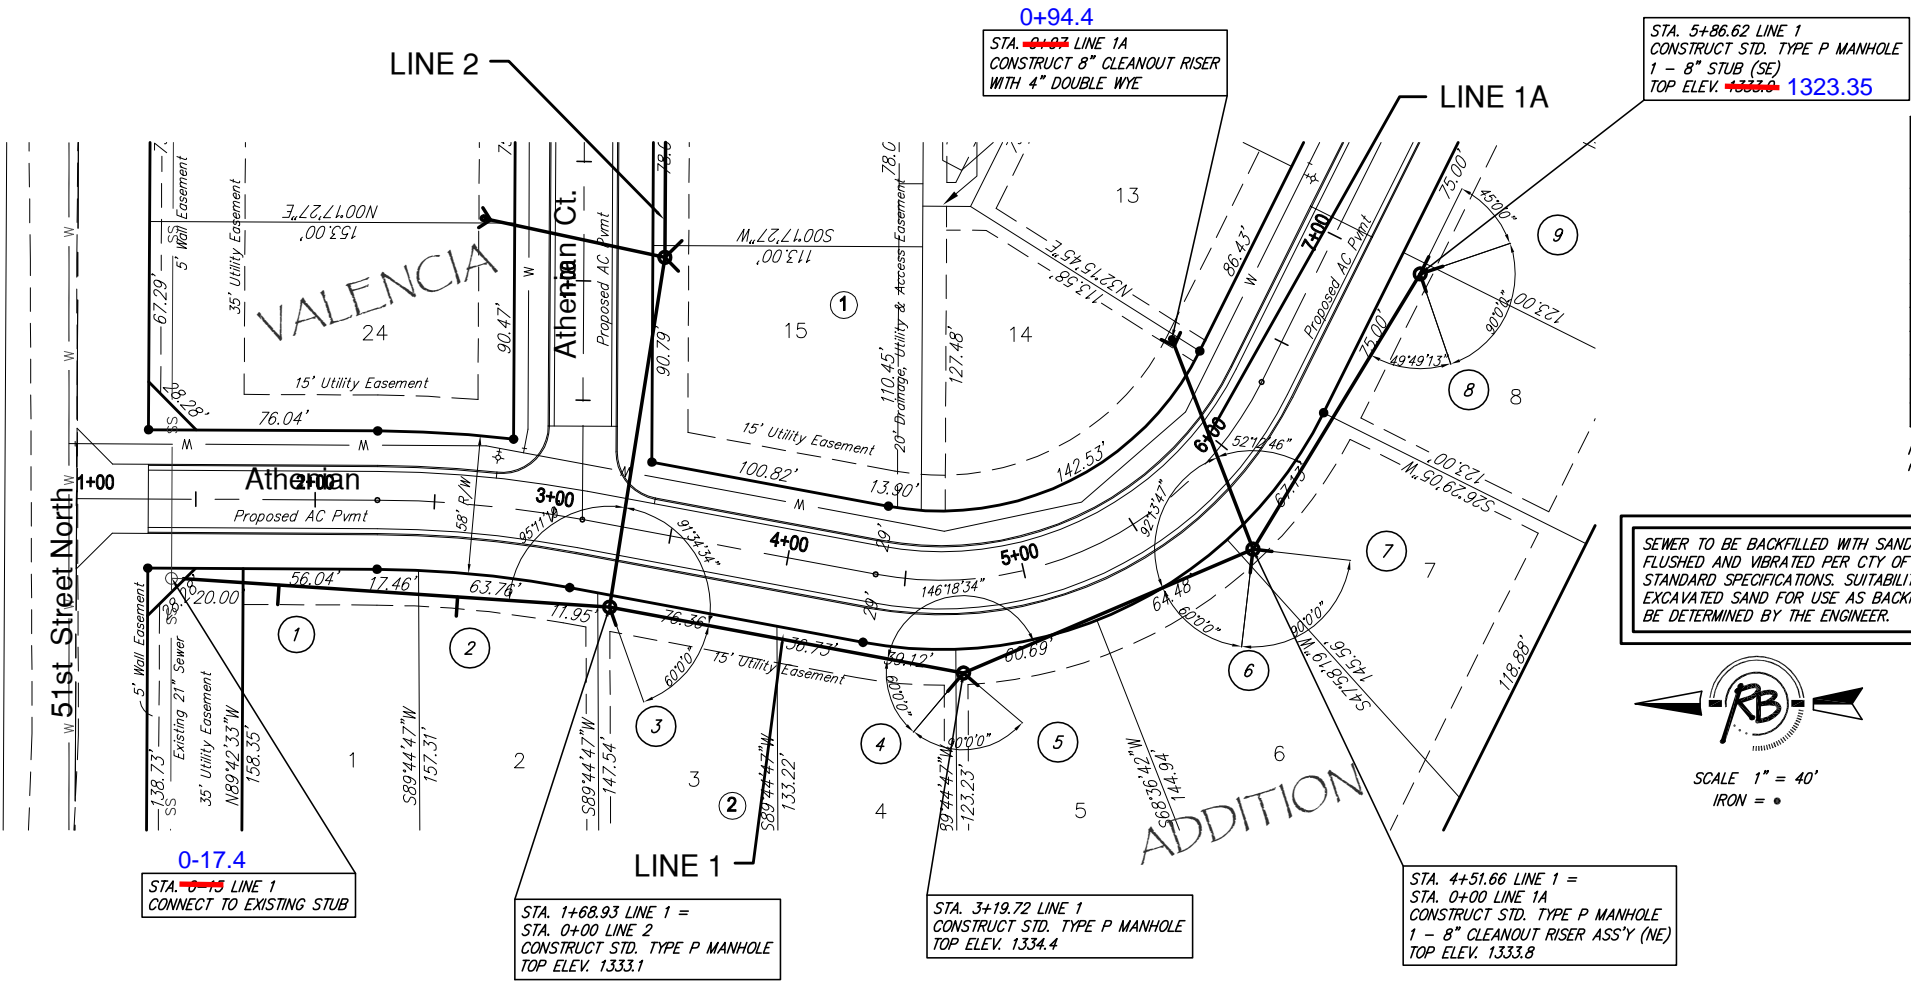


SEWER SERVICE TABLE

NUMBER	TYPE	LOCATION			FOR INFORMATION ONLY		
		LOT NO.	BLOCK NO.	LINE NO.	STATION \ DIRECTION	APPROXIMATE LENGTH 4" PIPE	VERTICAL
1	8" X 4" Tee Saddle	1	2	1	0+ 00 /W 29.36	11.5'	8'
2	8" X 4" Tee Saddle	2	2	1	1+ 00 /W 06.11	9.0'	8'
3	4" Manhole Stub	3	2	1	1+68.93/W	9.0'	8'
4	4" Manhole Stub	4	2	1	3+19.72/NW	9.0'	10'
5	4" Manhole Stub	5	2	1	3+19.72/SW	9.0'	8'
6	4" Manhole Stub	6	2	1	4+51.66/SW	0'	10'
7	4" Manhole Stub	7	2	1	4+51.66/S	0'	8'
8	4" Manhole Stub	8	2	1	5+86.62/SW	0'	24" W/cap
9	4" Manhole Stub	9	2	1	5+86.62/SE	0'	24" W/cap
20 & 21	4" Double Wye	13, 14	1	1A	0+89.4 E&N	0'	18" W/cap

NOTE: Vertical Riser Pipe shall be extended to 2' minimum above ground water elevation and 4' maximum below proposed ground elevation.

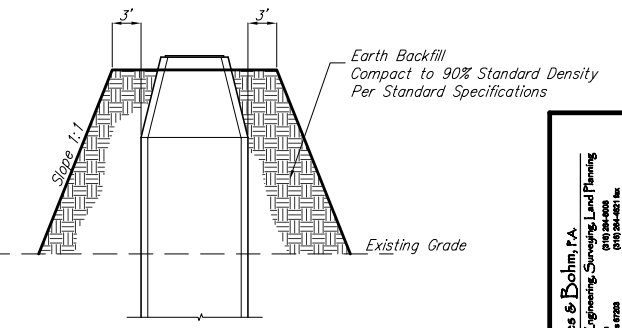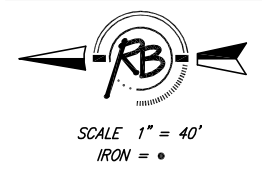

FILL PLACEMENT DETAIL
(To be paid for as "Easement Grading - L.S.")

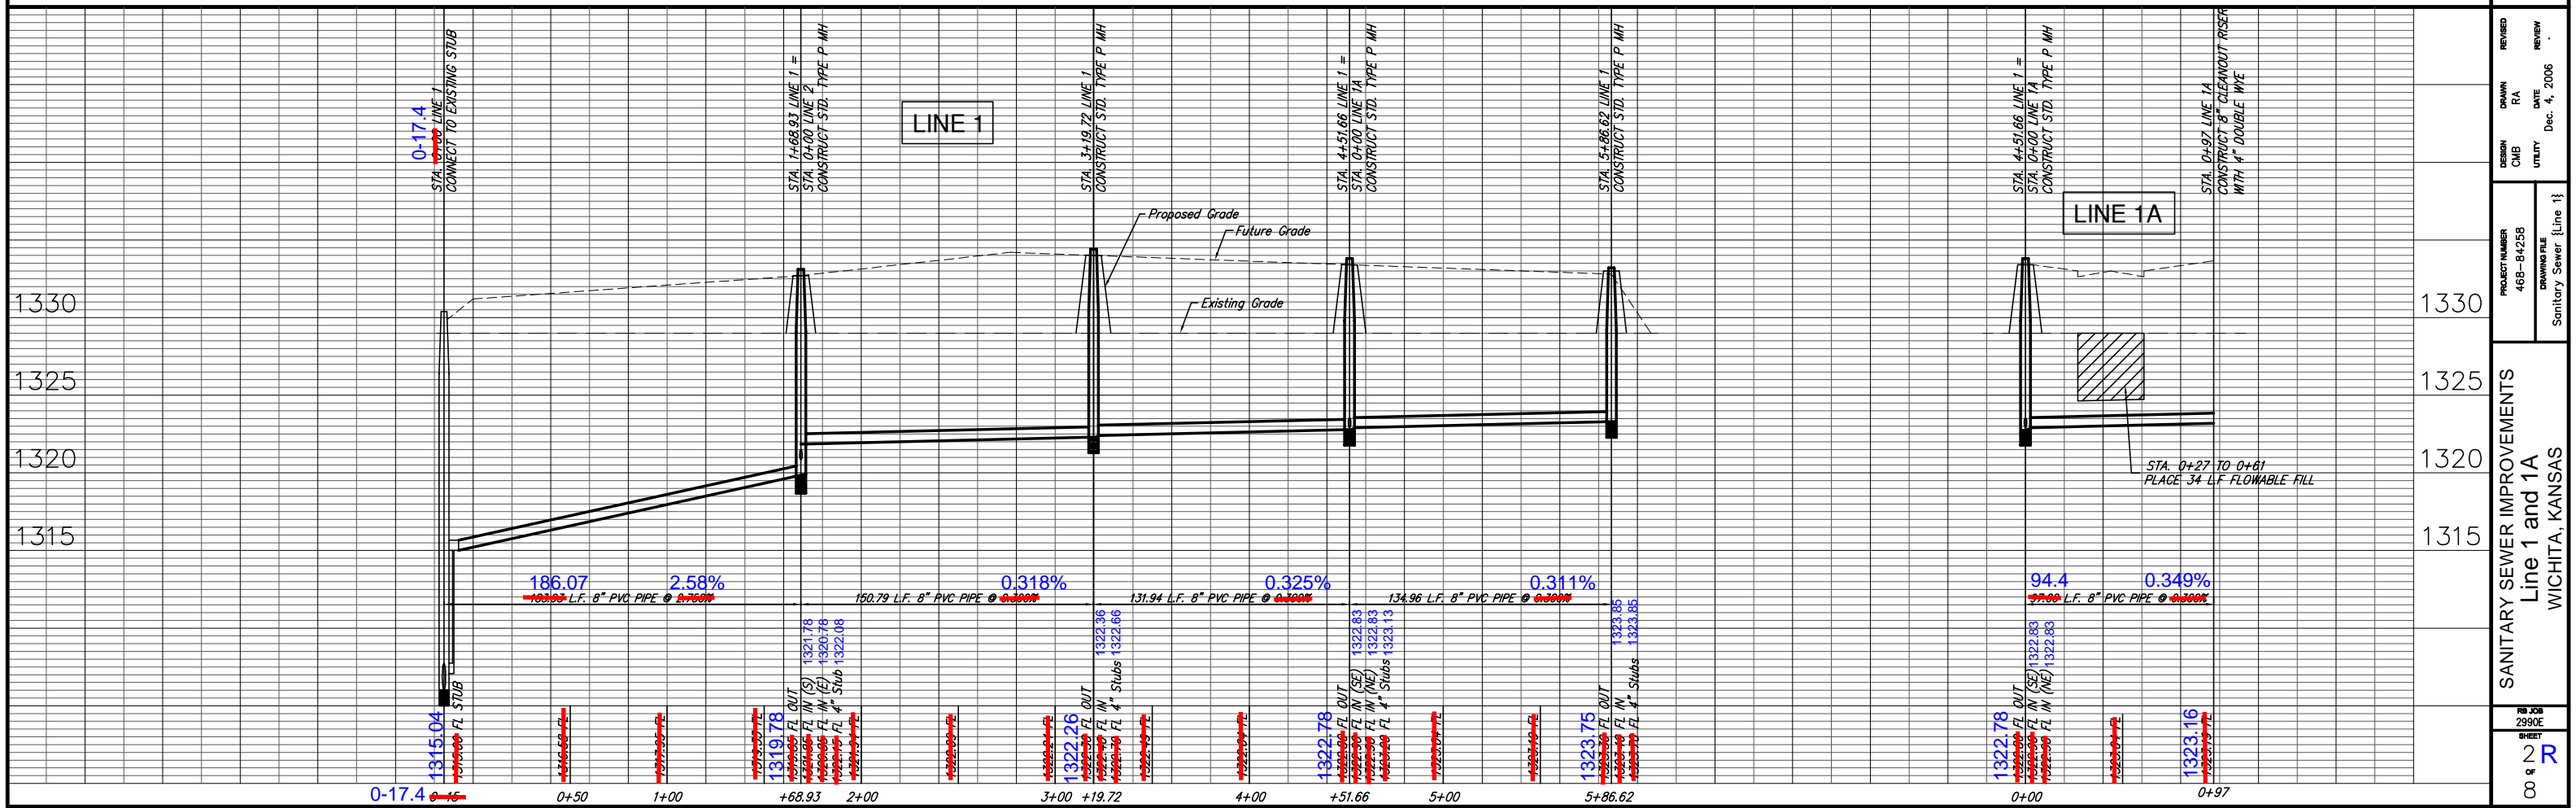

Ruggles & Bohm, P.A.
Engineering, Surveying, Land Planning

PROJECT NUMBER
468-84258

DRAWING FILE
Sanitary Sewer (Line 1)

DESIGN
CMB

DRAWN
RA

REVIEW
RA

DATE
Dec. 4, 2006

UTILITY

SANITARY SEWER IMPROVEMENTS
Line 1 and 1A
WICHITA, KANSAS

2990E
SHEET
2 R