


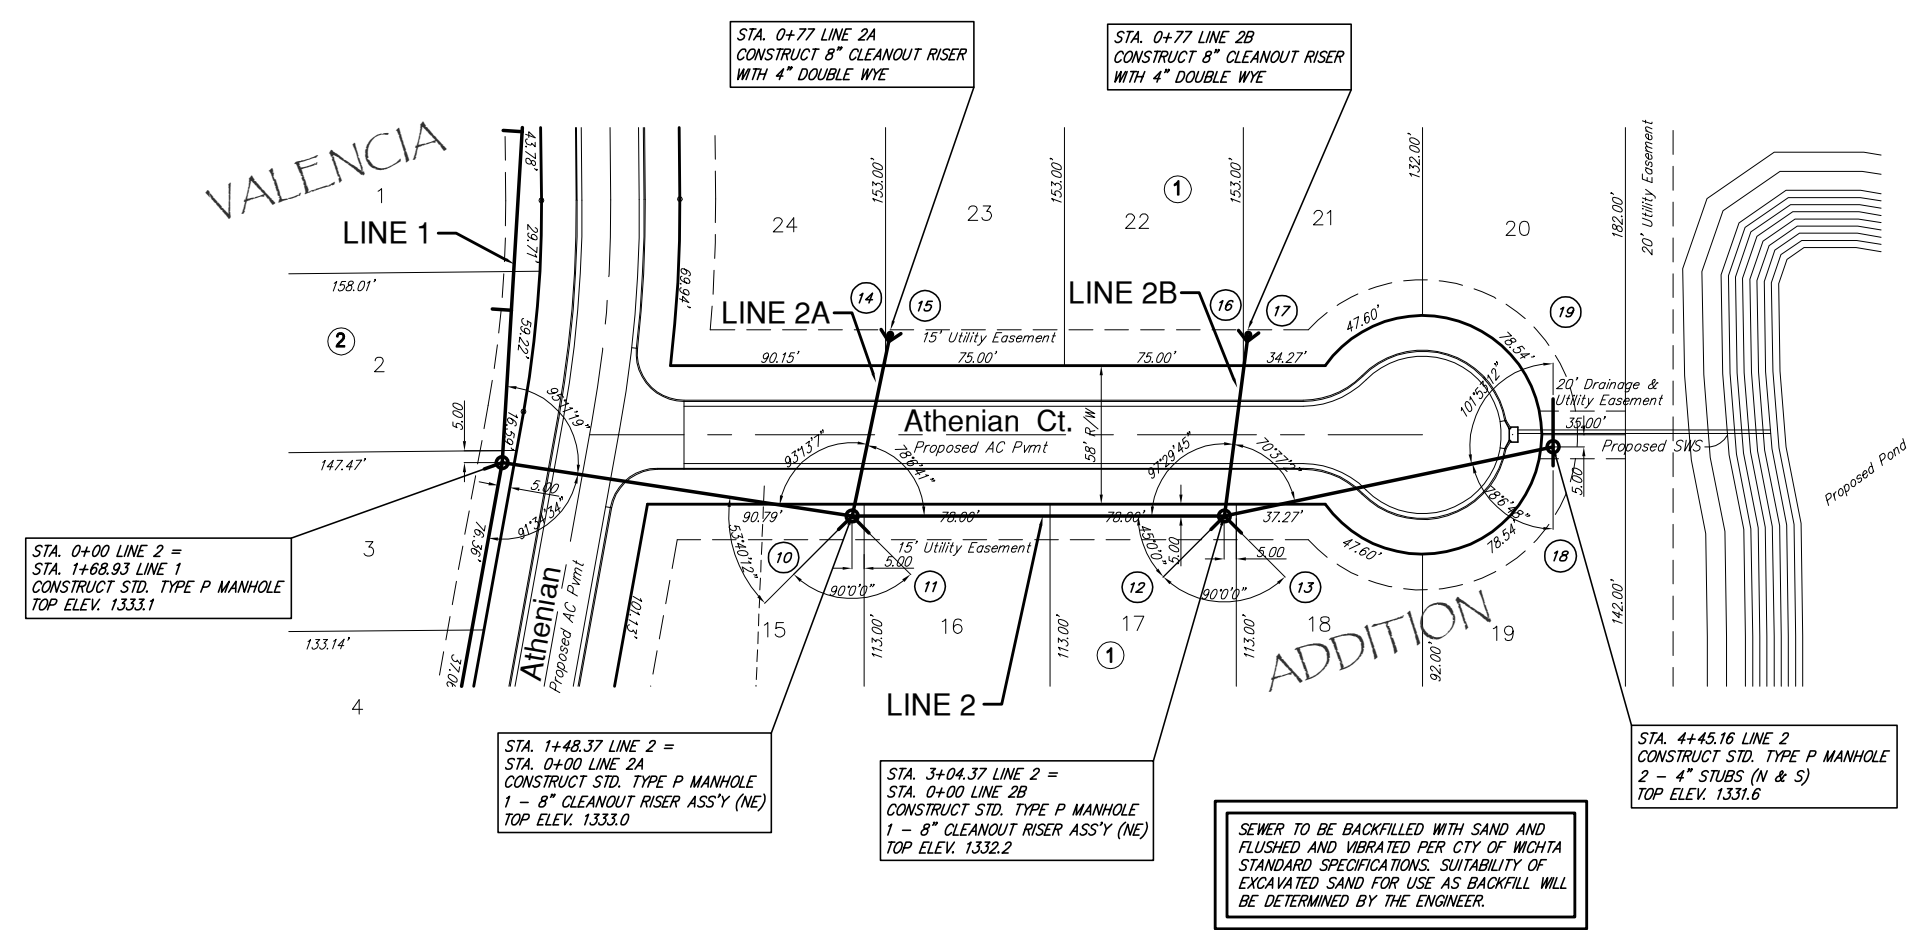

SCALE 1" = 40'
IRON = •




SEWER SERVICE TABLE

NUMBER	TYPE	LOCATION				FOR INFORMATION ONLY	
		LOT NO.	BLOCK NO.	LINE NO.	STATION \ DIRECTION	APPROXIMATE LENGTH 4" PIPE VERTICAL	HORIZONTAL
10	4" Manhole Stub	15	1	2	1+48.37/SW	9'	8'
11	4" Manhole Stub	16	1	2	1+48.37/SE	9'	10'
12	4" Manhole Stub	17	1	2	3+04.37/SW	7.5'	8'
13	4" Manhole Stub	18	1	2	3+04.37/SE	7.5'	10'
14	4" Double Wye	24	1	2A	0+77/NW	6'	8'
15	4" Double Wye	23	1	2A	0+77/NE	6'	8'
16	4" Double Wye	22	1	2B	0+77/NW	6'	8'
17	4" Double Wye	21	1	2B	0+77/NE	6'	8'
18	4" Manhole Stub	19	1	2	4+45.16/S	4.5'	6'
19	4" Manhole Stub	20	1	2	4+45.16/N	4.5'	20'

NOTE: Vertical Riser Pipe shall be extended to 2' minimum above ground water elevation and 4' maximum below proposed ground elevation.

SEWER TO BE BACKFILLED WITH SAND AND FLUSHED AND VIBRATED PER CITY OF WICHITA STANDARD SPECIFICATIONS. SUITABILITY OF EXCAVATED SAND FOR USE AS BACKFILL WILL BE DETERMINED BY THE ENGINEER.

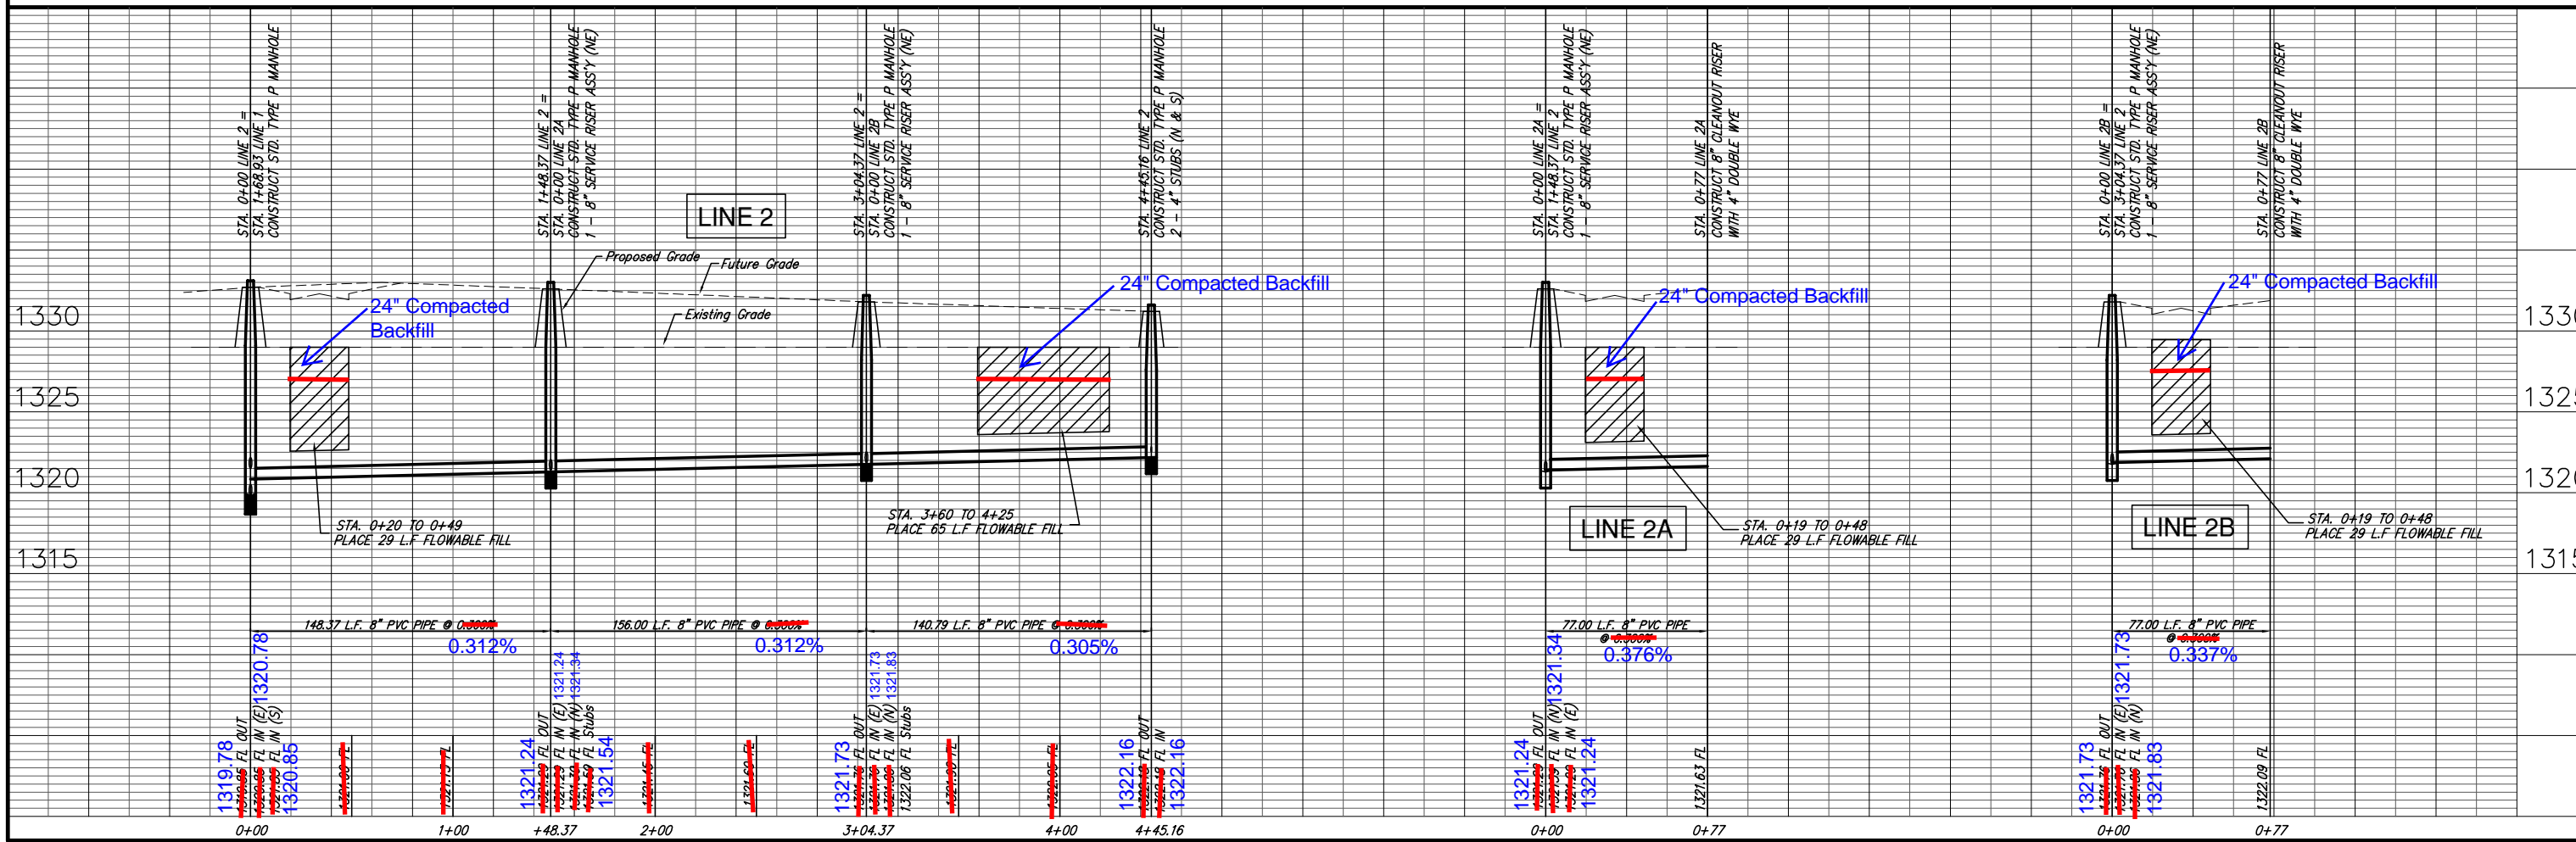

Ruggles & Bohm, P.A.
Engineering, Surveying, Land Planning



DESIGN CMB
RA
REVIEW
DATE Dec. 4, 2006

PROJECT NUMBER 468-84258
DRAWING FILE Sanitary Sewer (Line 2)

SANITARY SEWER IMPROVEMENTS
Line 2
WICHITA, KANSAS

RB JOB 2990E
SHEET 3