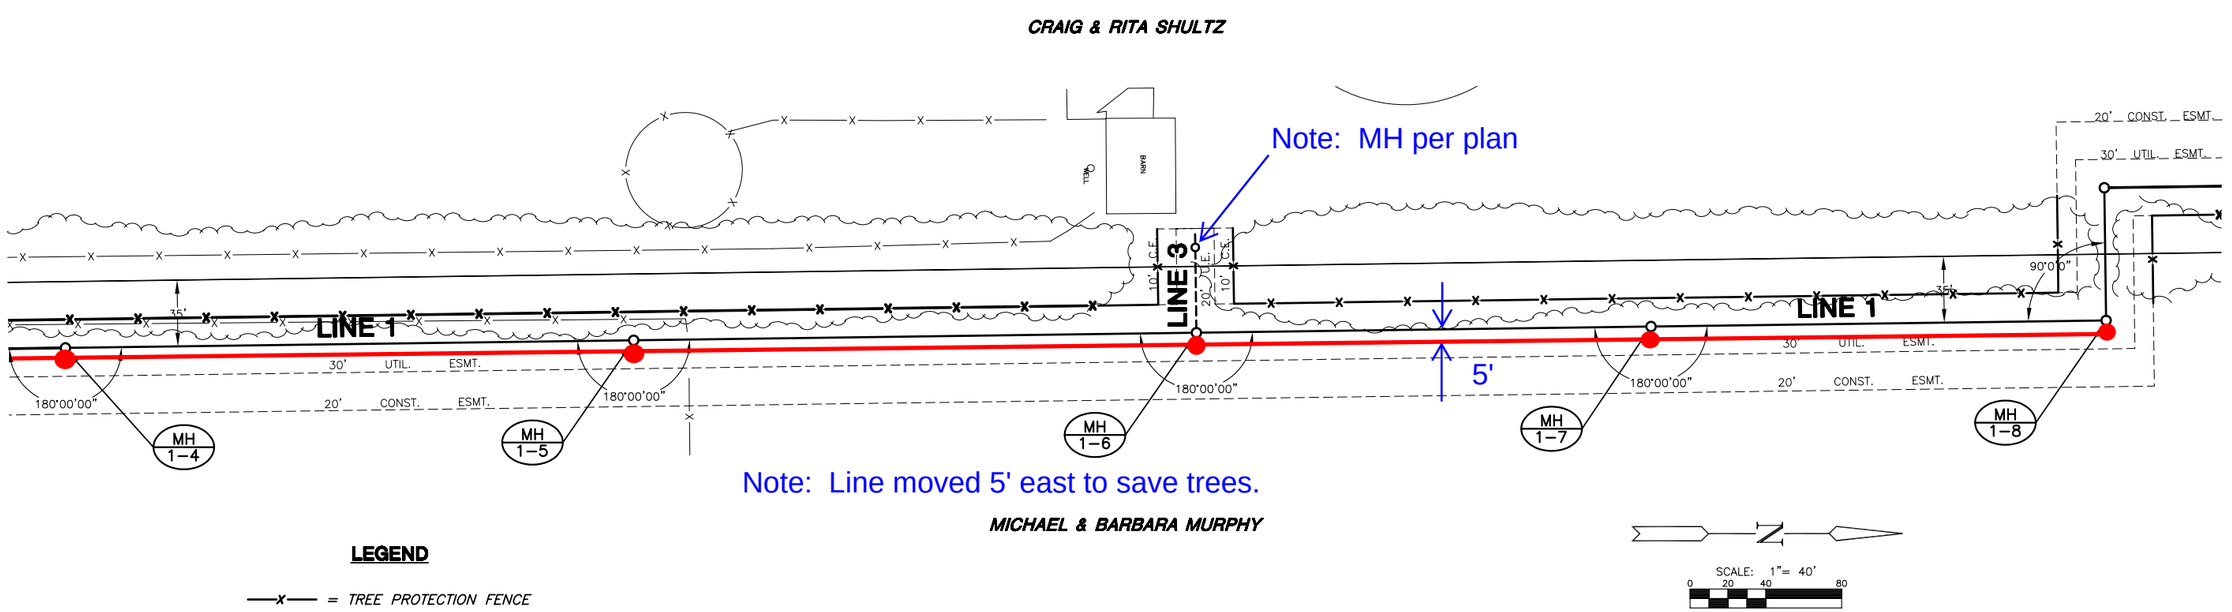

PLAN LINE 1

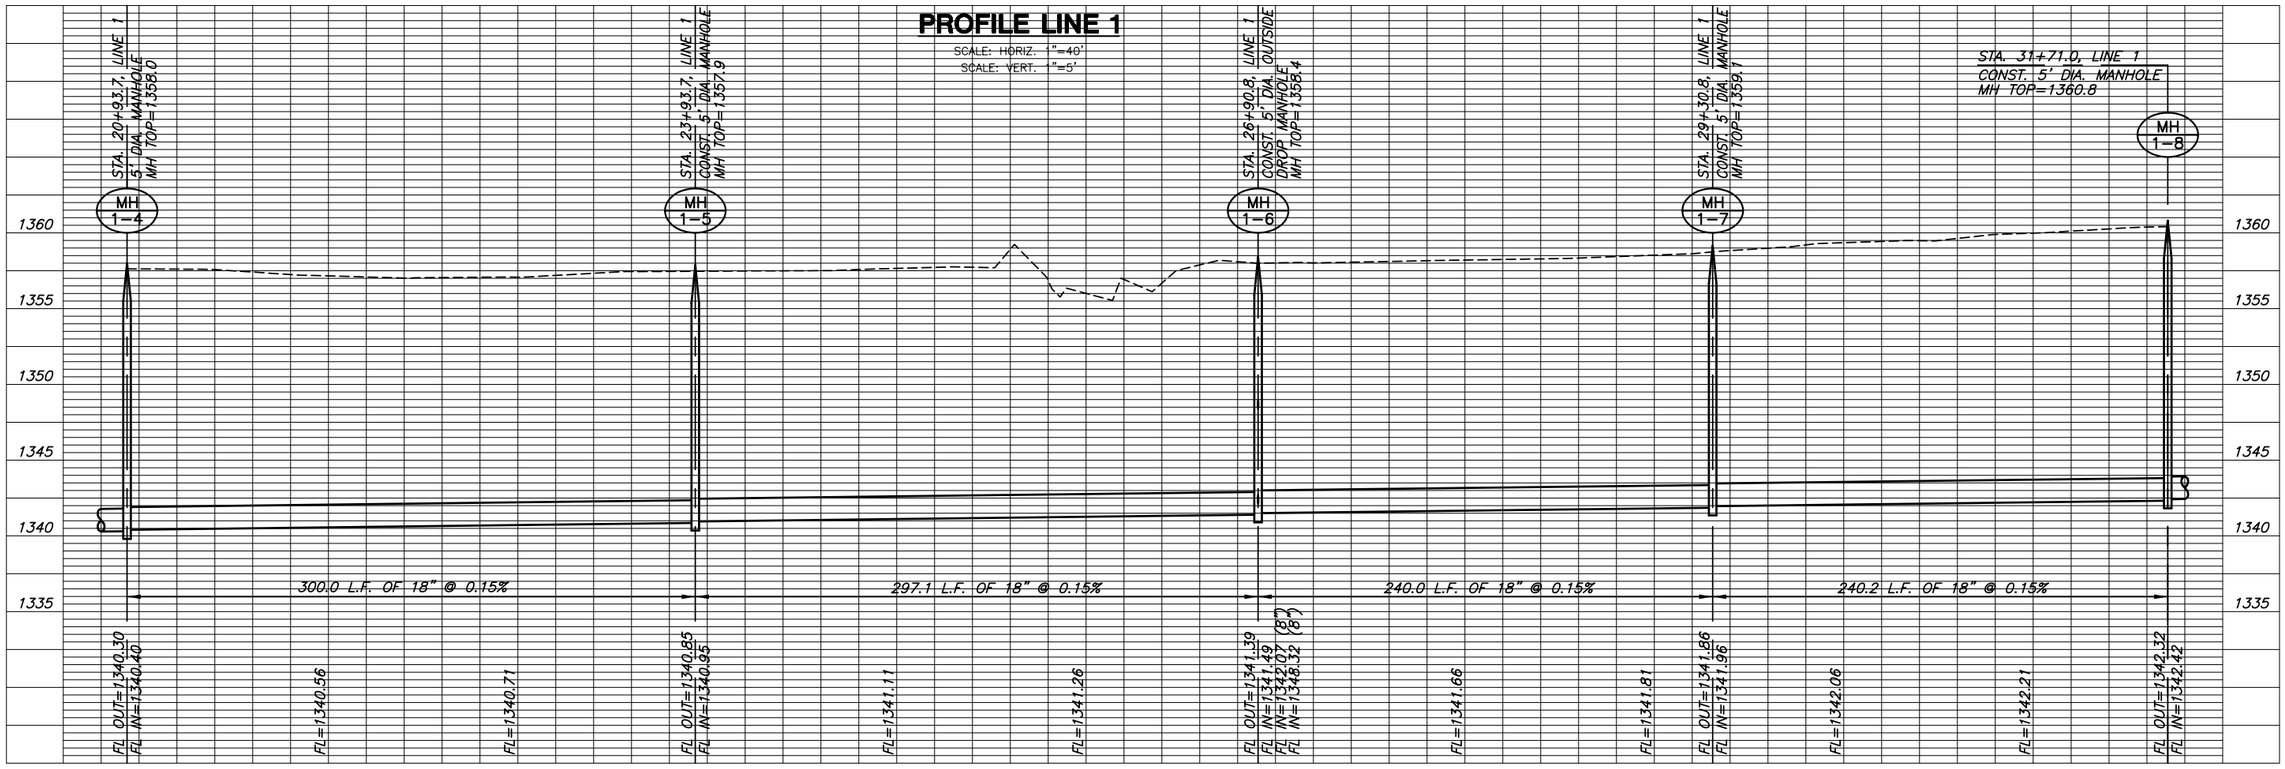

MKEC ENGINEERING CONSULTANTS, INC.
411 N. WEBB ROAD
WICHITA, KS. 67206
316 - 684 - 9600

SANITARY SEWER MAIN PLANS

MONARCH LANDING

WICHITA, KS

LINE 1
SHEET TITLE

468-84206
PROJECT NUMBER

BW
DESIGN BY

DFL
DRAWN BY

DFL
CHECKED BY

ISSUED
March 2007
REVISED

SHEET NO.
5 of 13

J:\CIVIL\06201\SS MAIN\DWG\SAN\6201_B2.DWG

PLOTTED: Friday, March 02, 2007 @ 09:26AM