


**SANITARY SEWER MAIN PLANS**  
**MONARCH LANDING**  
WICHITA, KS

**LINE 2 & 3**  
SHEET TITLE  
468-84206  
PROJECT NUMBER


DESIGN BY *BW*  
DRAWN BY *DFL*  
CHECKED BY *DFL*

ISSUED *March 2007*  
REVISED


SHEET NO.  
**7 of 13**

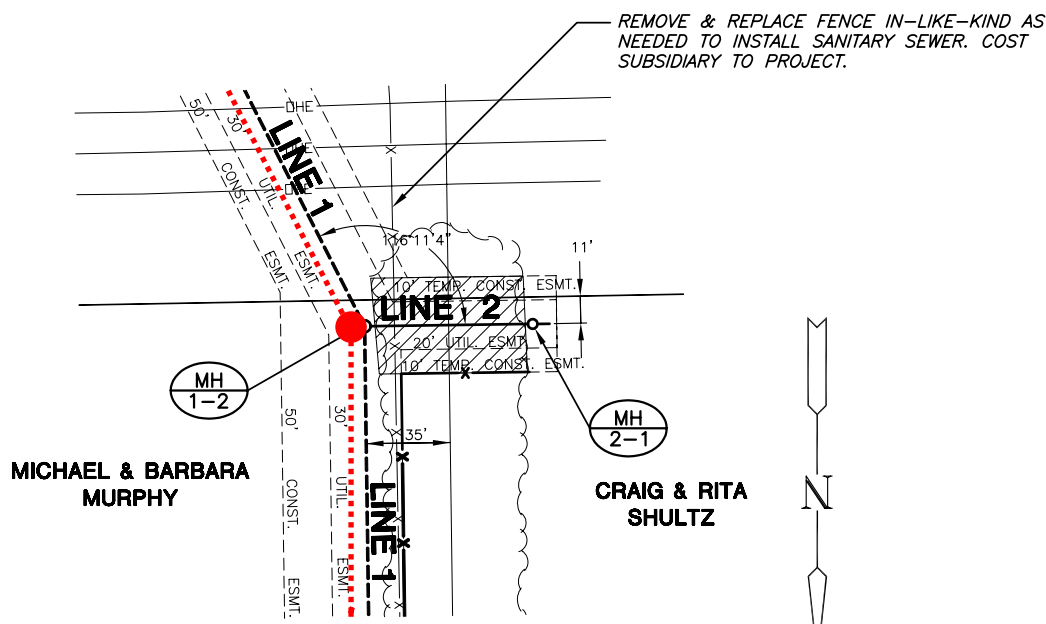

**PLAN LINE 2**

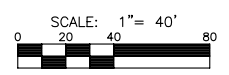

**LEGEND**  
 -X- = TREE PROTECTION FENCE  
 [Hatched Box] = TREE REMOVAL

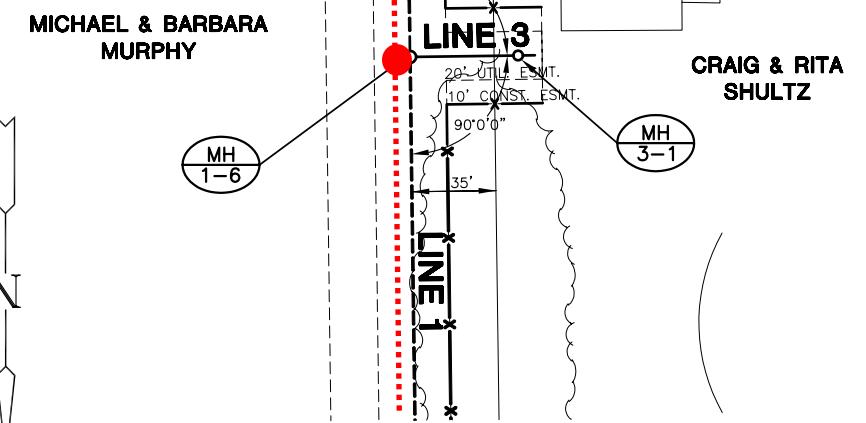

**PLAN LINE 3**

