
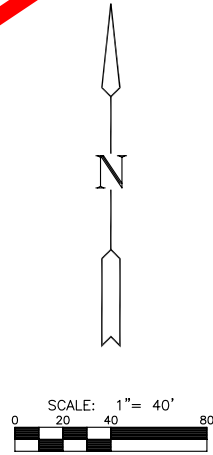



SEE REVISED SHEET

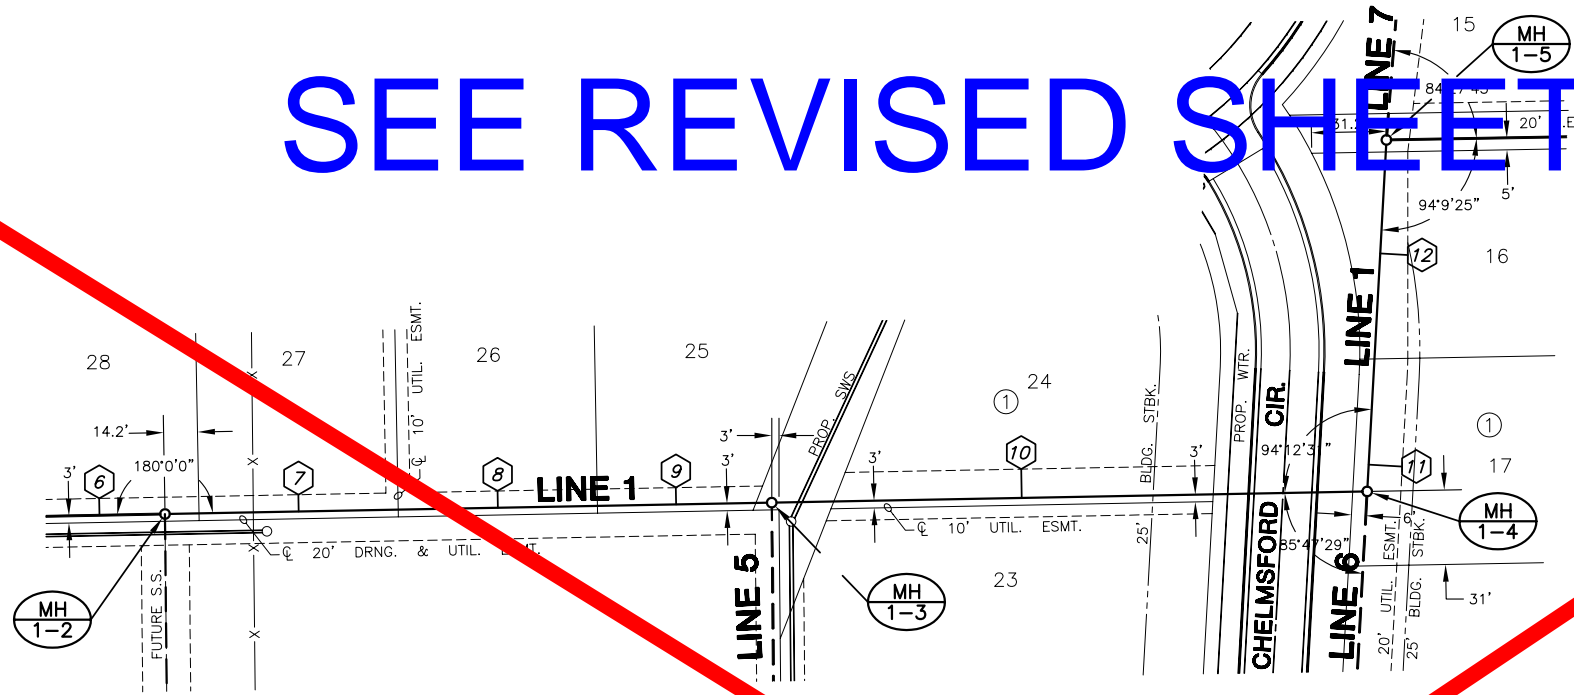

PLAN LINE 1

PROFILE LINE 1

SCALE: HORIZ. 1" = 40'
SCALE: VERT. 1" = 5'

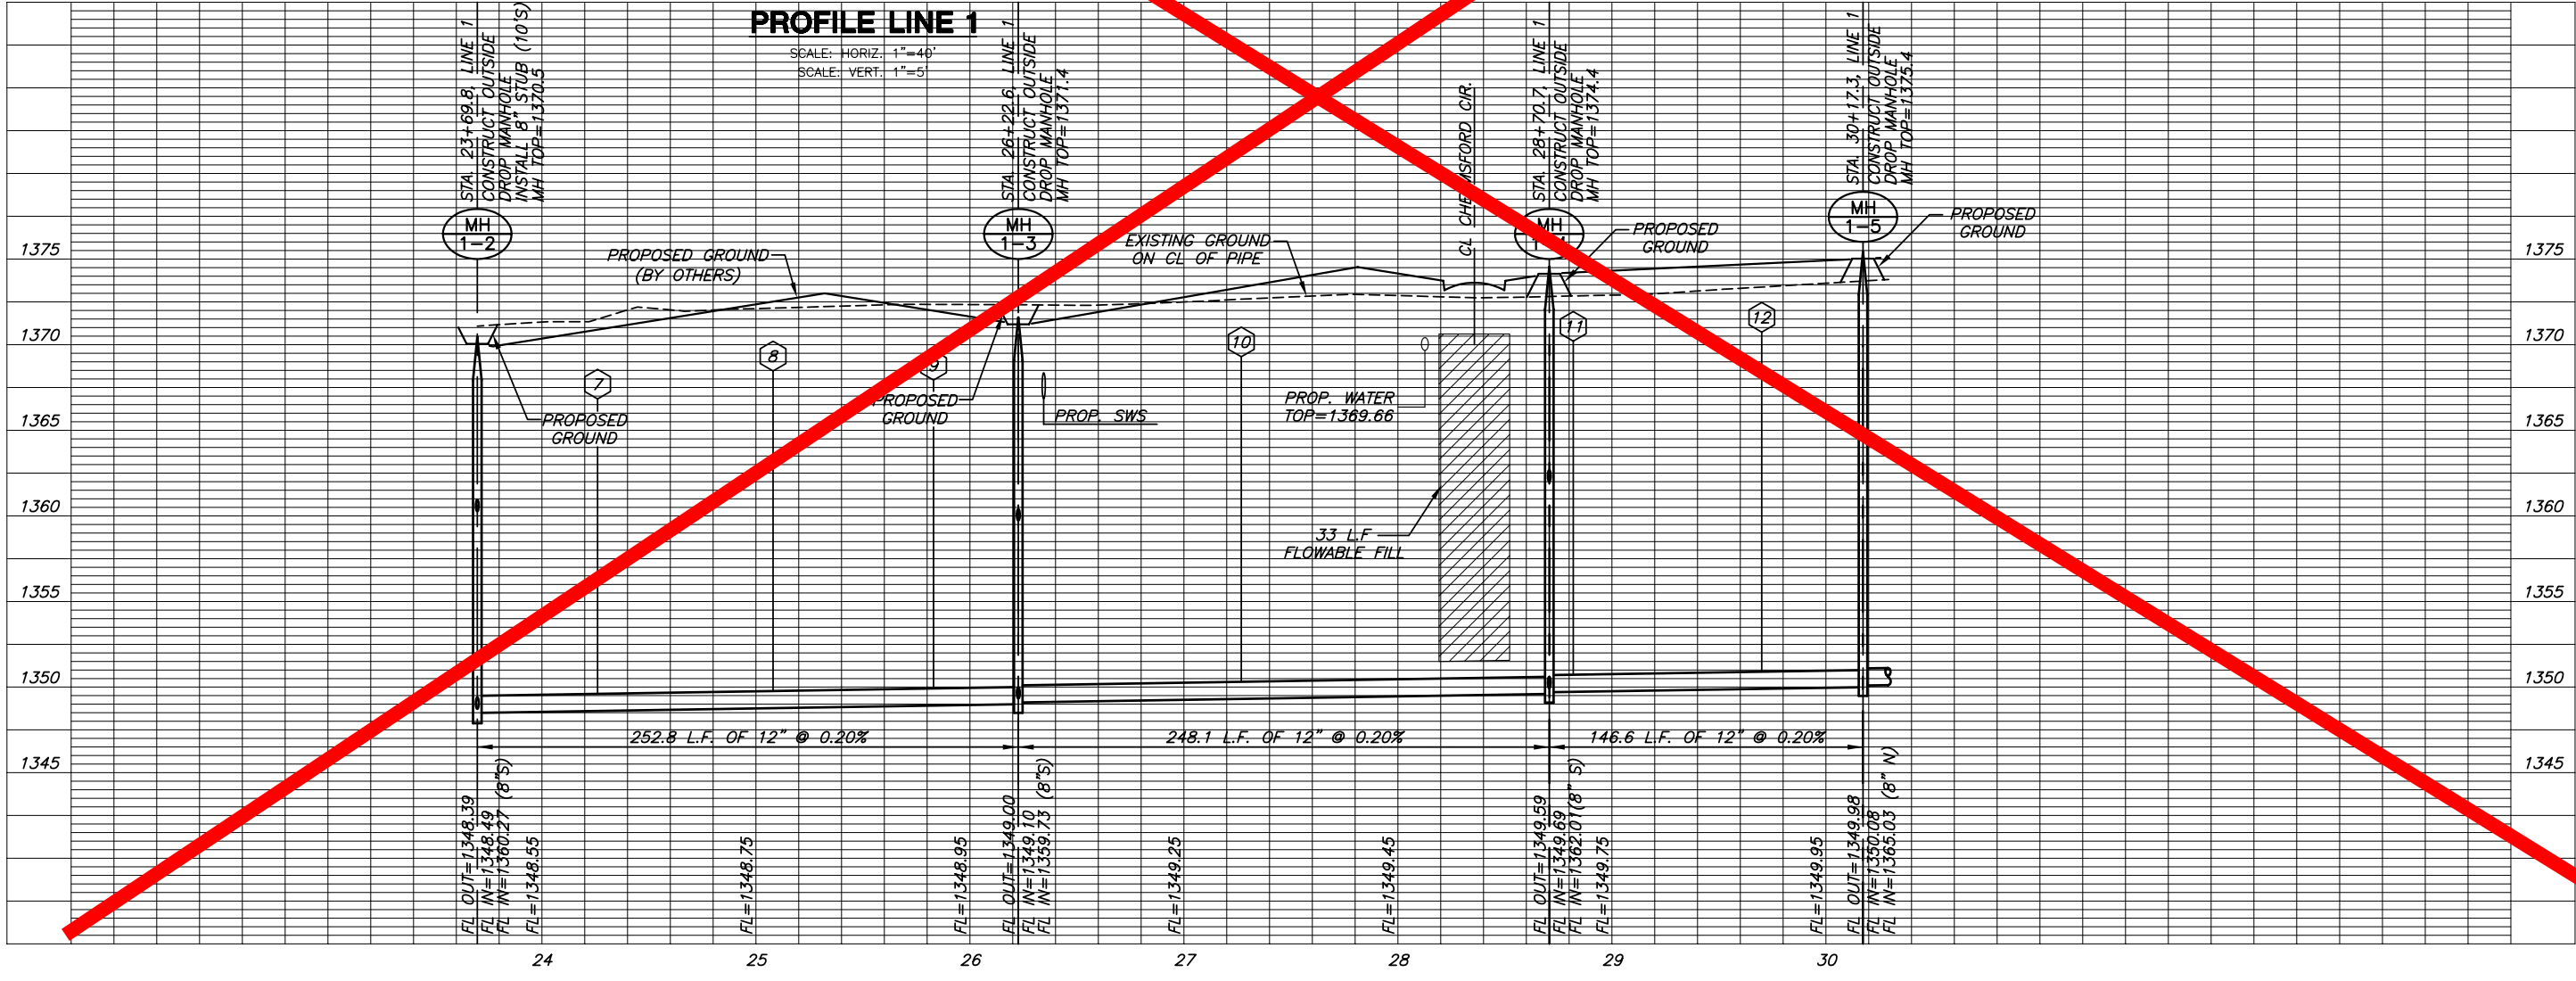

SANITARY SEWER PLANS FOR
MONARCH LANDING ADDITION
PHASE 1

LINE 1
SHEET TITLE
468-84317
PROJECT NUMBER

DFL
DESIGN BY
DMU
DRAWN BY
GJA
CHECKED BY

ISSUED
January 2007

REVISED