



# SEE REVISED SHEET

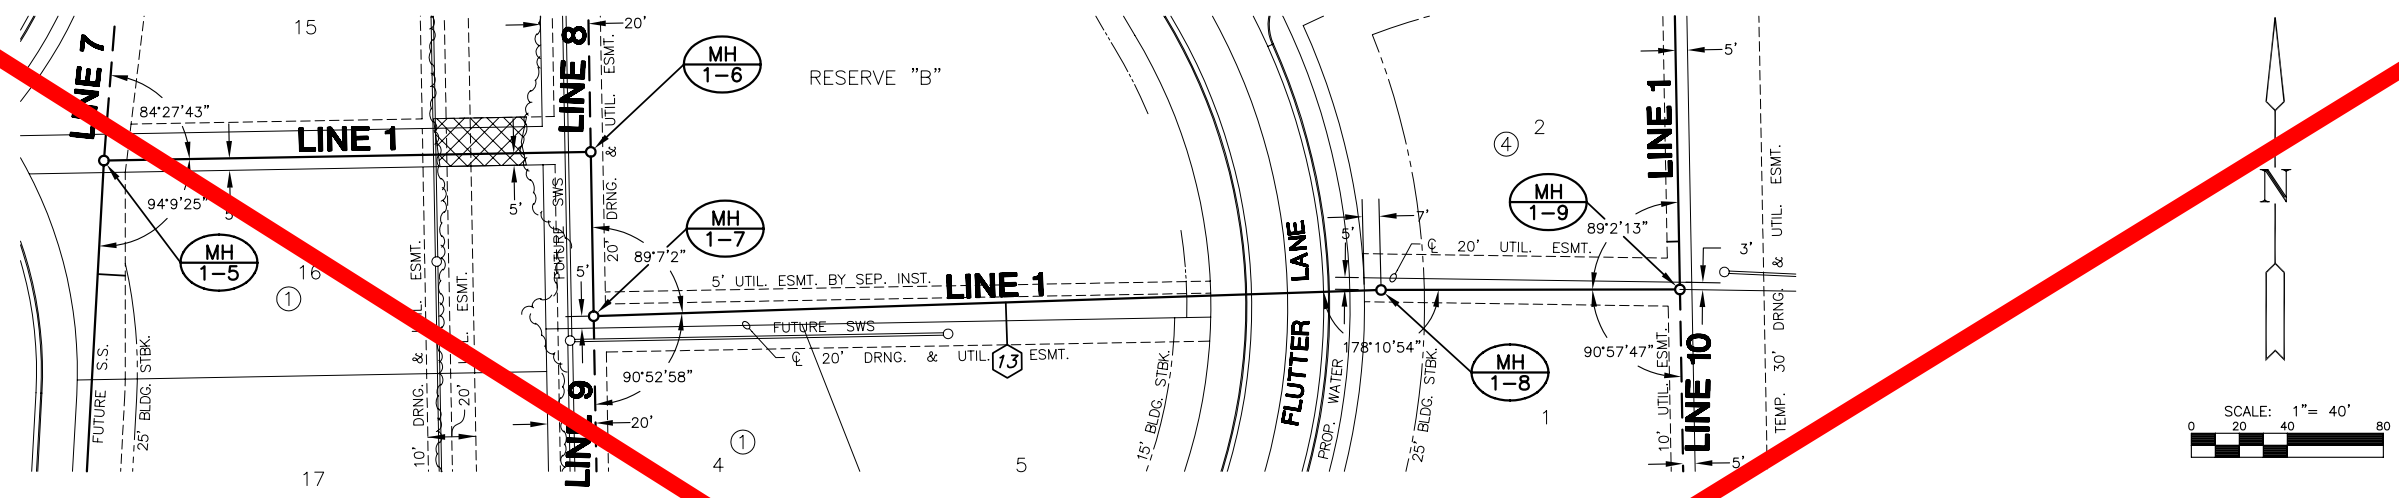

= TREE REMOVAL  
(SEE NOTE 12, SHEET 1)  
**PLAN LINE 1**

**NOTE:**  
ANY TREE REMOVAL OUTSIDE  
OF UTILITY EASEMENT TO BE  
APPROVED BY DEVELOPER.

**SANITARY SEWER PLANS FOR  
MONARCH LANDING ADDITION  
PHASE 1**

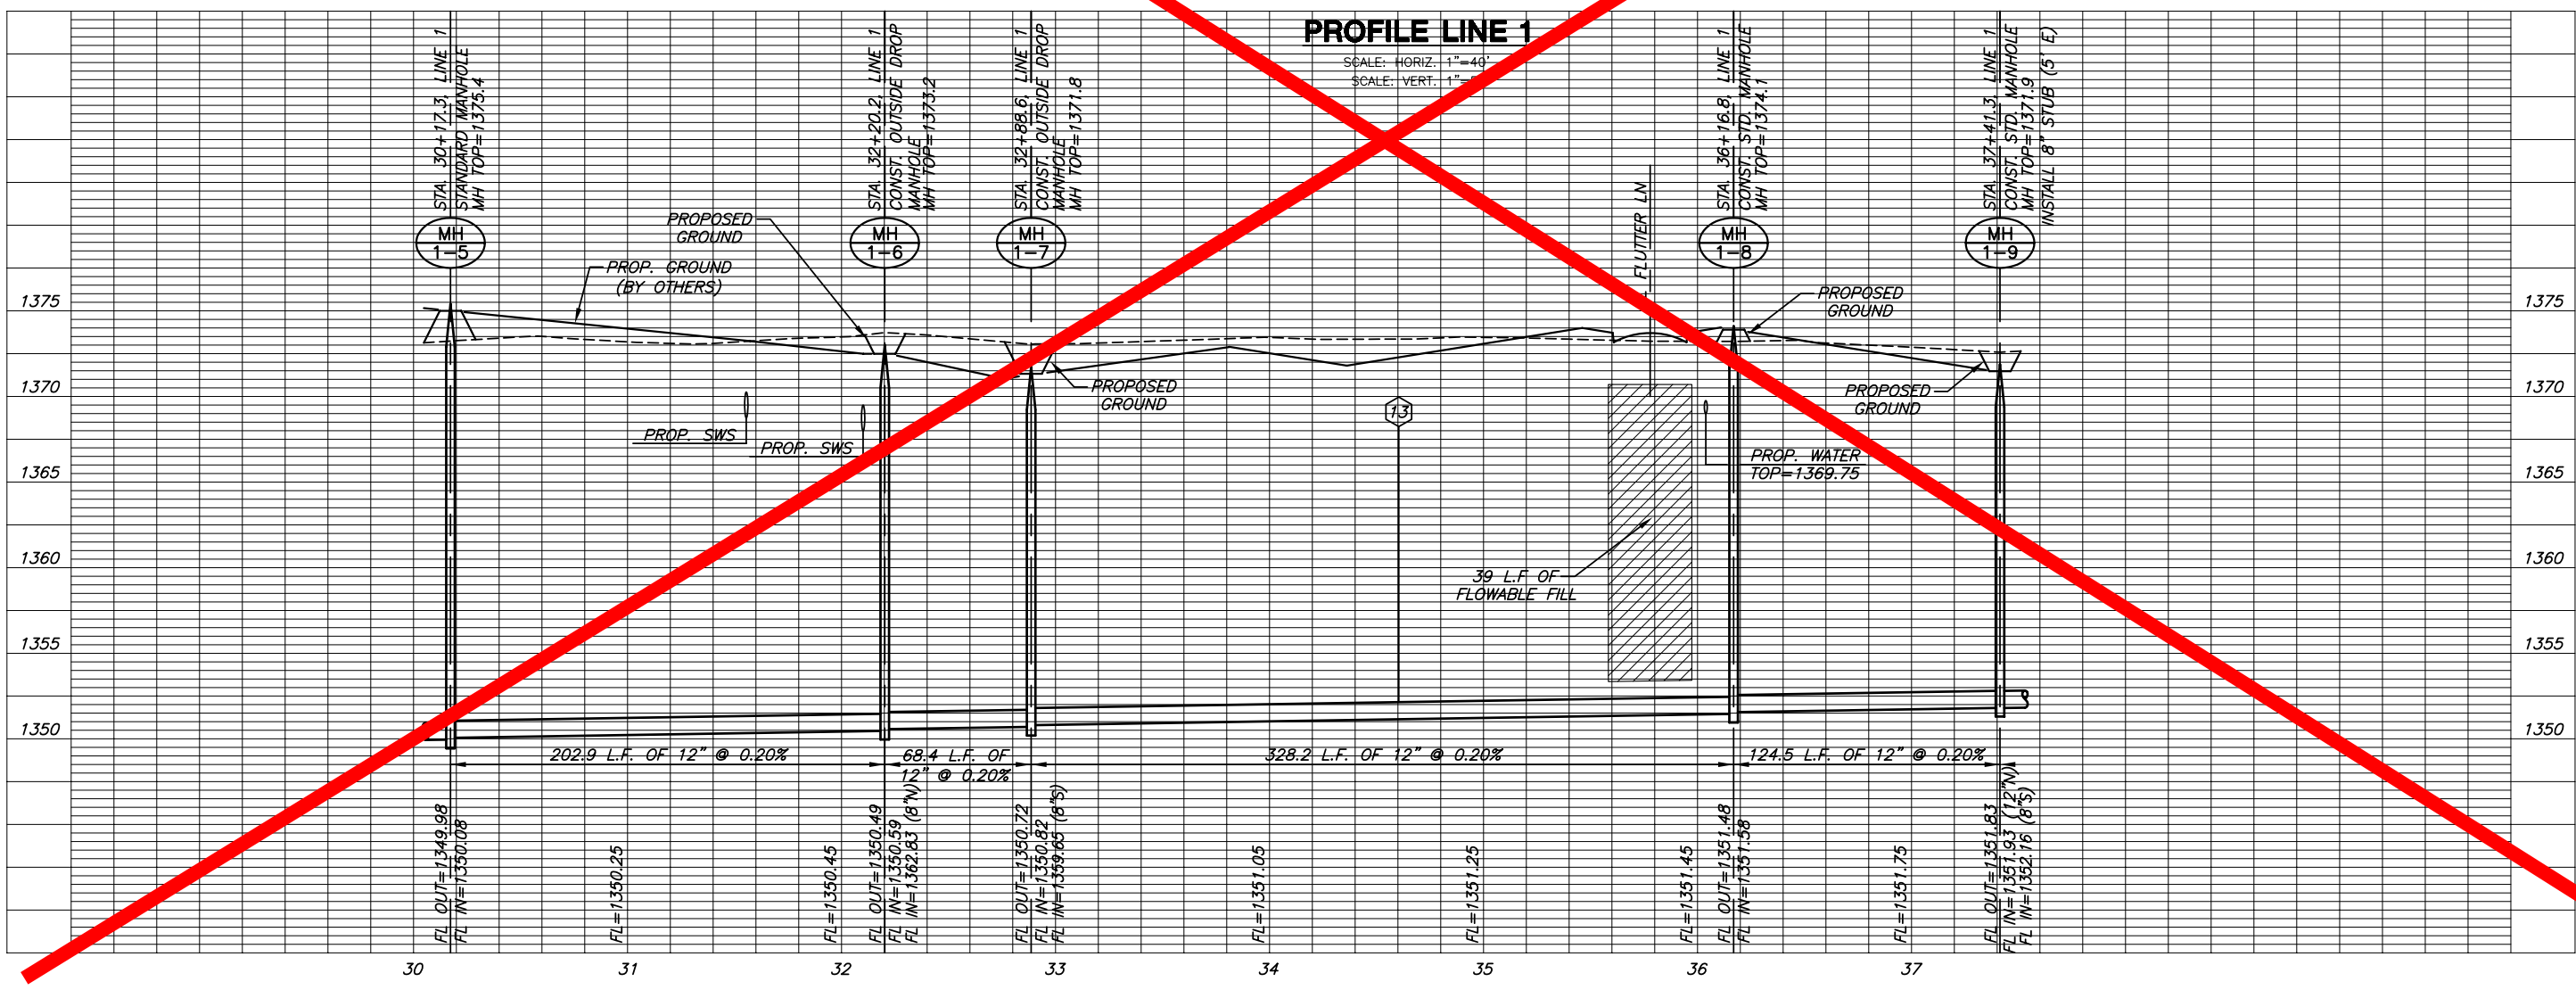

**LINE 1**  
SHEET TITLE  
468-84317  
PROJECT NUMBER

DESIGN BY: DFL  
DRAWN BY: DMU  
CHECKED BY: GJA

ISSUED: January 2007  
REVISED:

of 20