SEE REVISED SHEET

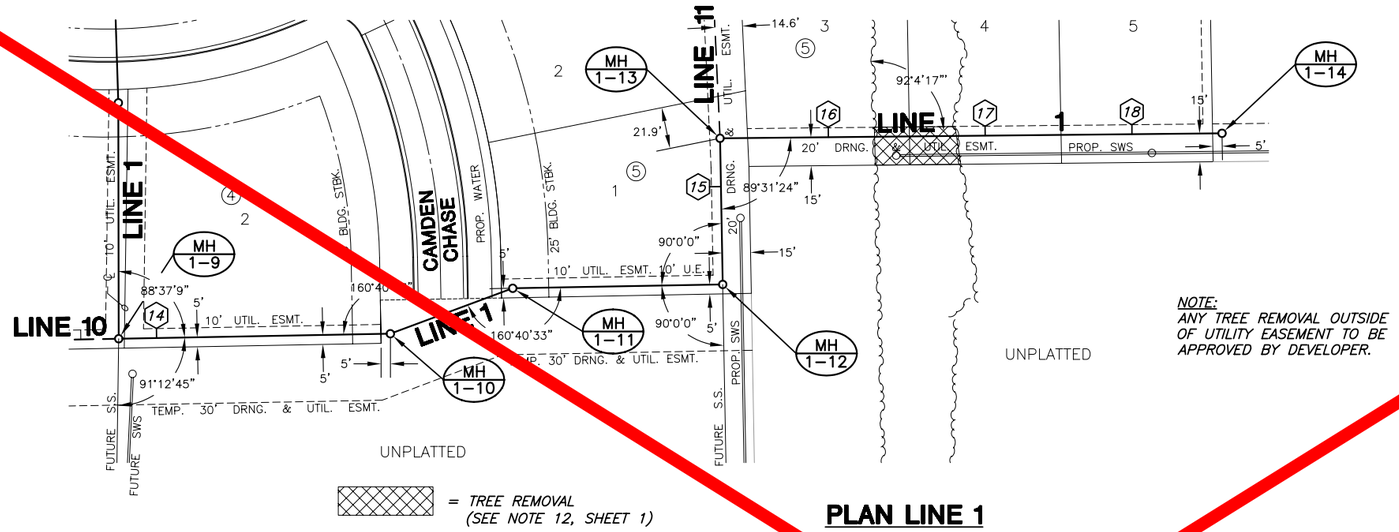

NOTE:
ANY TREE REMOVAL OUTSIDE OF UTILITY EASEMENT TO BE APPROVED BY DEVELOPER.

SCALE: 1"= 40'

PLAN LINE 1

PROFILE LINE 1

SCALE: HORIZ. 1"=40'
SCALE: VERT. 1"=5'

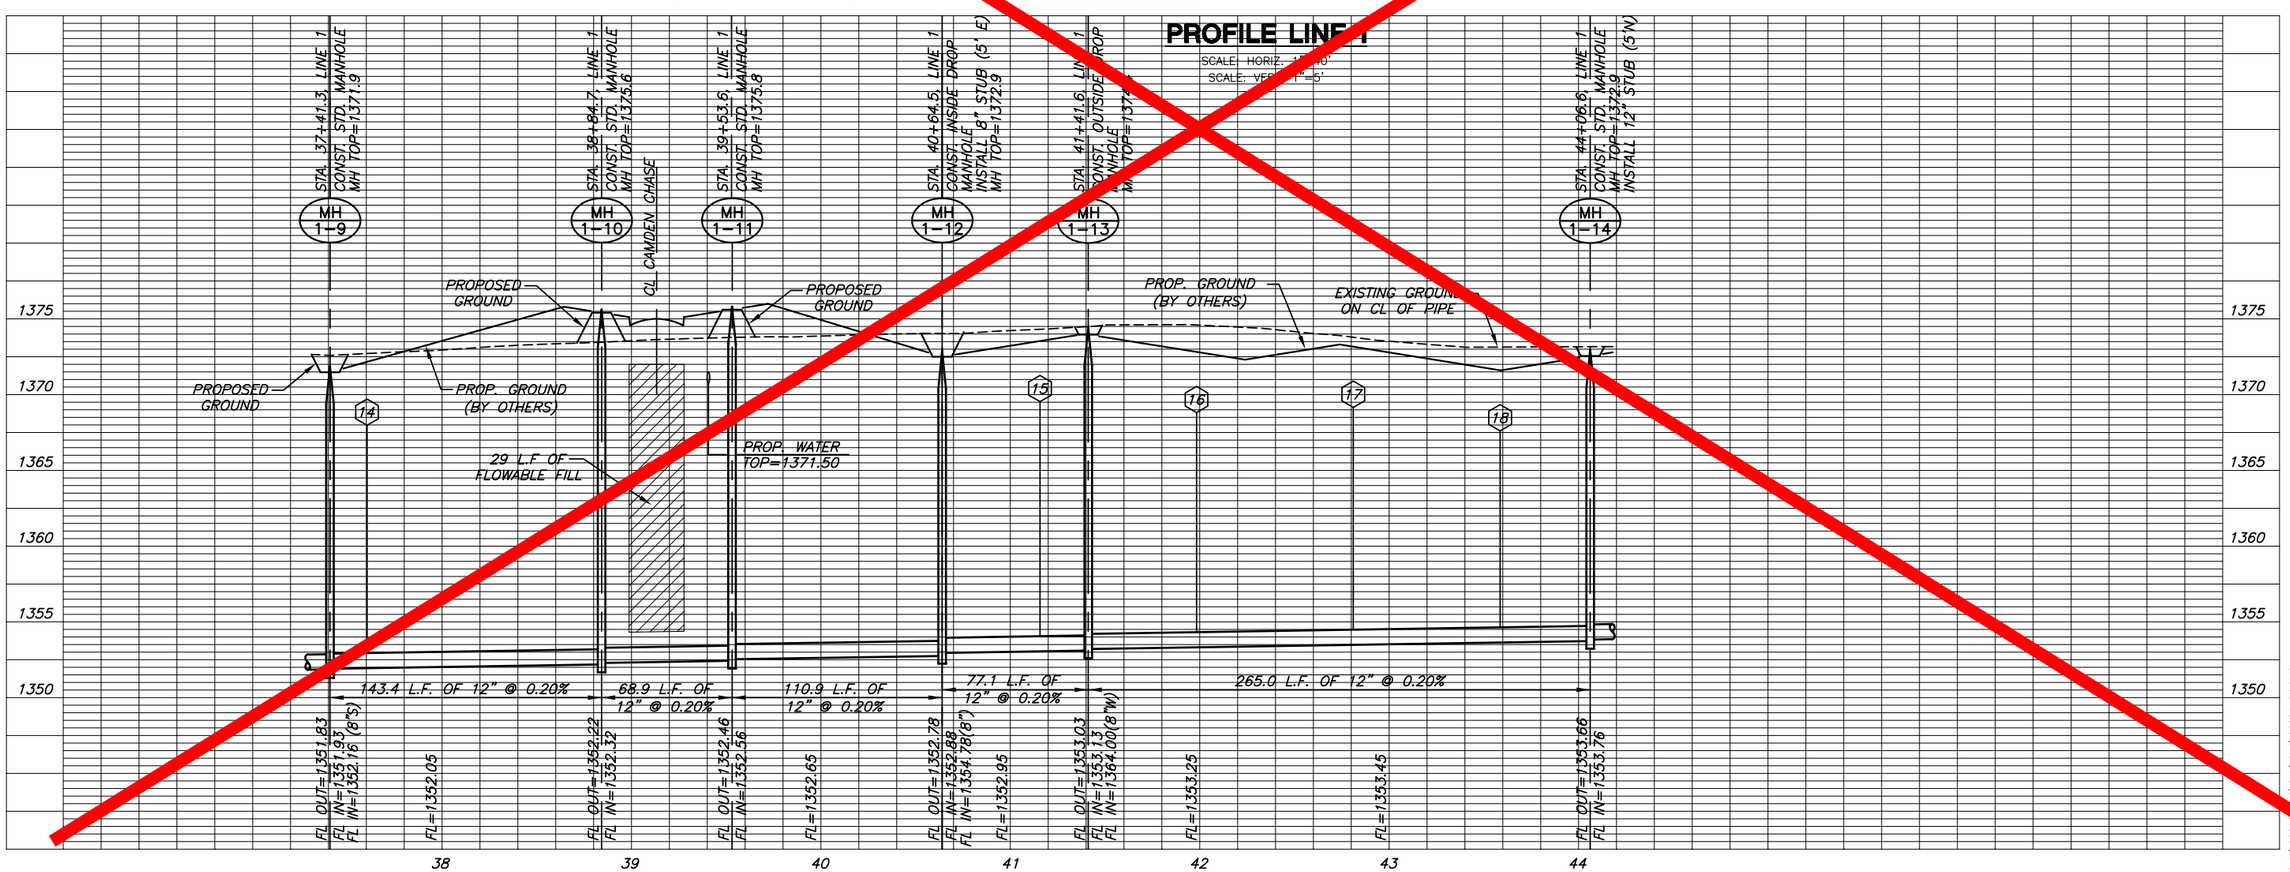

MKEC ENGINEERING CONSULTANTS, INC.
411 N. WEBB ROAD
WICHITA, KS. 67206
316 - 684 - 9600

SANITARY SEWER PLANS FOR

MONARCH LANDING ADDITION

PHASE 1

LINE 1
SHEET TITLE

468-84317
PROJECT NUMBER

DFL
DESIGN BY

DMU
DRAWN BY

GJA
CHECKED BY

ISSUED
January 2007
REVISED

SHEET NO.
7 of 20

J:\CIVIL\06201\DWG\SAN\PH1\06201_B4.DWG

PLOTTED: Wednesday, January 31, 2007 @ 07:12AM