


# SEE REVISED SHEET


NOTE:  
ANY TREE REMOVAL OUTSIDE  
OF UTILITY EASEMENT TO BE  
APPROVED BY DEVELOPER.

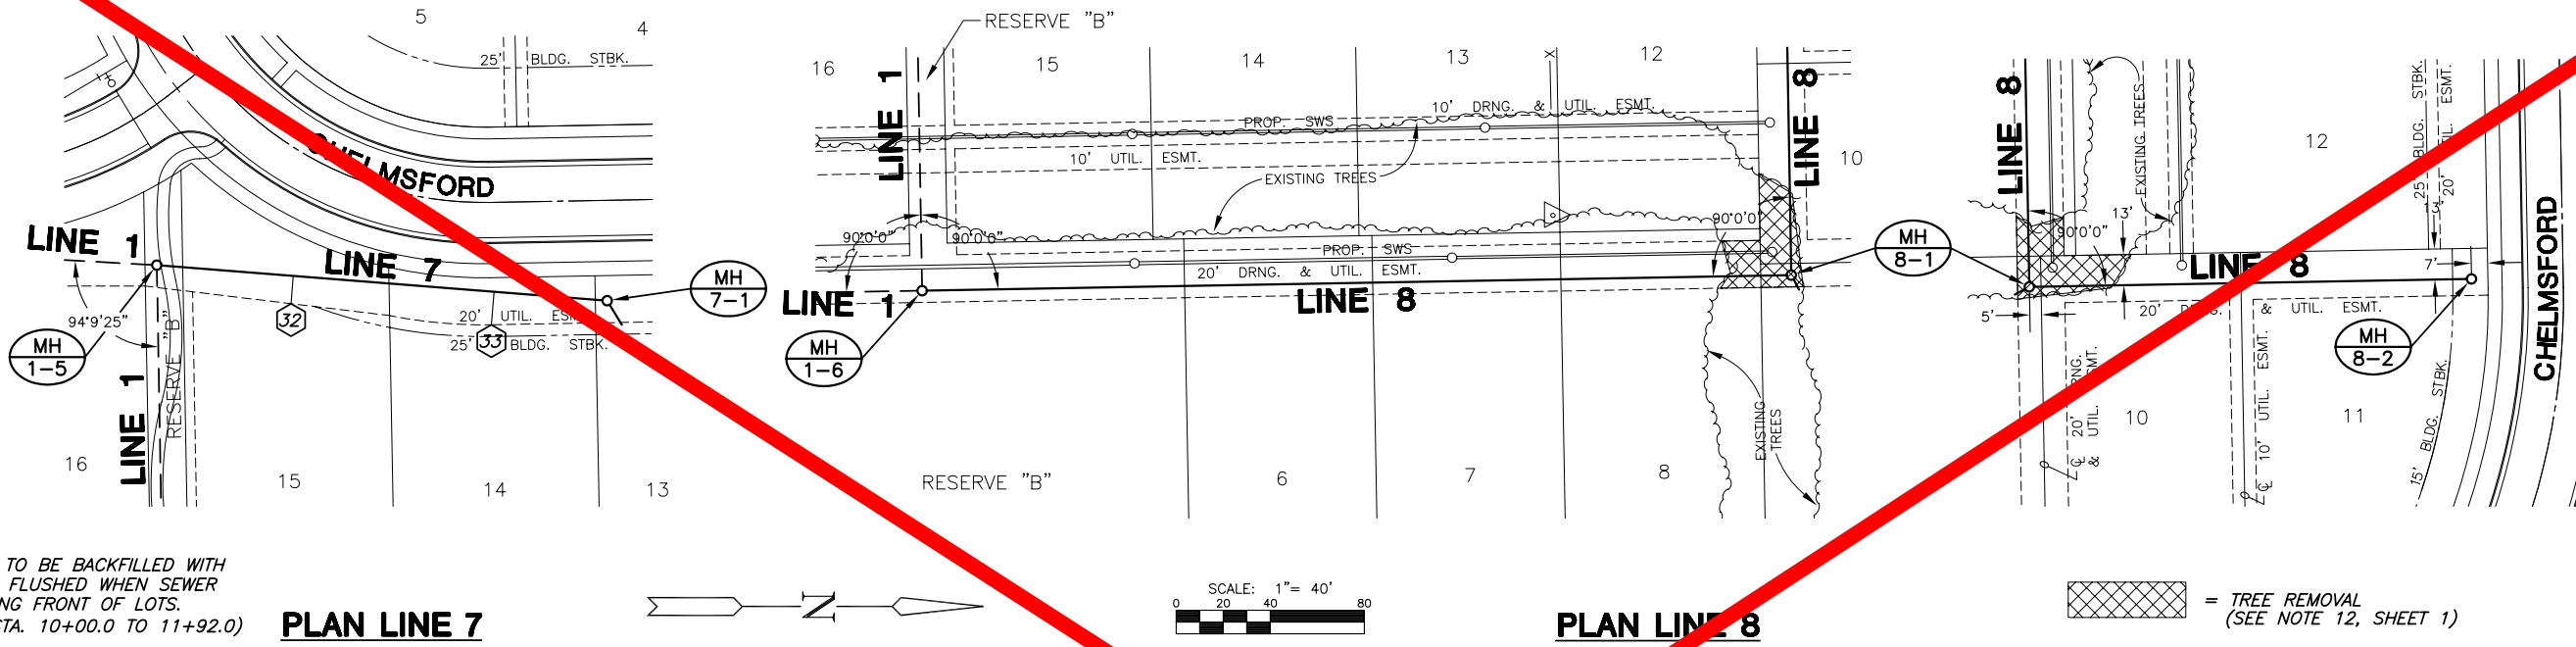


NOTE:  
TRENCHES TO BE BACKFILLED WITH  
SAND AND FLUSHED WHEN SEWER  
RUNS ALONG FRONT OF LOTS.  
(LINE 7, STA. 10+00.0 TO 11+92.0)

**PLAN LINE 7**

**PLAN LINE 8**

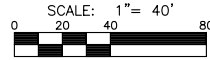

= TREE REMOVAL  
(SEE NOTE 12, SHEET 1)

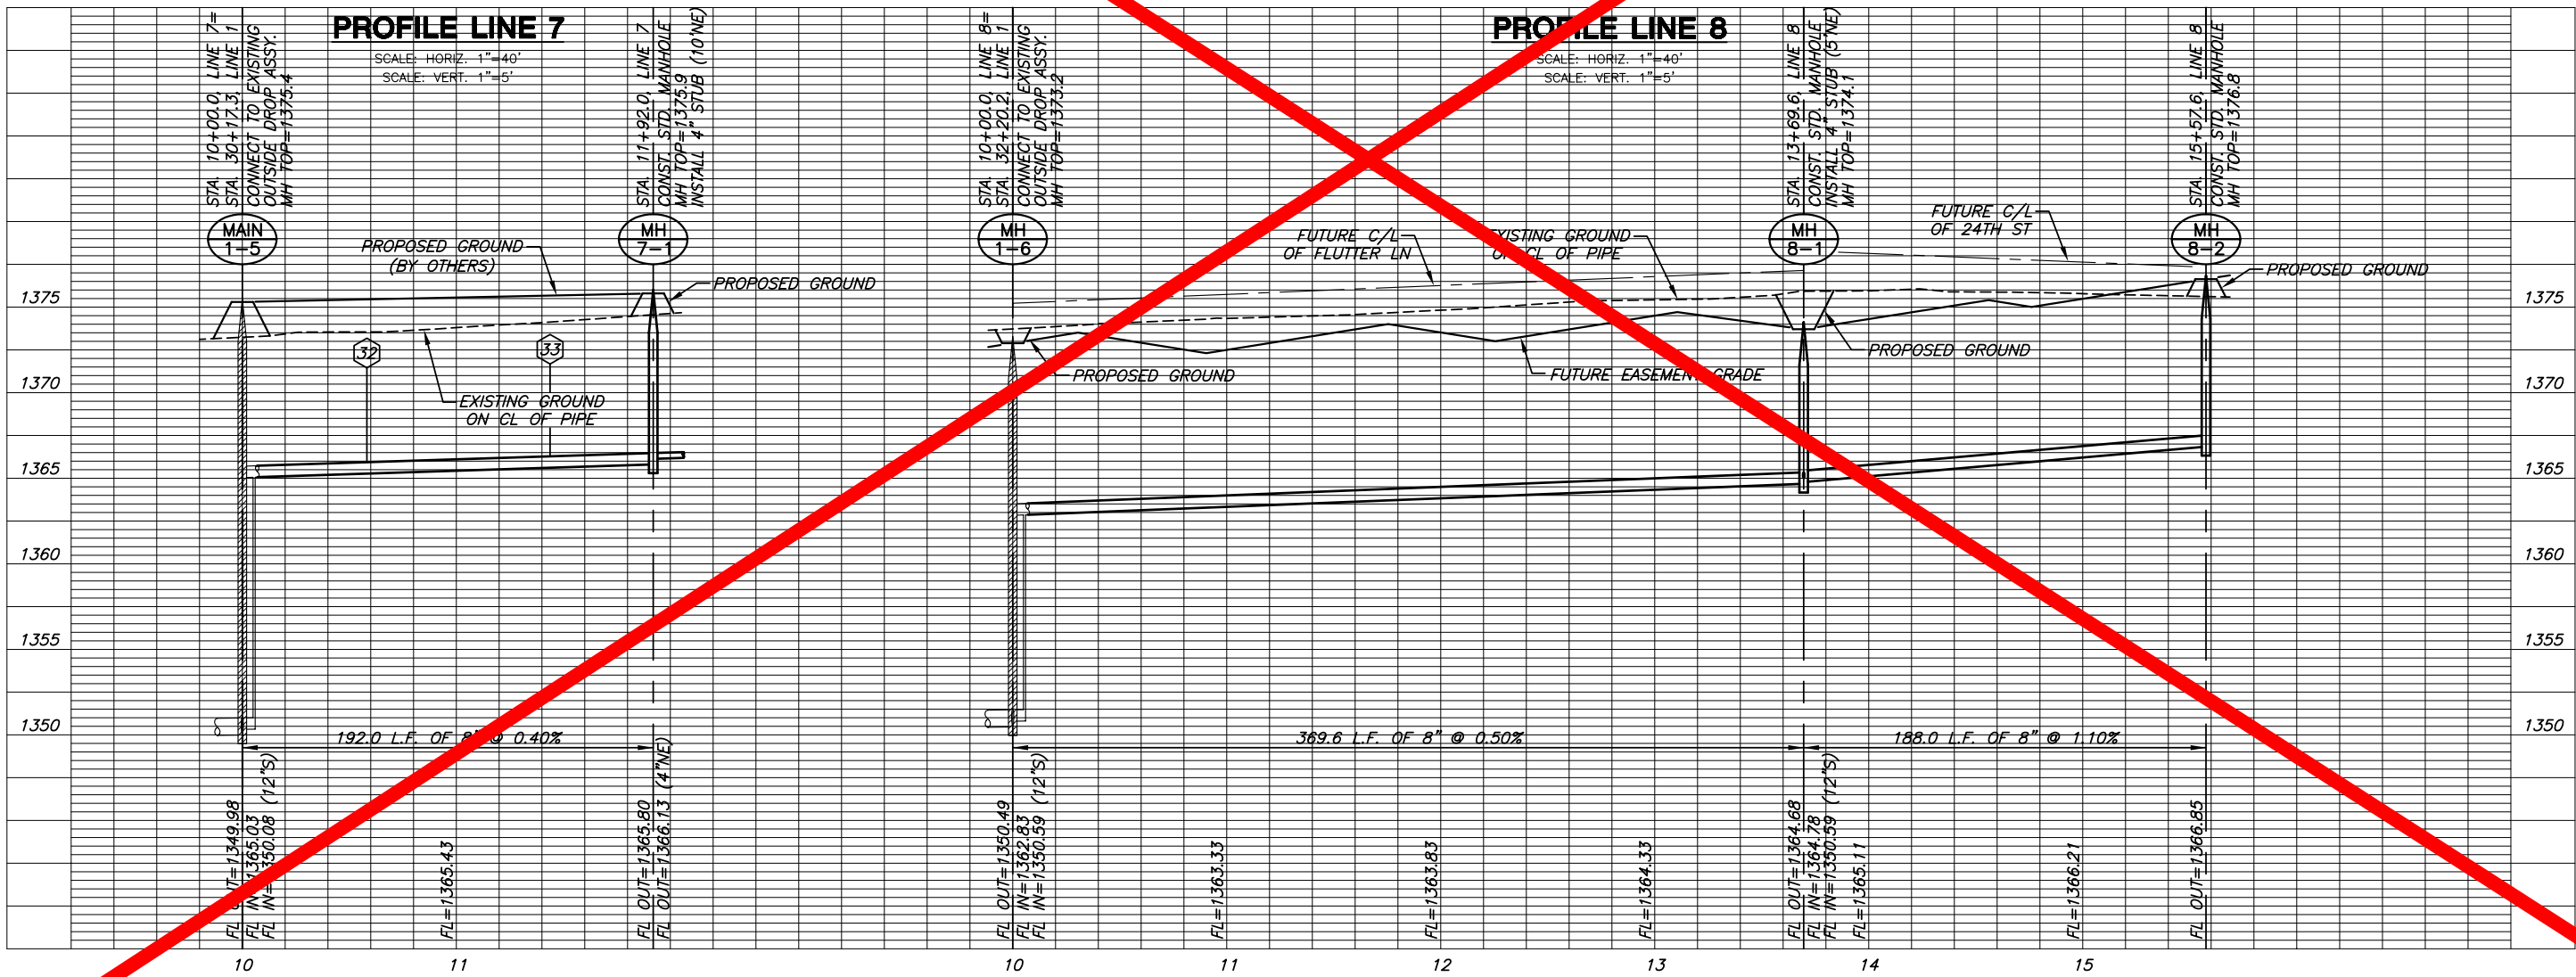

**PROFILE LINE 7**

**PROFILE LINE 8**

**SANITARY SEWER PLANS FOR  
MONARCH LANDING ADDITION  
PHASE 1**

**LINES 7 & 8**  
SHEET TITLE  
468-84317  
PROJECT NUMBER

DESIGN BY: **DFL**  
DRAWN BY: **DMU**  
CHECKED BY: **GJA**

ISSUED: **January 2007**

SHEET NO.  
**11 of 20**