


UNPLATTED

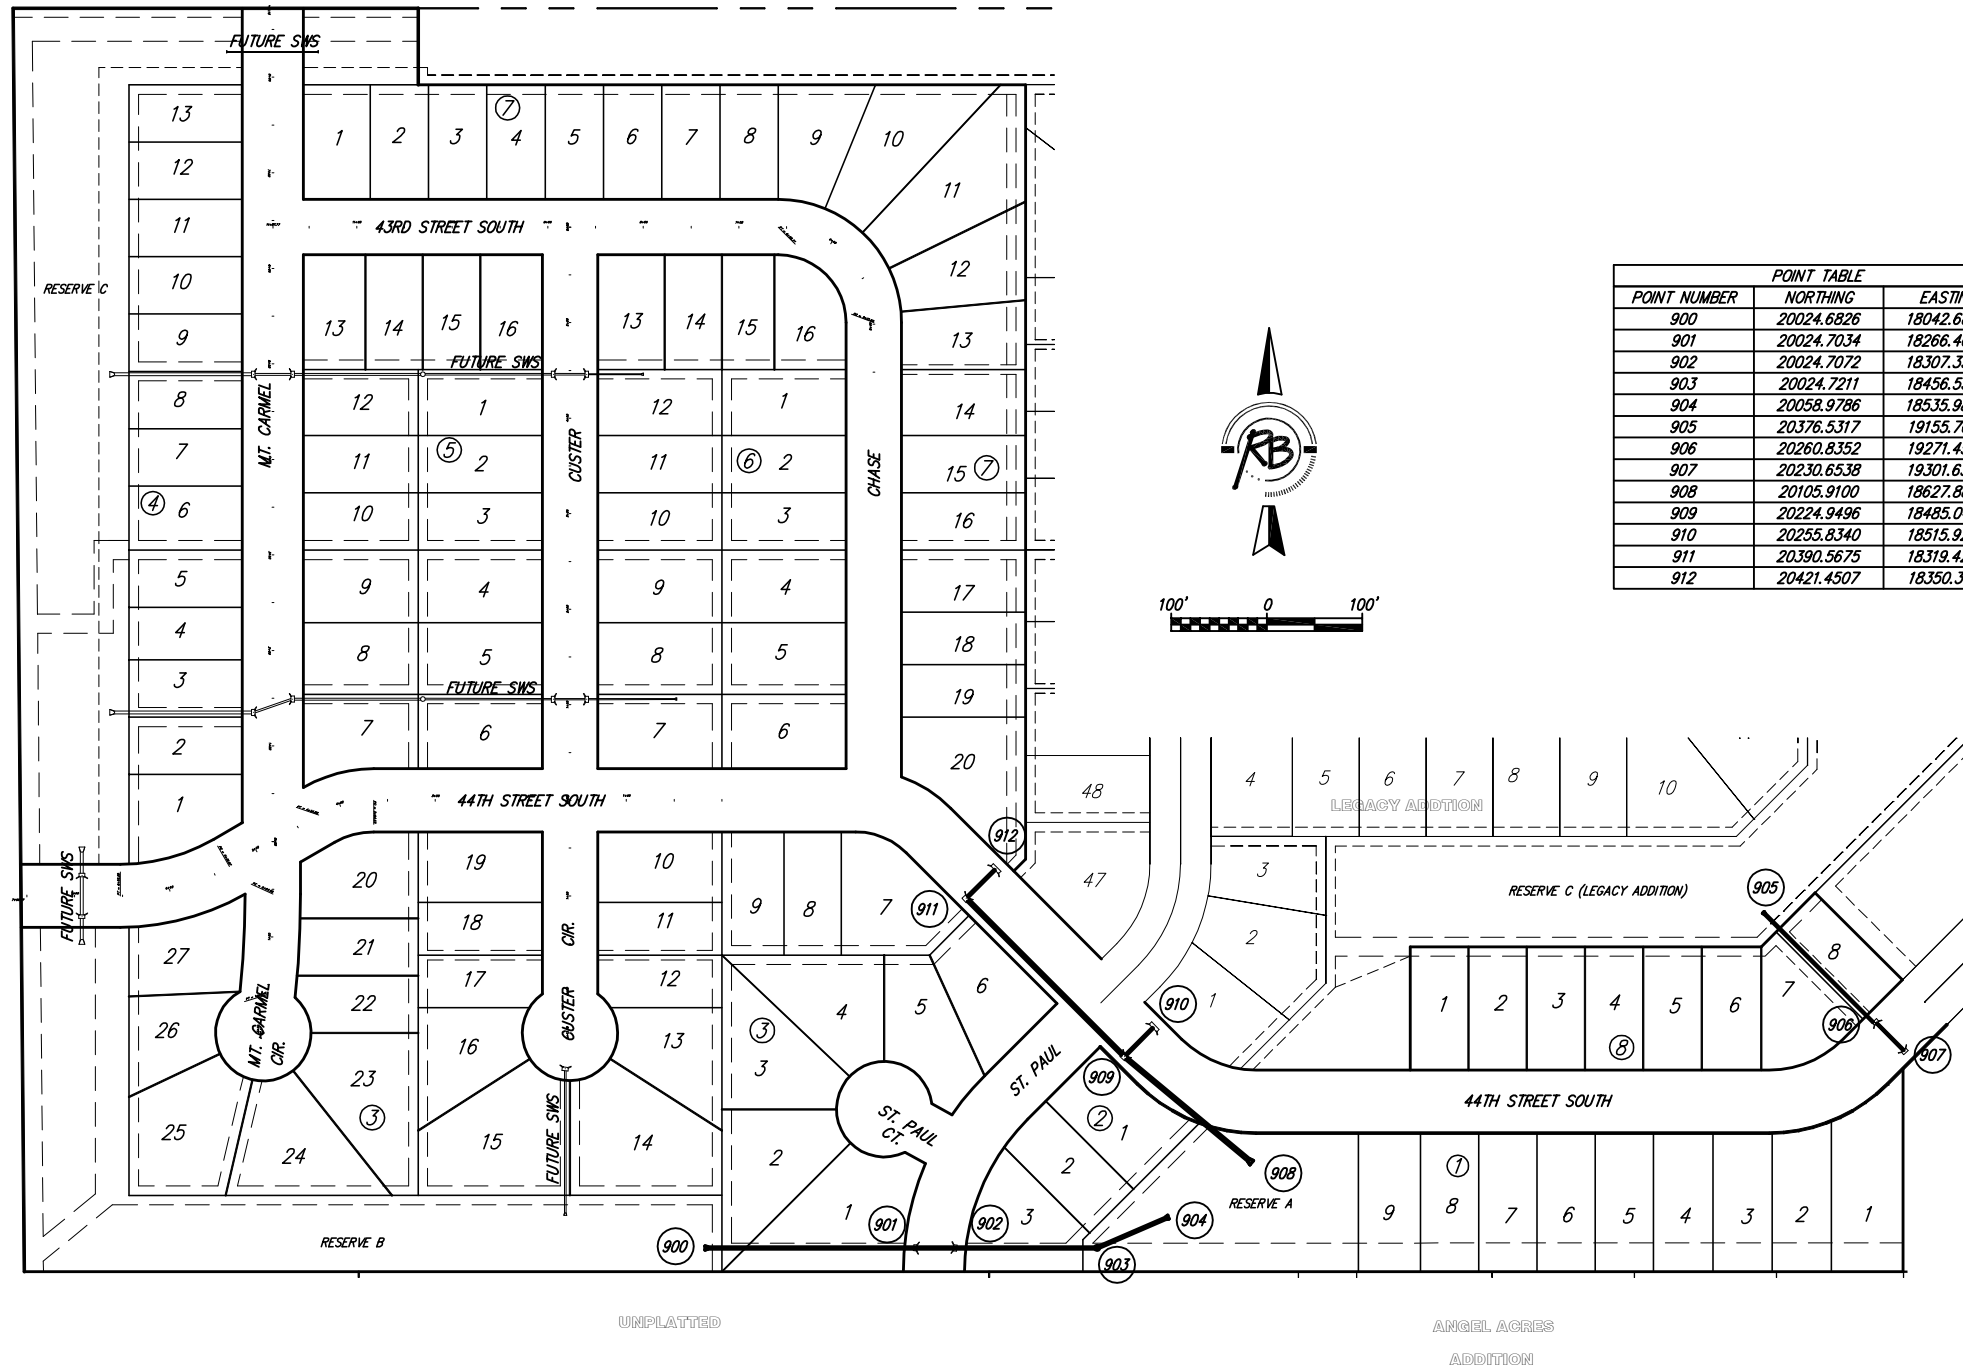


POINT TABLE			
POINT NUMBER	NORTHING	EASTING	DESCRIPTION
900	20024.6826	18042.6806	END SECTION
901	20024.7034	18266.4658	INLET
902	20024.7072	18307.3395	INLET
903	20024.7211	18456.5390	MANHOLE
904	20058.9786	18535.9887	END SECTION
905	20376.5317	19155.7610	END SECTION
906	20260.8352	19271.4574	INLET
907	20230.6538	19301.6388	INLET
908	20105.9100	18627.8880	END SECTION
909	20224.9496	18485.0454	INLET
910	20255.8340	18515.9282	INLET
911	20390.5675	18319.4255	INLET
912	20421.4507	18350.3116	INLET

COTTONWOOD GROVE  
3RD ADDITION

JAMES PLACE  
ADDITION

ANGEL ACRES  
ADDITION

Legacy 3rd Addition  
Storm Drain Bubble Map  
WICHITA, KANSAS

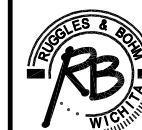

**Ruggles & Bohm, P.A.**  
Engineering, Surveying, Land Planning  
924 North Main  
Wichita, Kansas 67203  
www.rbkansas.com  
(316) 264-8008  
(316) 264-4621 fax  
E-mail: info@rbkansas.com

DRAWING FILE  
SWD {Pond Plans}

PROJECT NUMBER  
472-84525

DESIGN	KWL	SHEET 30 of 43
DRAWN	RLS	
REVIEW		
UTILITY		
DATE	Jan 10, 2006	