


**WATER DISTRIBUTION SYSTEM FOR  
WATERFRONT FOURTH ADDITION**

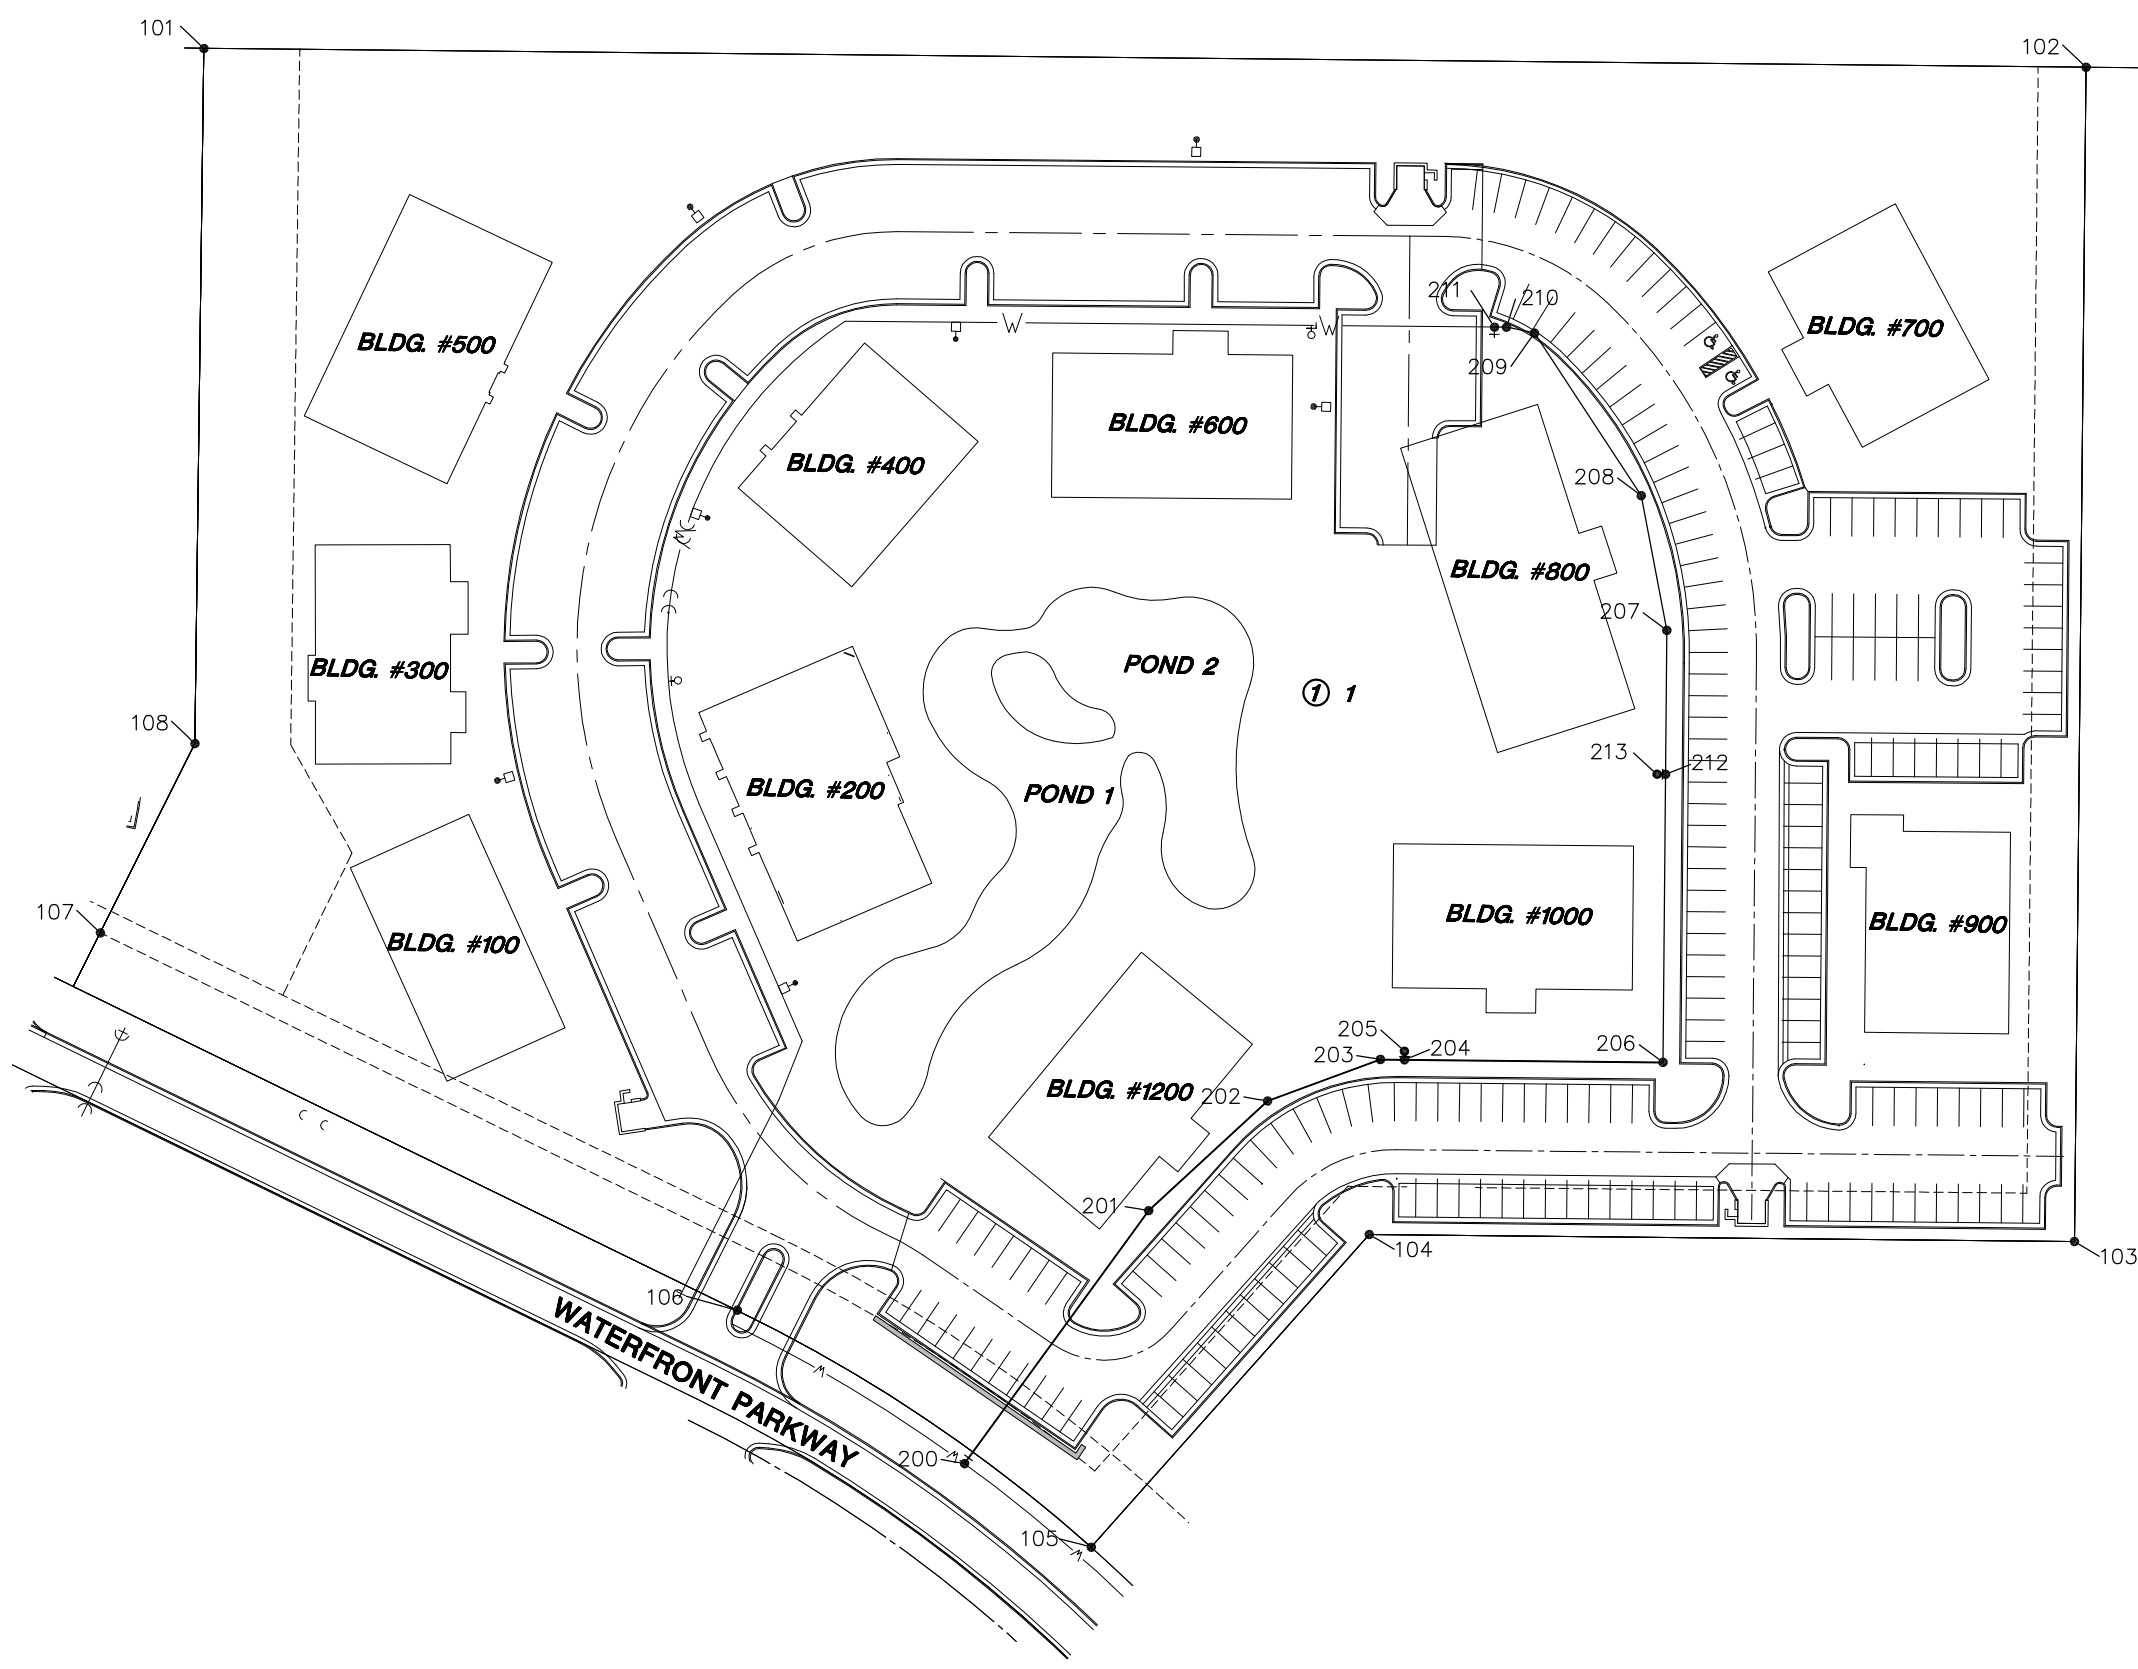

WATER LINE POINTS			
POINT NO.	NORTHING	EASTING	DESCRIPTION
200	1696377.60	1682225.11	TEE
201	1696485.14	1682298.78	BEND
202	1696532.24	1682346.99	BEND
203	1696550.87	1682393.49	BEND
204	1696551.06	1682403.49	TEE
205	1696554.56	1682403.39	HYDRANT
206	1696553.06	1682511.22	BEND
207	1696733.06	1682507.63	BEND
208	1696788.81	1682495.37	BEND
209	1696855.30	1682449.01	BEND
210	1696857.39	1682432.27	BEND
211	1696857.29	1682432.27	BEND
212	1696673.04	1682508.83	TEE
213	1696672.97	1682505.32	HYDRANT

PLAT IRONS			
POINT NO.	NORTHING	EASTING	DESCRIPTION
101	1696957.96	1681891.46	PI
102	1696972.54	1682675.59	PI
103	1696483.28	1682684.69	PI
104	1696477.81	1682390.96	PI
105	1696344.27	1682278.92	PI
106	1696438.39	1682129.37	PI
107	1696565.70	1681848.34	PI
108	1696668.31	1681895.97	PI

**BUBBLE MAP**

SHEET TITLE  
**04026**  
PROJECT NUMBER

DESIGN BY **SRS**  
DRAWN BY **SKF**  
CHECKED BY **DFL**

ISSUED **SEPT. 2007**  
REVISED

SHEET NO.  
**5 of 11**

