
1942
Fairview Ave. – N.L. 17Th St. to S.L. 18Th St.
26' Concrete

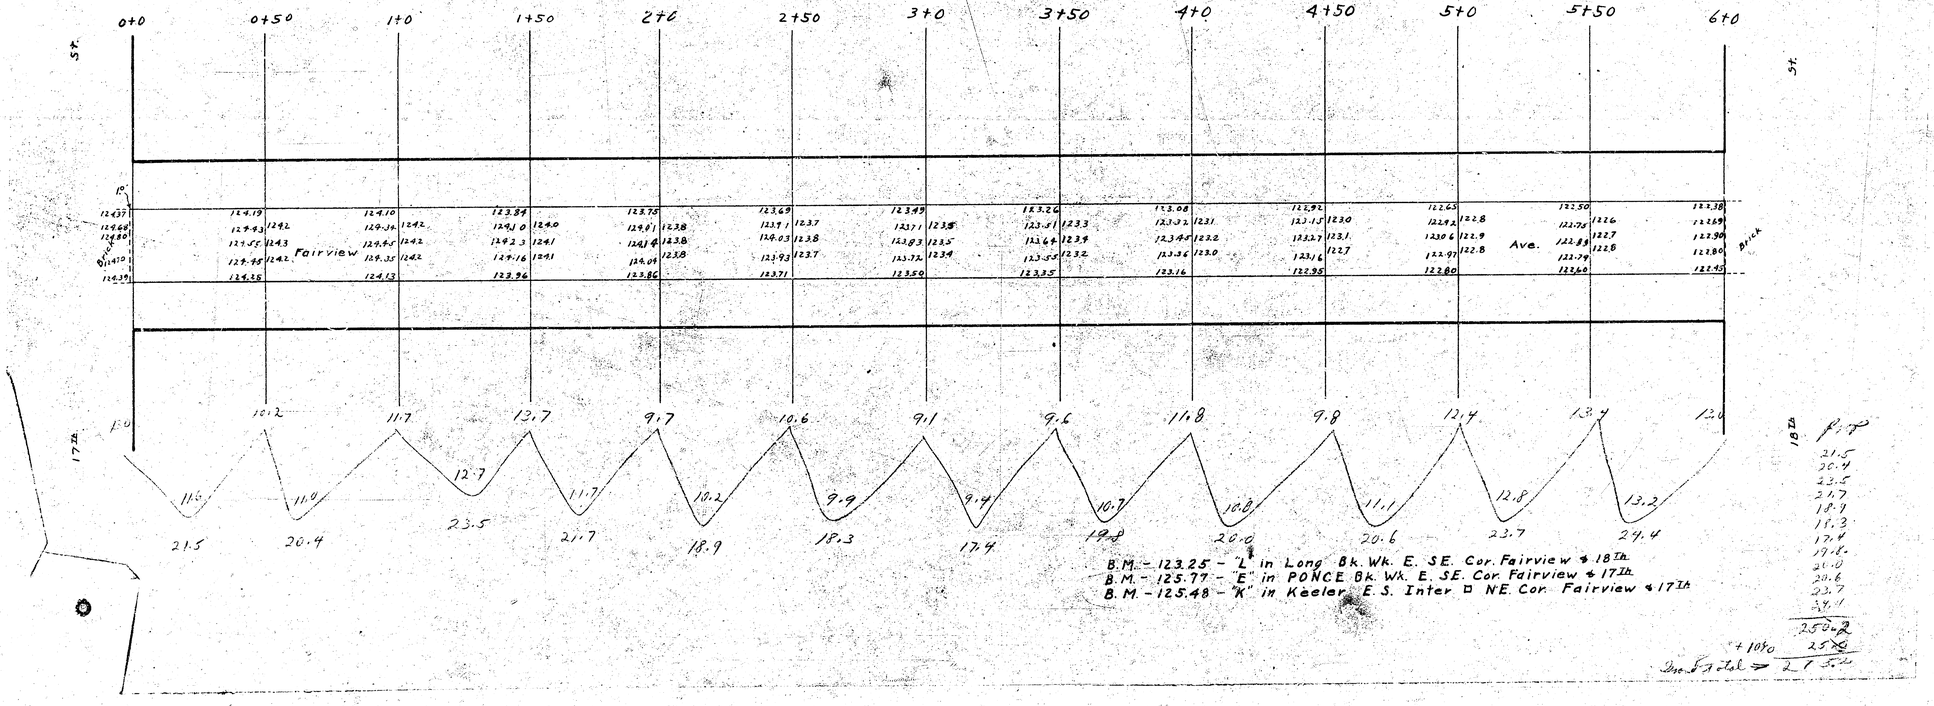

B.M. – 123.25 – "L" in Long Bk. Wk. E. SE. Cor. Fairview & 18Th.
B.M. – 125.77 – "E" in PONCE Bk. Wk. E. SE. Cor. Fairview & 17Th.
B.M. – 125.48 – "K" in Keeler E.S. Inter □ N.E. Cor. Fairview & 17Th.