

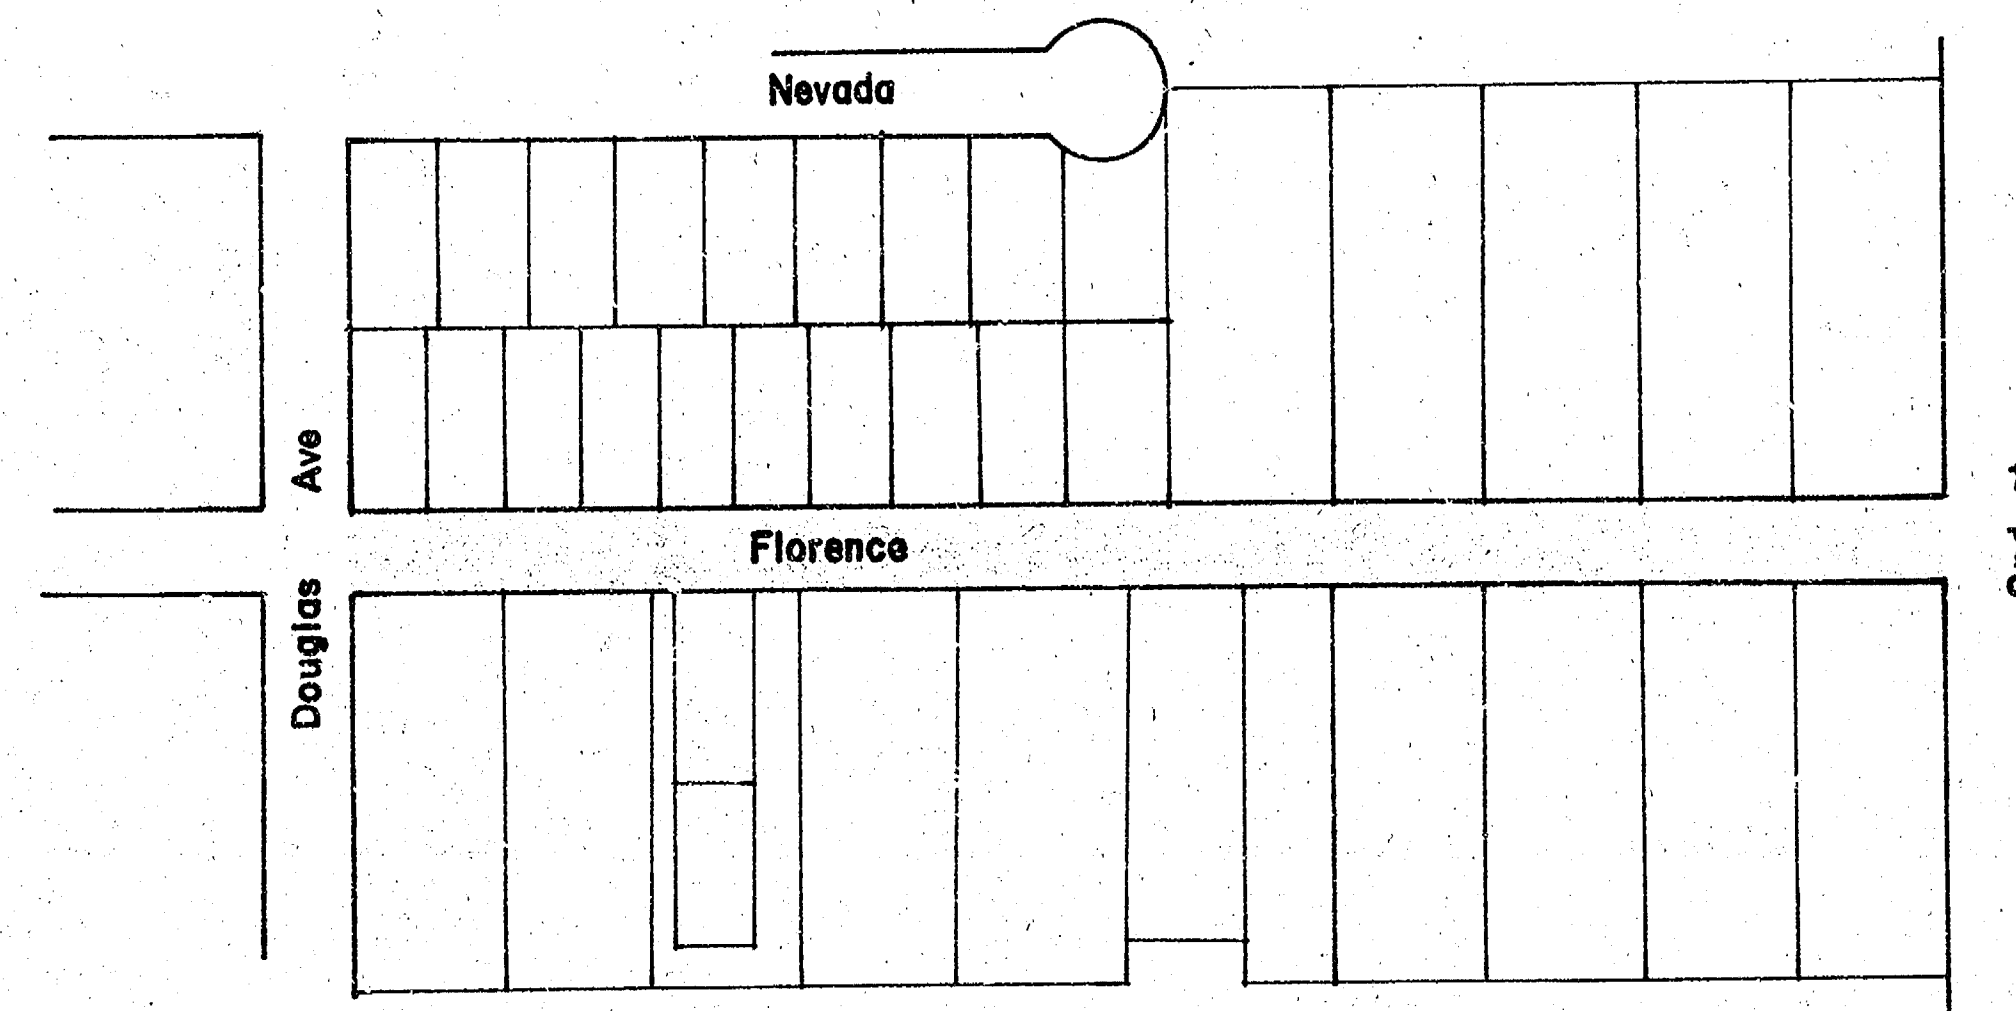



Florence st
from NL Douglas to SL 2nd st

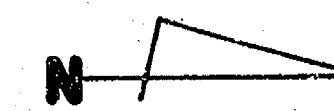



Department of Engineering
City of Wichita, Kansas
R.W. Bruggeman Dir. Engineering / City Engineer
Proj. no. 472-76-245-81115-000-000-001
Date: _____

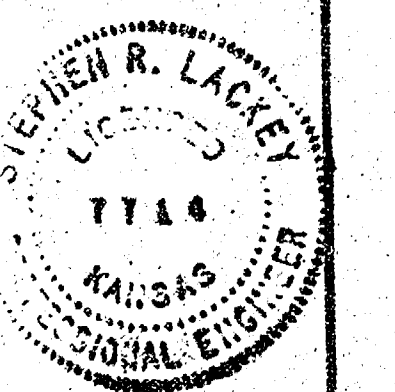

COMBINED CURB & GUTTER

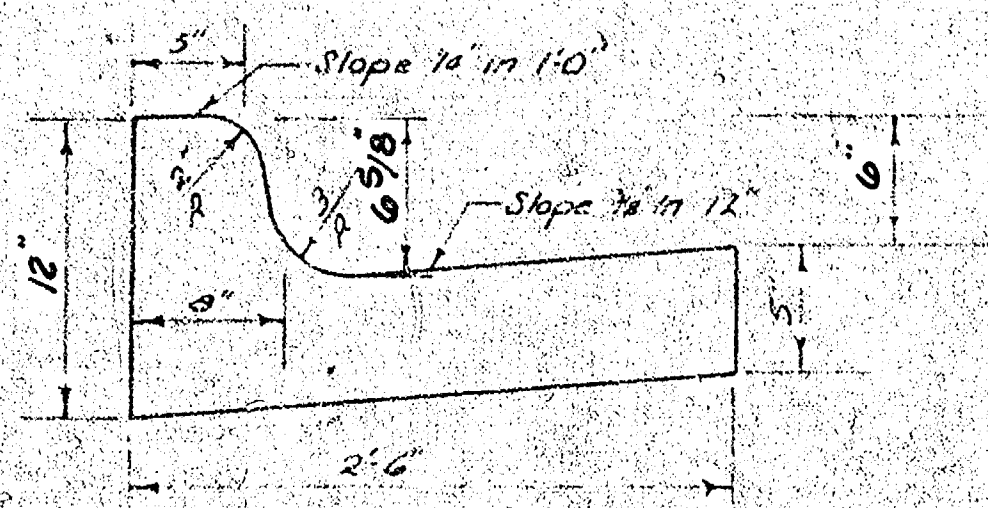

ROLL TYPE CURB & GUTTER

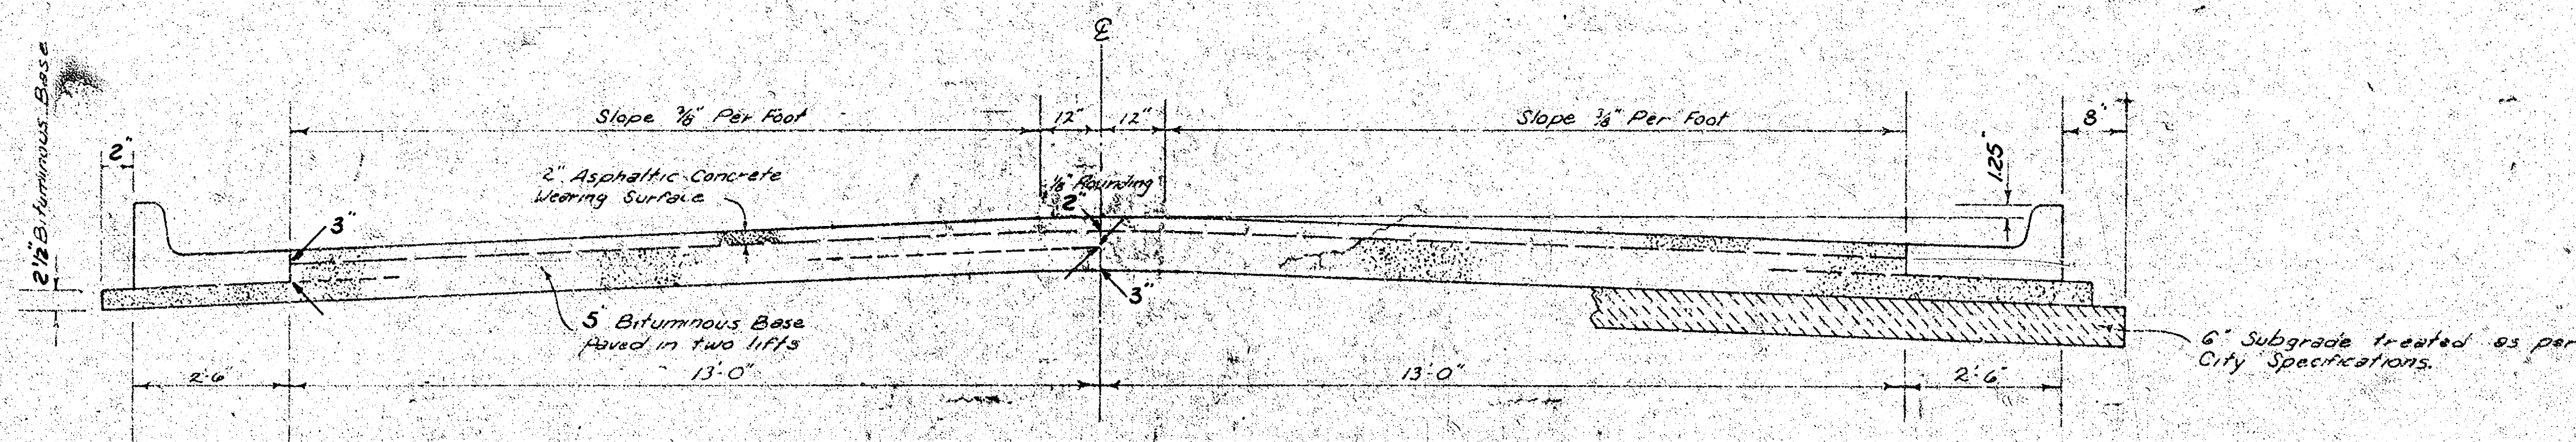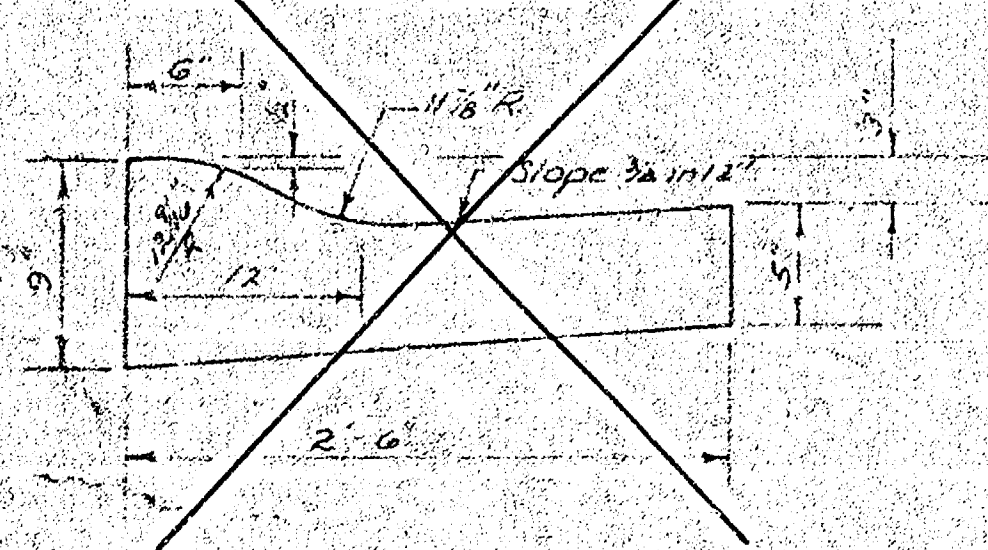


TYPICAL SECTION

31' ASPHALTIC CONCRETE PAVEMENT WITH BITUMINOUS BASE

A TACK COAT OF EMULSIFIED ASPHALT (SS-1H) SHALL BE APPLIED AT AN APPROXIMATE RATE OF 0.05 GALLONS PER SQ. YD. BETWEEN LIFTS OF ASPHALTIC MATERIALS WHEN ORDERED BY THE ENGINEER. TACK COAT WILL NOT BE PAID FOR DIRECTLY AND SHALL BE CONSIDERED AS SUBSIDIARY TO PRICE BID FOR ASPHALTIC PAVEMENT. BITUMINOUS BASE AND ASPHALTIC CONCRETE WEARING SURFACE SHALL BE PLACED WITH A LAYDOWN MACHINE HAVING AUTOMATIC CONTROLS FOR CROWN AND GRADE. CONSTRUCTION JOINTS IN EACH LIFT SHALL BE STAGGERED A MINIMUM DISTANCE OF 1' WITH JOINTS IN PRECEDING LIFTS AND SUCH THAT A JOINT WILL BE CONSTRUCTED ON THE PAVEMENT CENTERLINE IN THE TOP LIFT.

The A.C. pavement between the Comb. Curb & Gutter shall be paid as Sec. 7 A.C. Pavement (5 Bituminous Base). The Bituminous Base under the Comb. Curb & Gutter shall be paid as Sec. 2 1/2 Bituminous Base.

DETAIL OF TRANSVERSE CONSTRUCTION JOINTS

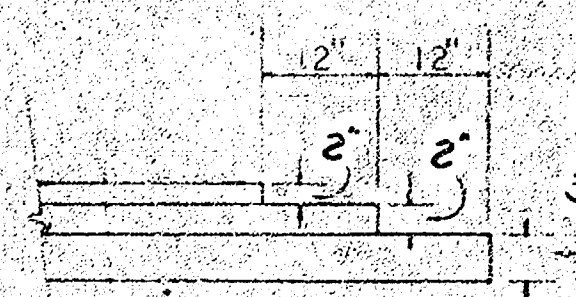

TRANSVERSE CONSTRUCTION JOINTS SHALL BE CONSTRUCTED IN FLEXIBLE BASE PAVEMENTS AT LOCATIONS WHERE PAVEMENT TEMPORARILY ENDS TO FACILITATE FUTURE PAVEMENT CONSTRUCTION AS SHOWN BY DETAIL. THE COST OF CONSTRUCTING THE TRANSVERSE CONSTRUCTION JOINTS SHALL NOT BE MEASURED OR PAID FOR DIRECTLY BUT SHALL BE INCLUDED IN THE BID PRICE FOR SQUARE YARDS OF ASPHALTIC CONCRETE PAVEMENT.

CITY OF WICHITA, KANSAS
DEPARTMENT OF ENGINEERING


2/8

FILMED FROM THE BEST AVAILABLE COPY.....

Florence Ave
NL Douglas to SL Second st
Proj.no. 472-76-245-8115-000-000-001

 $\frac{3}{8}$

FILMED FROM THE BEST
AVAILABLE COPY.....

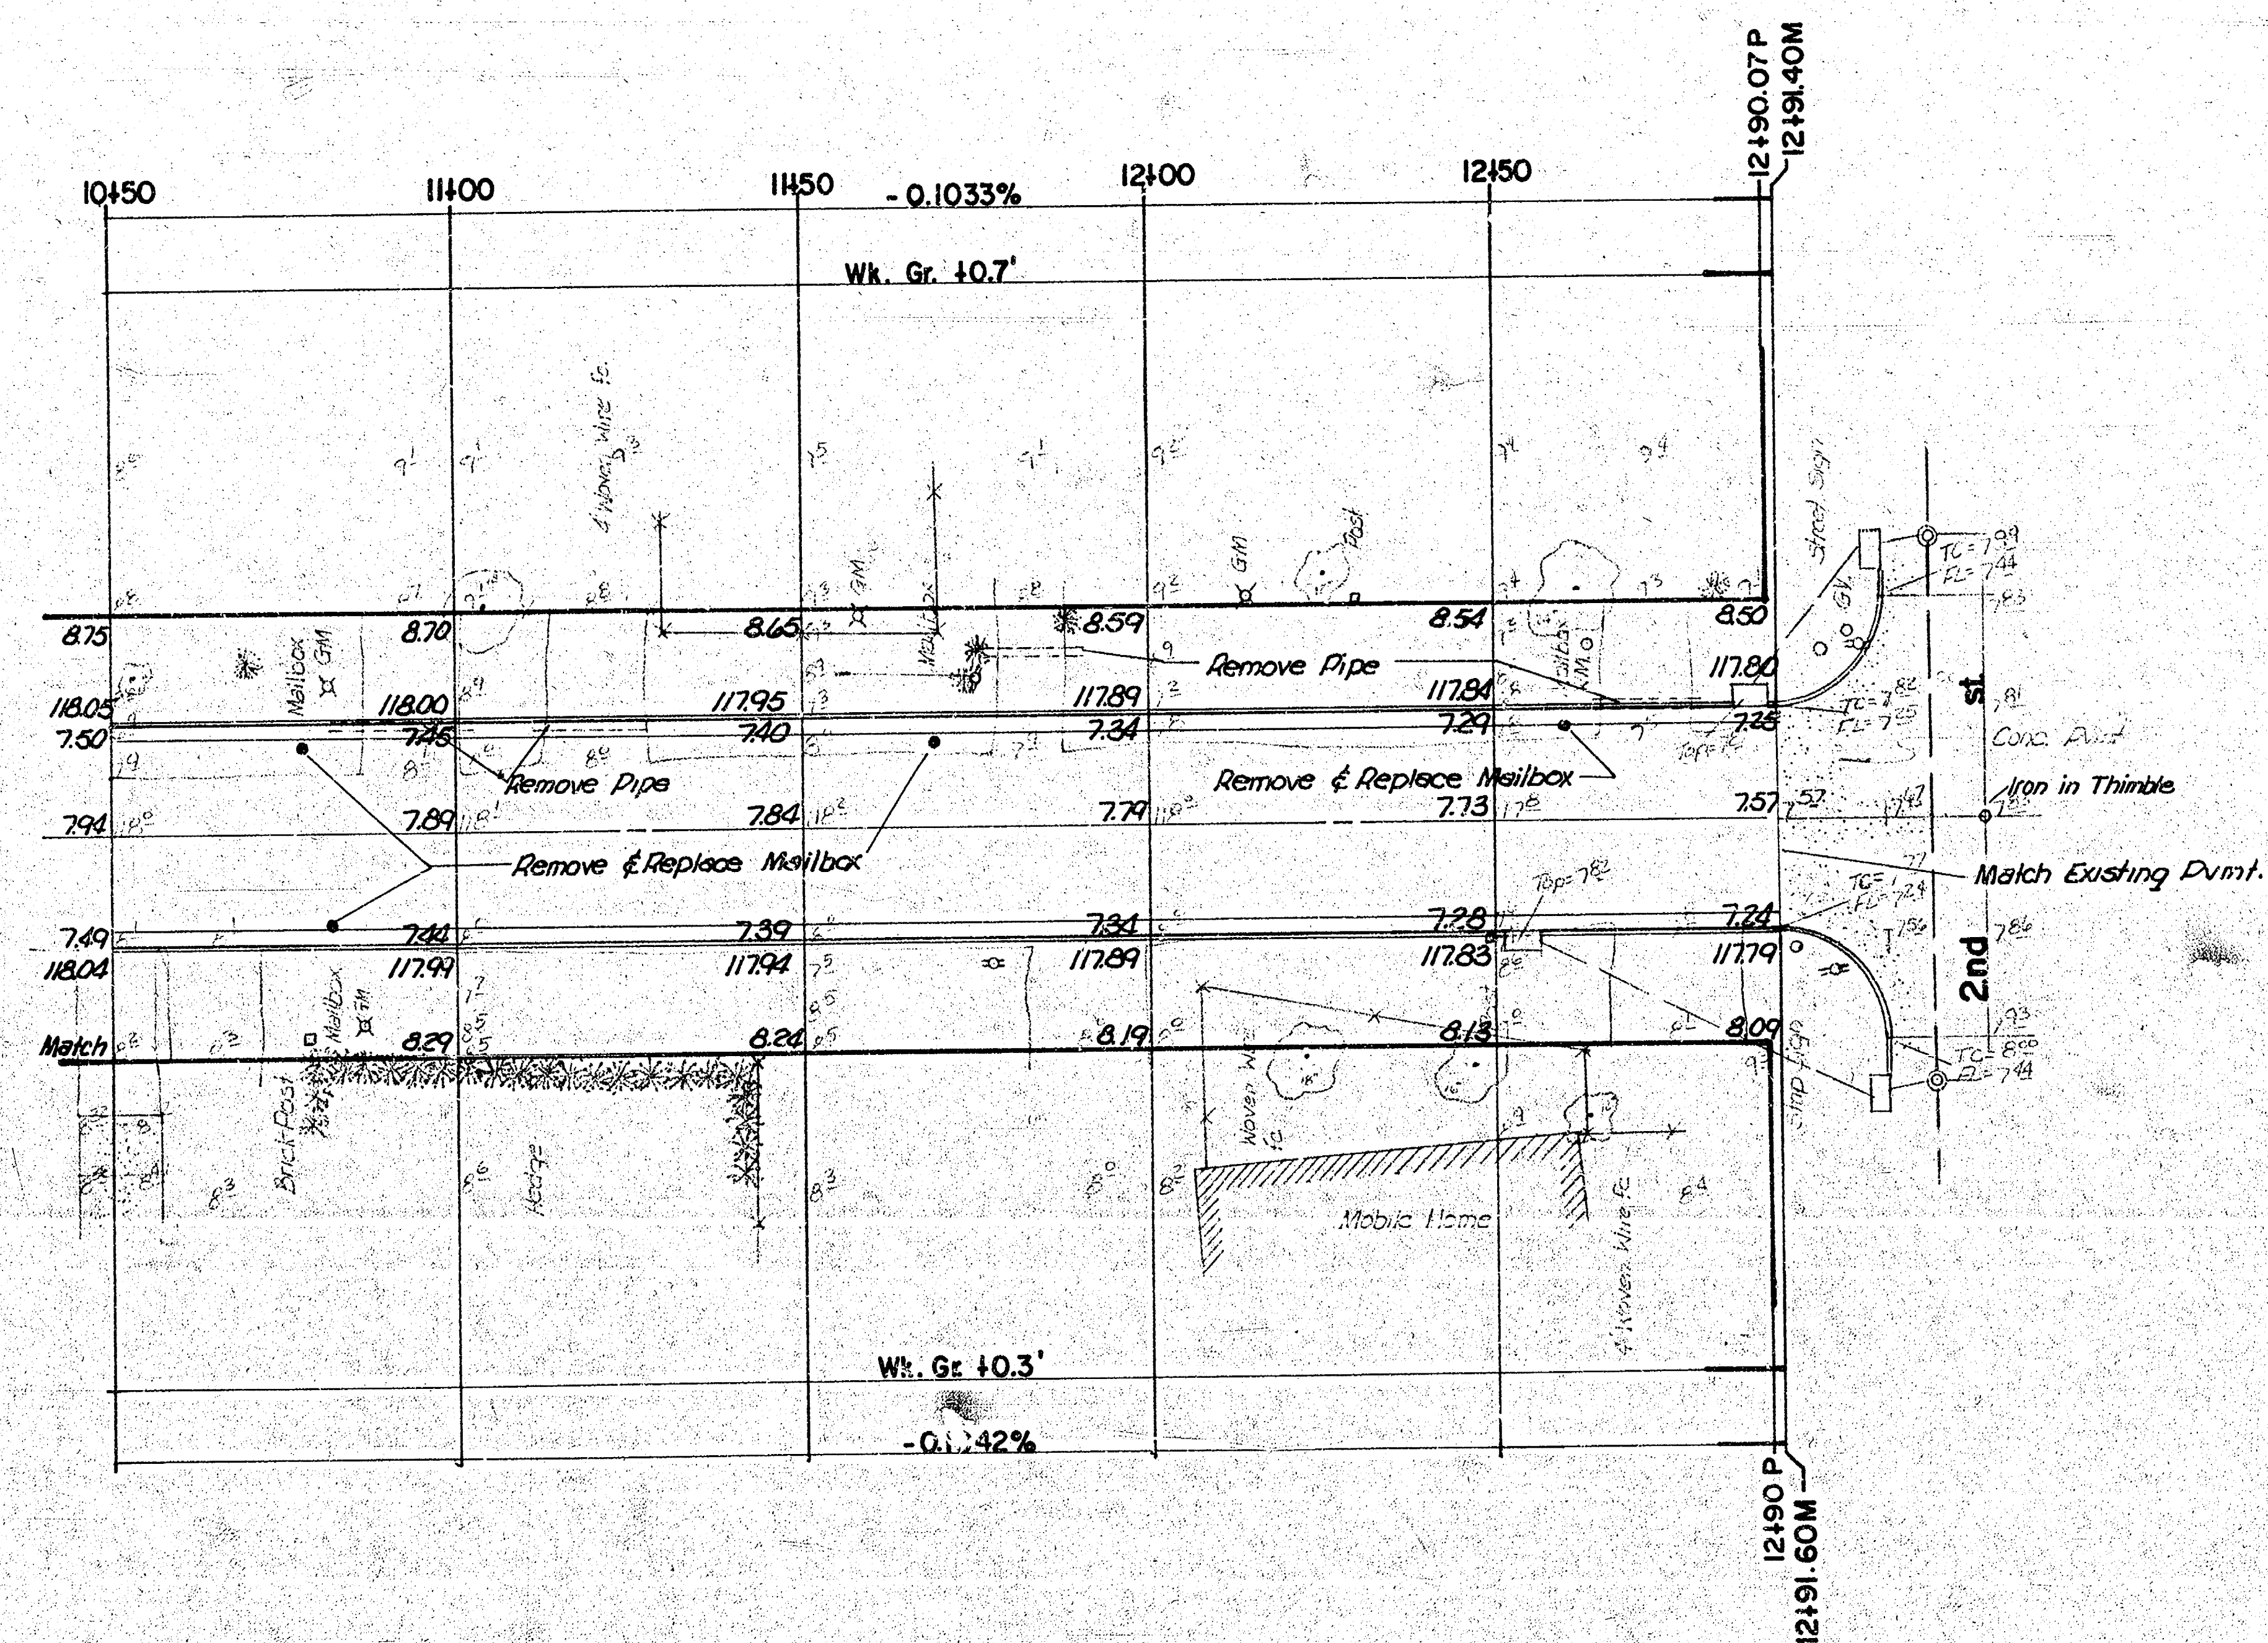

Sheet No. _____

(26-2-30)

Form 192 066

2 066

STREET NAME Florence st FROM NL Douglas TO SL Second CONTRACTOR MID-KANSAS CONST. KIND OF PAVEMENT 7" AC PAVING

FILMED FROM THE BEST
AVAILABLE COPY.....

HOSLUND 8-82 1/11		STATEMENT OF COST				PROJ. NO. 472-74-245-81115-000-000-001		P.E. \$137,423.42	
		FOR CONSTRUCTION OF: FLORENCE ST.-N.L. DOUGLAS AVE. TO S.L. END ST.				WORK DAYS: 0K: 1			
		QUANTITIES		UNIT	CONSTRUCTION	COSTS			
PROP.	CITY	TOTAL	PRICE	ITEM	PROP.	CITY	TOTAL		
		3,440'	14.10'	SQ. YD. 7" ASPH. CONC. PAVMT. (5" BIT. BASE)			• 51,380.40		
		148.0'	5.04'	SQ. YD. 2 1/2" BITUMINOUS BASE			• 3,749.92		
		2523.0'	6.29'	LIN. FT. COMBINED CURB & GUTTER			• 15,869.67		
		965.0'	1.50'	CU. YD. EXCAVATION			• 1,447.50		
		4532.0'	0.28'	SQ. YD. MANIPULATION			• 1,268.96		
		103.0'	30.00'	TONS CEMENT			• 3,090.00		
		8235.0'	2.15'	50 FT. 6" DRIVE			• 21,822.75		
		130.0'	11.23'	SQ. YD. 5" ASPHALT HOOKUP			• 1,459.90		
		21'	23.00'	EA. MAIL BOX REMOVED & REPLACED			• 483.00		
		241.0'	2.50'	LIN. FT. PIPE REMOVED			• 602.50		
		125.0'	0.40'	LIN. FT. FENCE REMOVED			• 50.00		
		2'	97.00'	EA. INLET HOOKUP			• 194.00		
		1'	185.00'	EA. CONCRETE FLUME			• 185.00		
		LUMP SUM	400.00'	CHANGE ORDER #1			• 400.00		
				SUBTOTAL			• 102,023.60		
				ENGINEERING & INSP.			10,137.42		
				ADMINISTRATION			1520.24		
				PUBLICATION			68.16		
				ABSTRACTING			7.00		
				CONSTRUCTION COST			113,756.42		
				TEMP. NOTE INTEREST			8203.43		
				TOTAL COST	121,959.85	-0-	121,959.85		

FILMED FROM THE BEST
AVAILABLE COPY